


GRUNNMYND SÖKKLA - FRÁRENNISLAGNIR

1:50

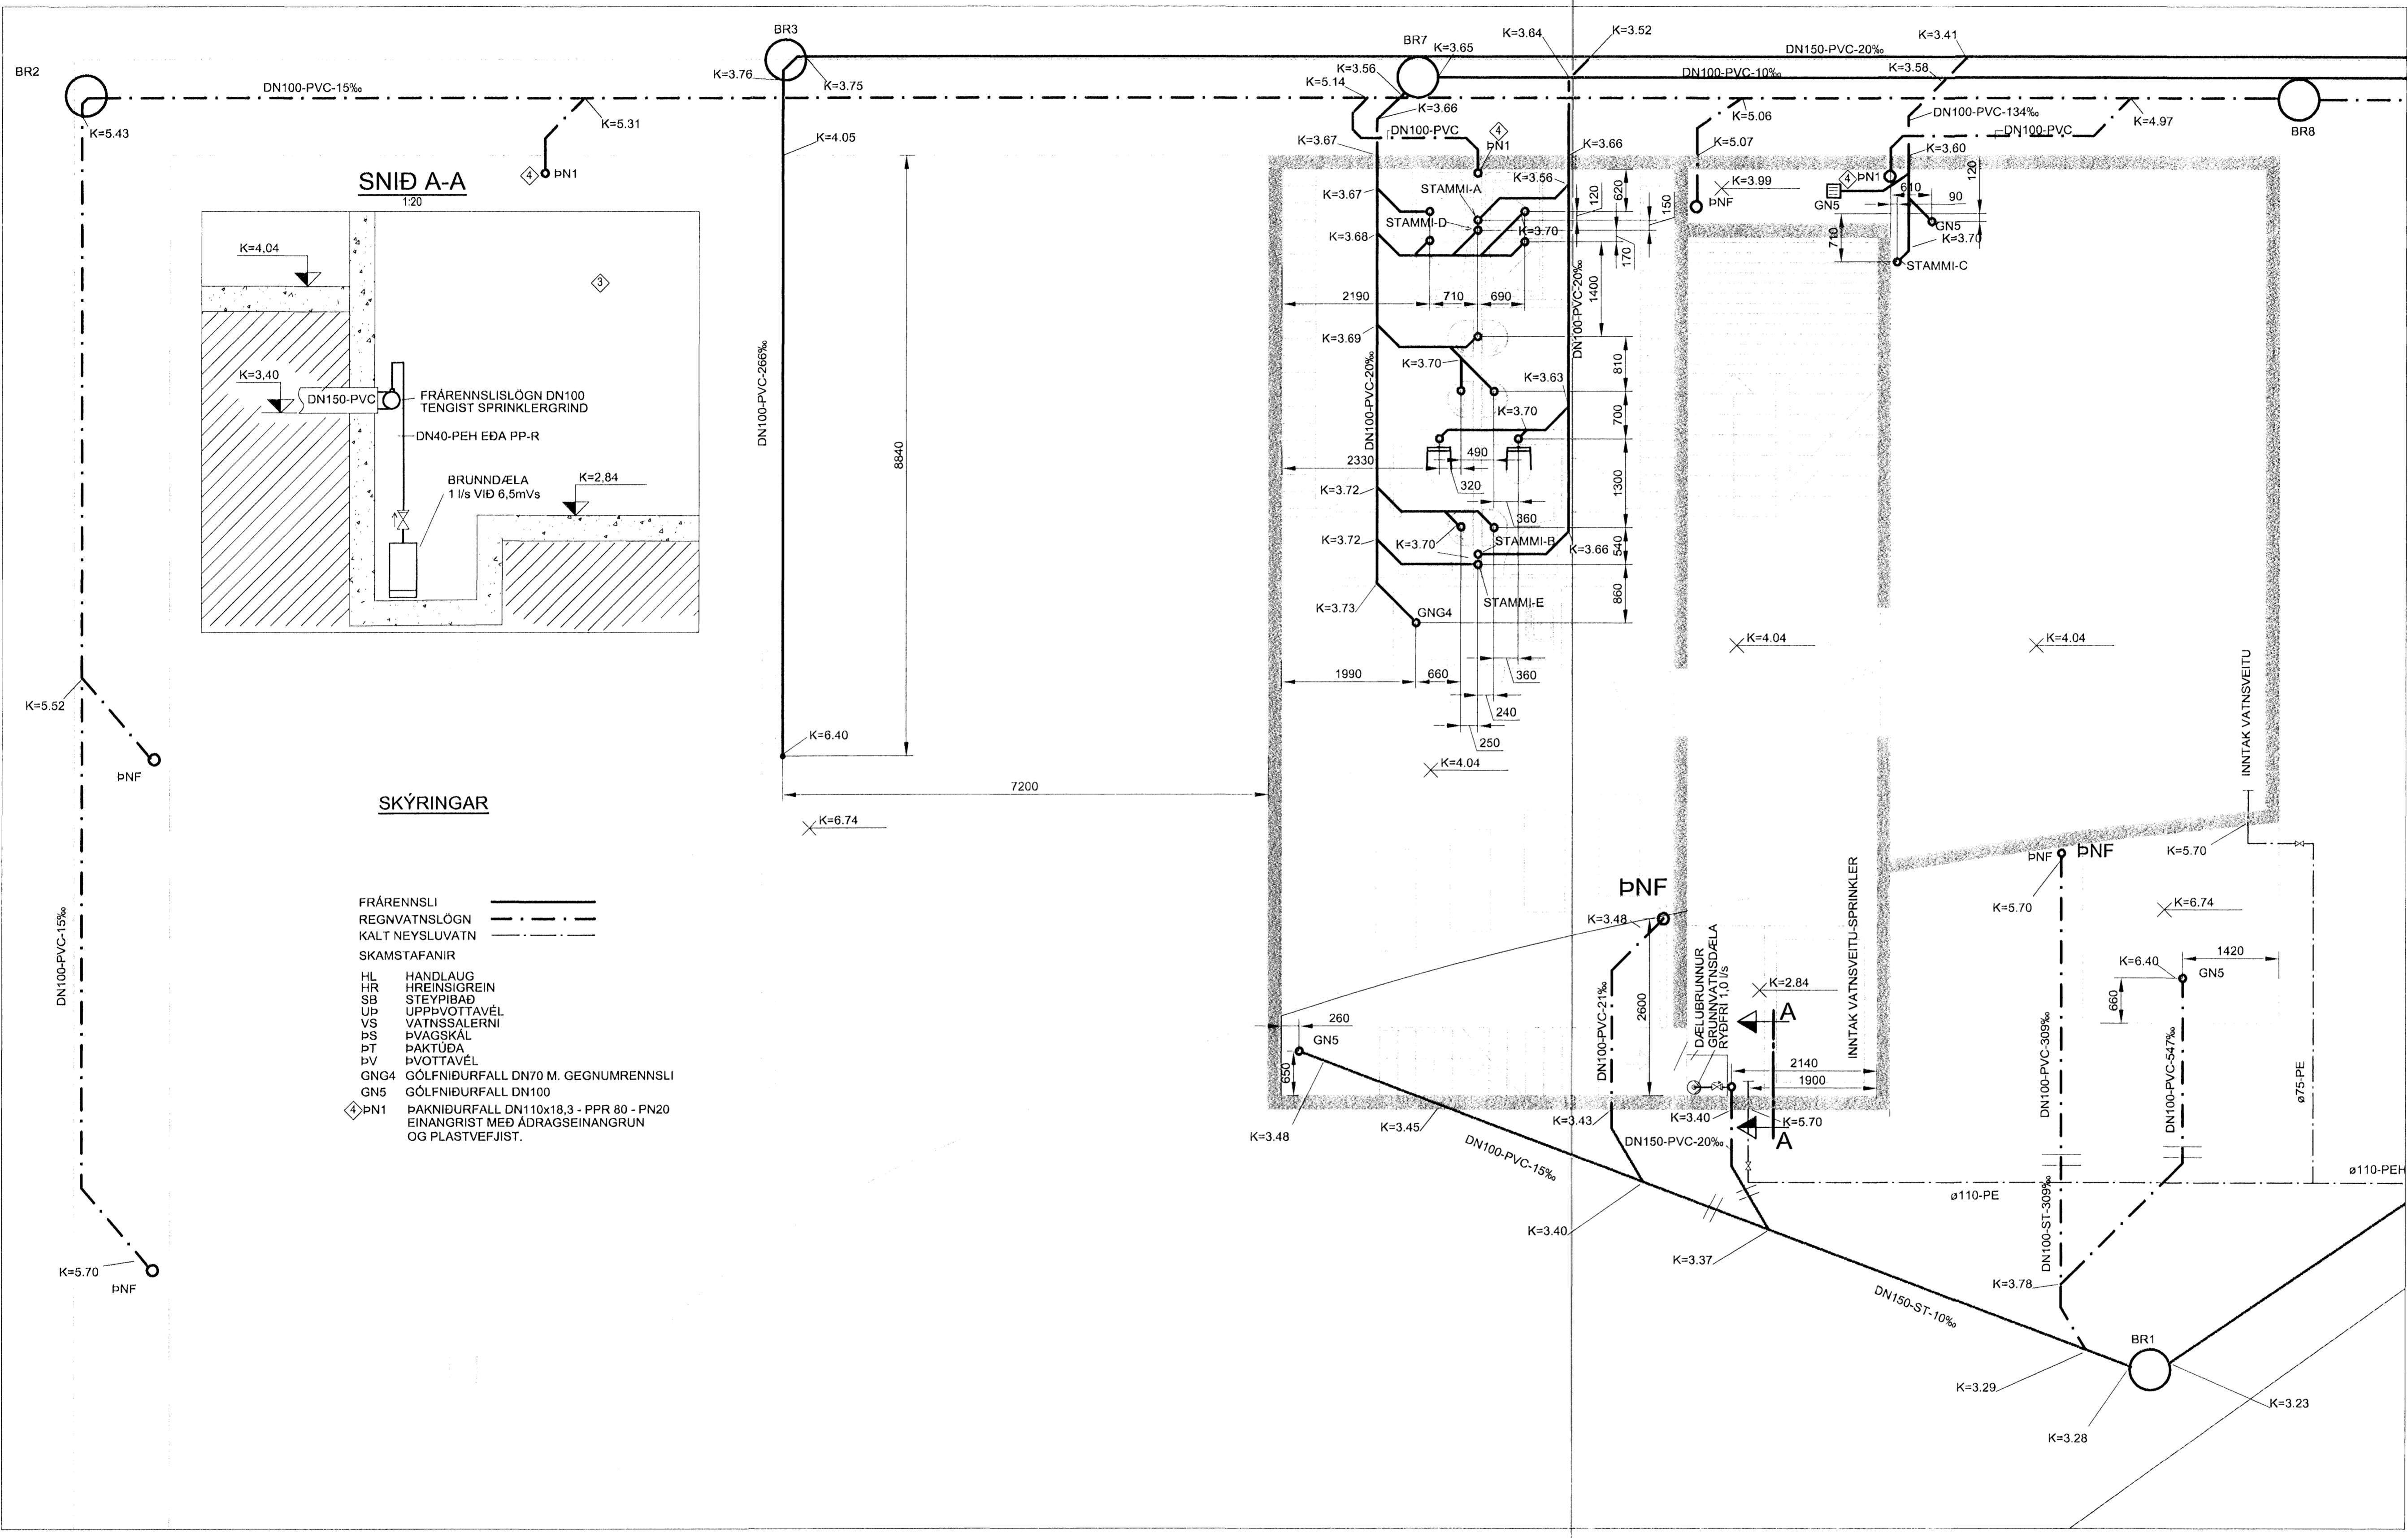

SKÝRINGAR

- FRÁRENNISLI
 REGNVATNSLÖGN
 KALT NEYSLUVATN
 SKAMSTAFANIR
- HL HANDLAUG
 - HR HREINSIGREIN
 - SB STEYPIBAD
 - UP UPPVOTTAVÉL
 - VS VATNSSALERNI
 - PS ÞVAGSKÁL
 - PT ÞAKTÚÐA
 - PV ÞVOTTAVÉL
 - GNG4 GÖLFNIDURFALL DN70 M. GEGNUMRENNISLI
 - GN5 GÖLFNIDURFALL DN100
 - PN1 ÞAKNIDURFALL DN110x16,3 - PPR 80 - PN20 EINANRIST MED ÁDRAGSEINANGRUN OG PLASTVEFJIST.

Skýringar:
 Explanations:

[Handwritten signature]



Breyt. / Rev.	Breyting / Revision	Dags. / Date	Samb. / Approved	Netk. heimil. / Released
4	ÞAKNIDURFÖLL PN1 KOMA INNANHÖSS	31.03.'04	RK.	
3	GÖLFNIDURFALLI BÆTT VIÐ OG BR1. FERÐUR TIL ÁSAMT LÖGNUM	24.10.'03	ÓS.	
2	LAGNIR MÁL OG KÓTASETTAR Í SÖKKLI	17.10.'03	ÓS.	
1	VINNUTEIKNING	09.09.'03	RK.	

Tiltekið / nr. ISAL Ref. drawing no. of ISAL

Samsætt. / tekið / nr. ISAL Assembly drawing no. of ISAL

Fjöldi stykja / Number of pieces		Mitur / Object		Atriði / Item	Efni / Material	eo. stik / Weight	totalt / heild / (kg) / byggd	Athugasemdir / Remarks
IV	III	II	I					
SKRIFSTOFUHÓUS ALCAN Mhl. 94				FRUNNMYND SÖKKLA		4110 01199		1:50
FRÁRENNISLAGNIR				UM10		9K-63		4
VGG CONSULTING ENGINEERS LTD.				ALCAN PRIMARY METAL EUROPE		168804		4

01 JUNI 2005
 31