


GRUNNMYND 2.HÆÐAR - HREINLÆTISLAGNIR

1:50

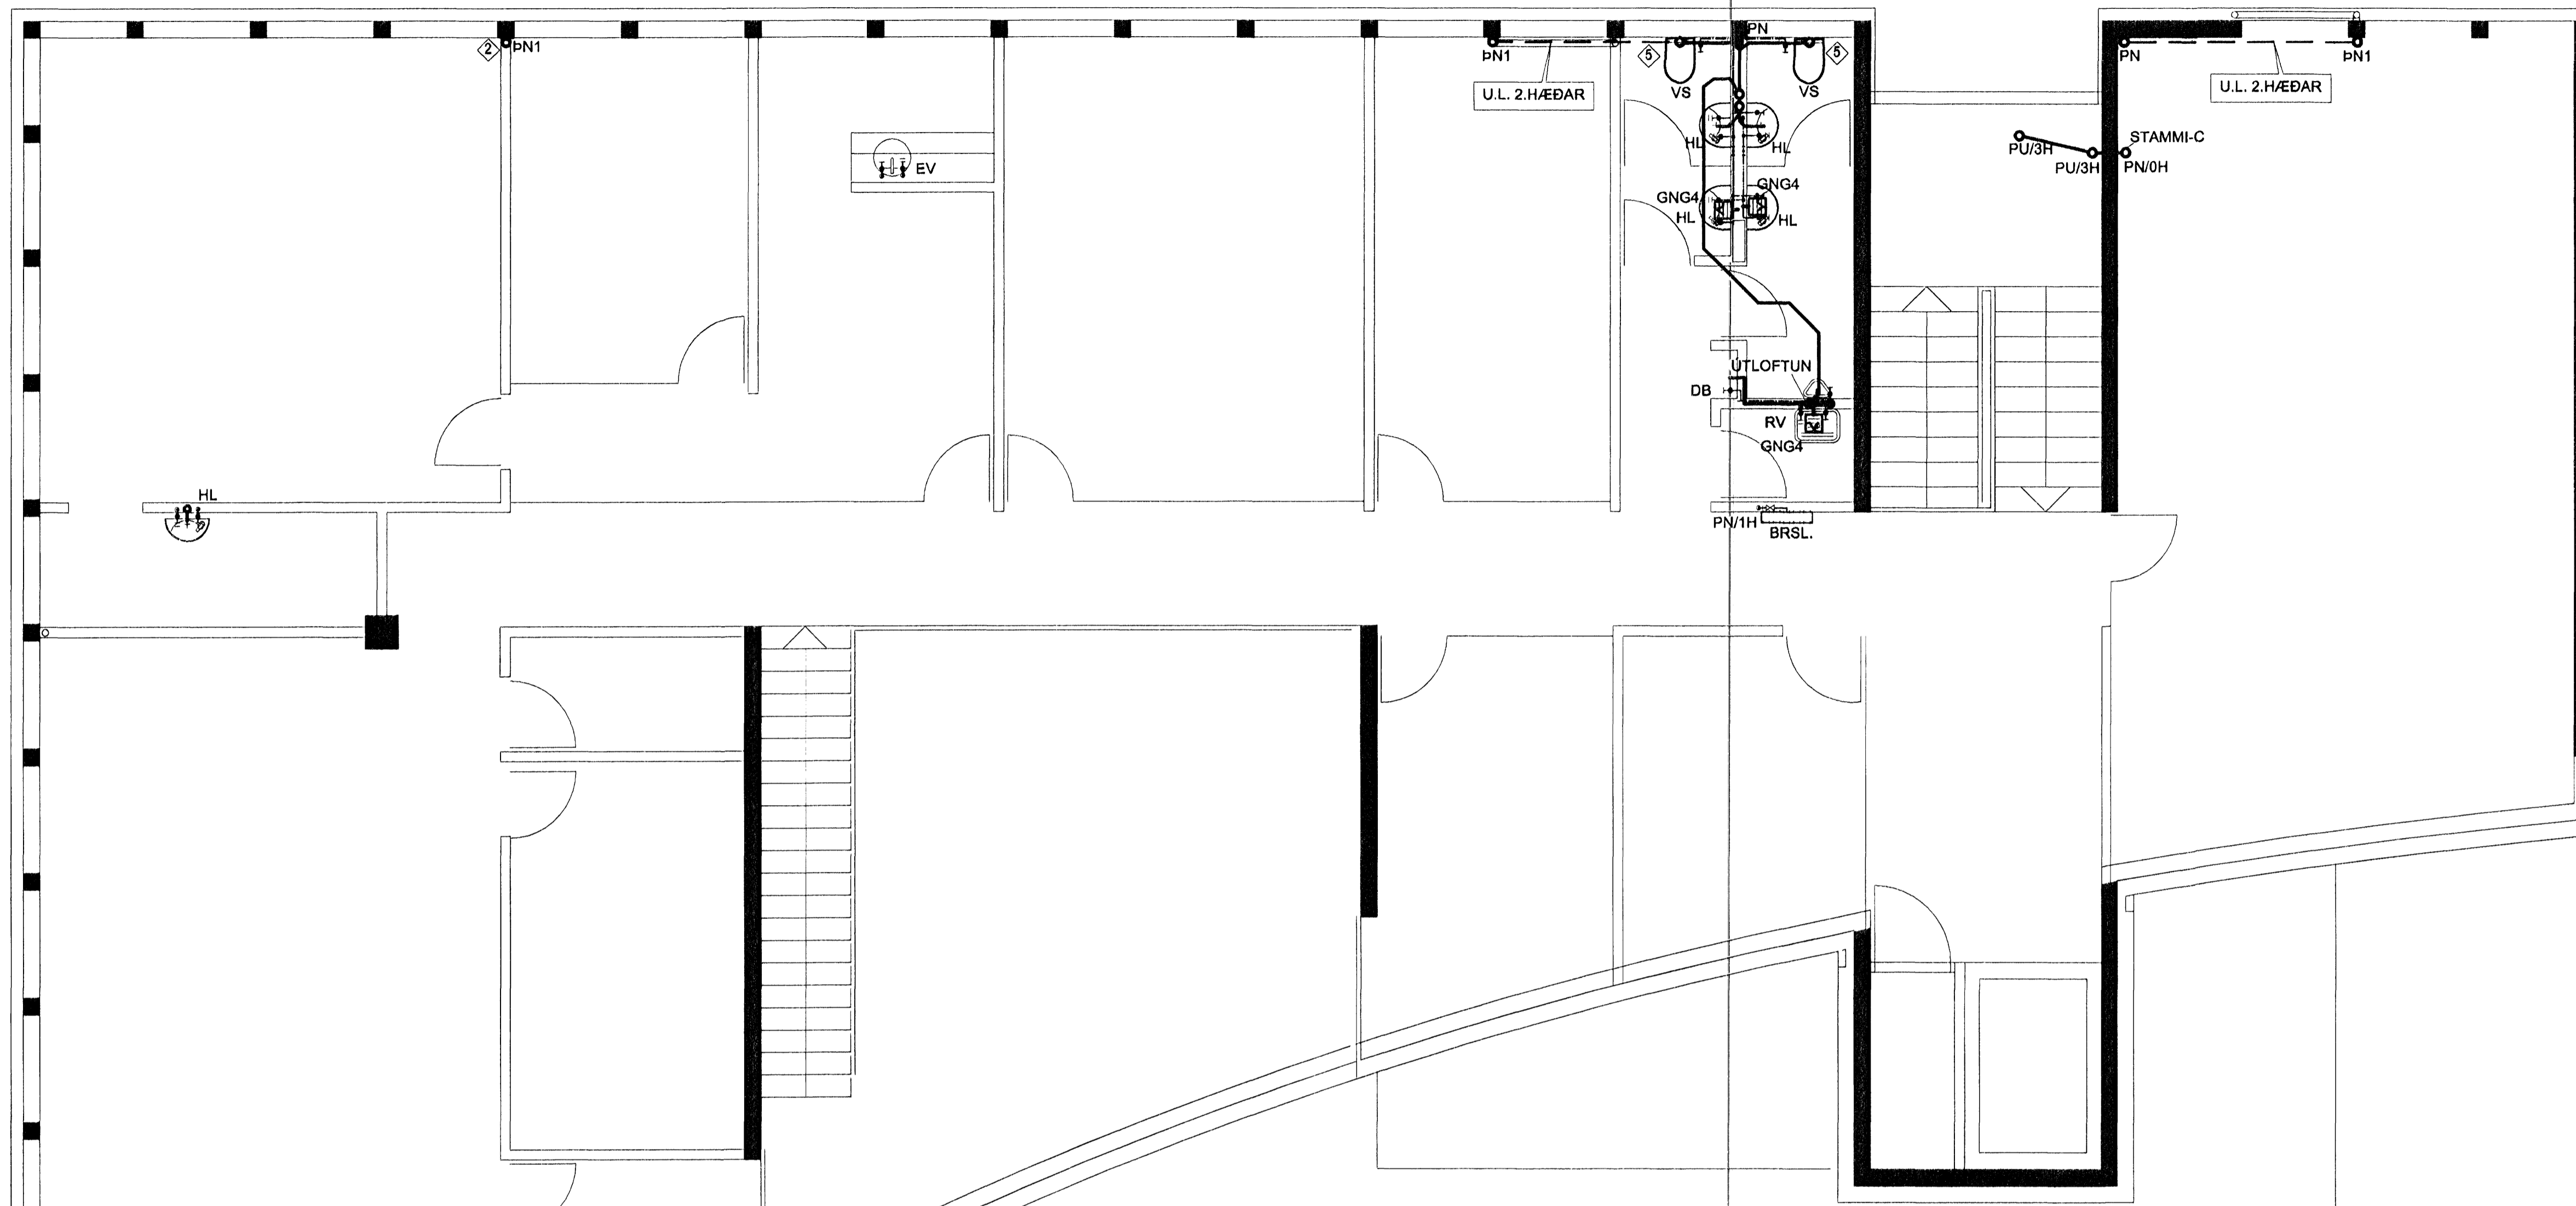


SKÝRINGAR

KALT NEYSLUVATN
 HEITT NEYSLUVATN
 HRINGRÁS
 SLÖKKVILÖGN
 FRÆRENNSLI

SKAMSTAFANIR


HL HANDLAUG
 HR HREINSIGREIN
 SB STEYPIBÍÐ
 UP UPPVOTTAVÉL
 VS VATNSSALERNI
 ÞS ÞVAGSKÁL
 ÞT ÞAKTÚÐA
 ÞV ÞVOTTAVÉL
 GNG4 GÖLFNIÐURFALL DN70 M. GEGNUMRENNSLI
 GN5 GÖLFNIÐURFALL DN100
 Ⓧ PN1 ÞAKNIÐURFALL DN110x18,3 - PPR 80 - PN20
 EINANGRIST MED AÐRAGSEINANGRUN
 OG PLASTVEFJÚST.

FRÁGANGUR VIÐ STÚT FRÁ ÞNF.

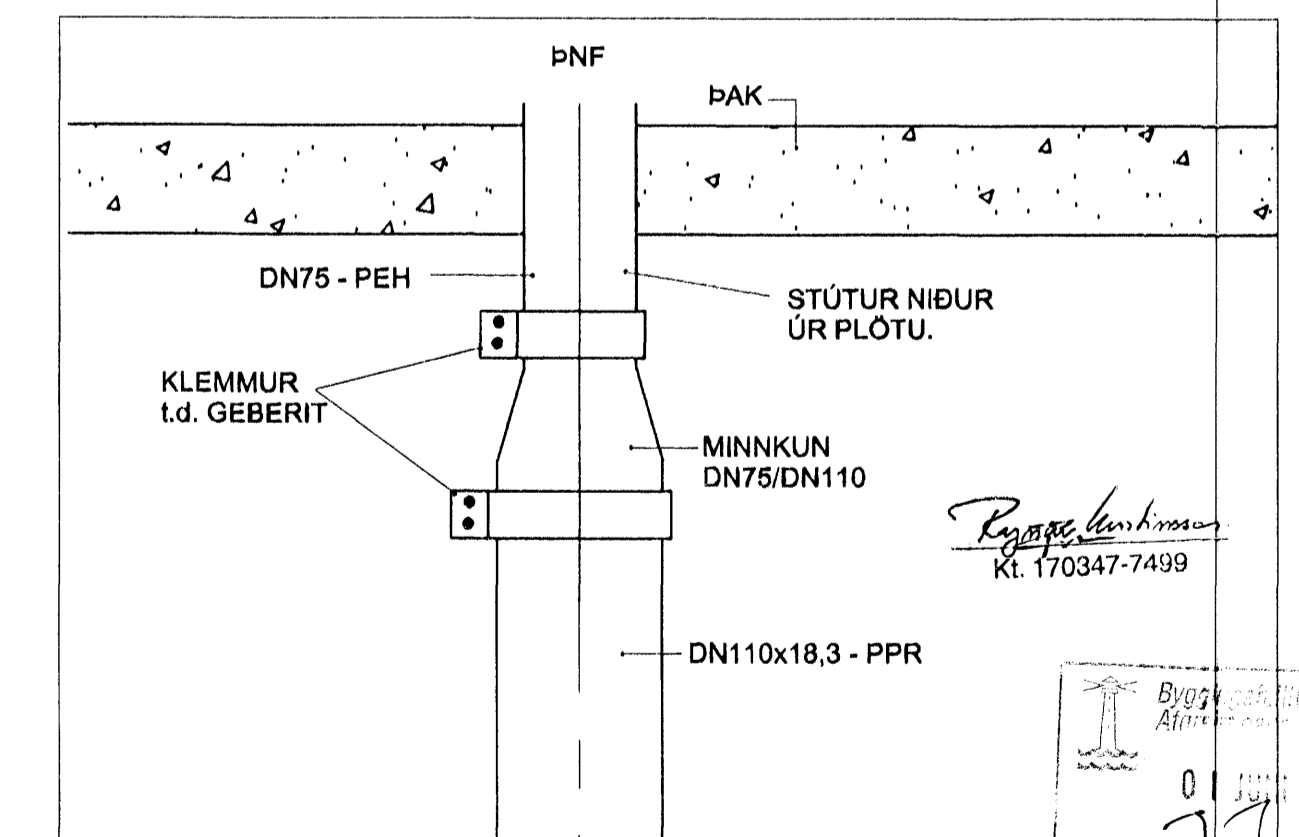

Skýringar:
 Explanations:

[Handwritten signature]

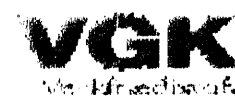

Breyt. Rev.	Daga. Date	Samb. Approved	Notk. heiml. Released						
5	EFTIR FRAMKVÆMD	28.09.04	ÓS.						
4	NÝR GRUNNUR	07.05.04	ÓS.						
3	ÞAKNIÐURFÖLL ÞN1 KOMA INNANHÓSS	31.03.04	ÓS.						
2	ÚTLOFTUN FÆRÐ TIL	28.01.04	ÓS.						
1	VINNUTEKINGING	09.09.03	RK.						

Fjöldi stykja/pieces Number of pieces		Hlutur Object		Atriði Item		Efni Material		Eo.stk Weight		Totalt heild / Total weight		Athugasemdir Remarks	
5		SKRIFSTOFUHÚS ALCAN		Mhl. 94		Form A1		Scale 1:50		4110 01199		5	

This drawing is the property of the Alcan Iceland Ltd. and handed out for personal use only. It may neither be copied nor made available to others without permission of the Alcan Iceland Ltd. The receiver is liable for any misuse.

