


GRUNNMYND KJALLARA - HITLAGNIR

1:50

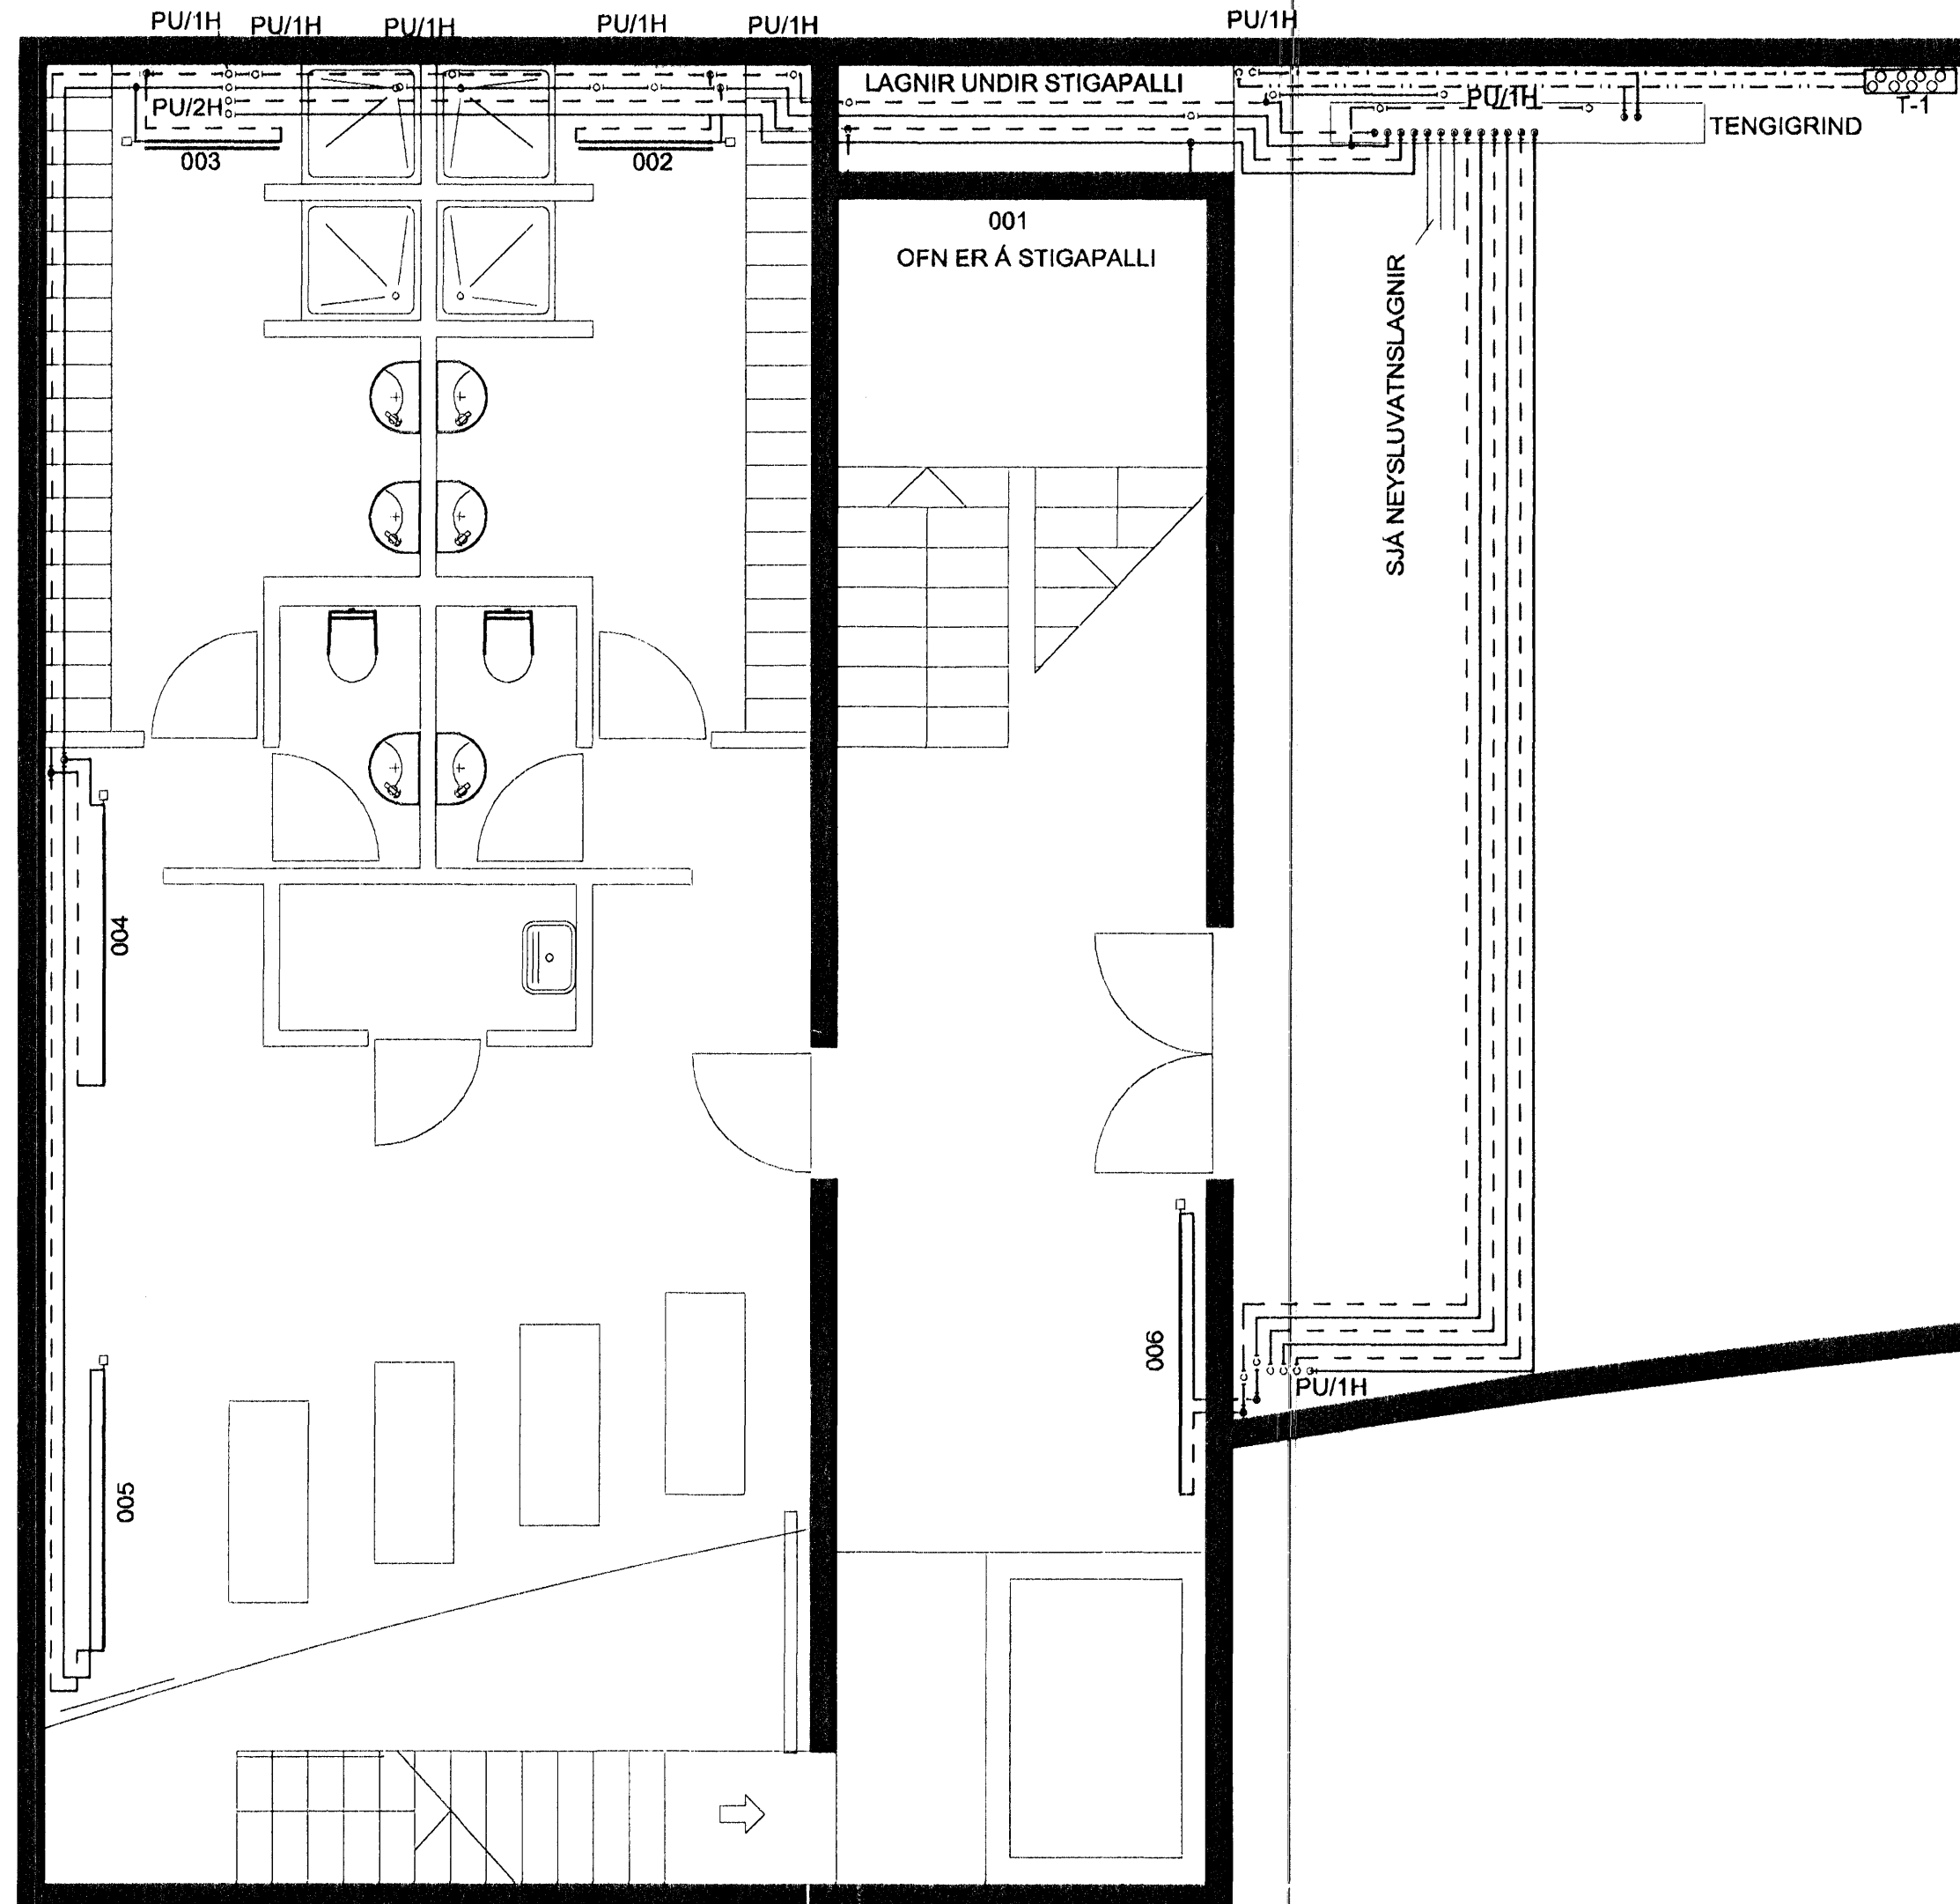

*Ragnar Þorsteinsson*  
Kt. 1706517499

OFNASKRÁ

Tegund, td.		Framrás/bakrás=80°/40°C		dp = 0,10bar				
Ofn nr.	Sterð ofnloka	Gerð/hæð ofna [mm]	Lengd ofna [mm]	Afköst W	Stúta-staðsetn.	Stíllitla Ofnloka Danf.-RA-N	Stíllitla Ofnloka TA-v vinkil	Stíllitla Ofnloka TA-beim
001	DN10	11-770	2000	1574	CB	3	5	5
002	DN10	22-770	1000	1400	CB	3	4	4
003	DN10	22-770	1000	1400	AD	3	4	4
004	DN10	11-770	2000	1574	CB	3	5	5
005	DN10	11-770	2000	1574	CB	3	5	5
006	DN10	11-770	2000	1574	AD	3	5	5

Skýringar:  
Explanations:

*[Handwritten signature]*



This drawing is the property of the Alcan Iceland Ltd. and handed out for personal use only. It may neither be copied nor made available to others without permission of the Alcan Iceland Ltd. The receiver is liable for any misuse.

Fjöldi stúkkja Number of pieces		Hlutur Object		Atriði Item		Efni Material		Ea. sta. Weight		Höfuð tölur Qty		Alhúsgættur Remarks	
IV	III	II	I	SKRIFSTOFUHÚS ALCAN		Mhl. 94		Stærð Format		Mk. Scale		1:50	
GRUNNMYND KJALLARA												Kostn. nr. / Ónno.-Eq.no.	
HITALAGNIR												4110 01199	
Virktafi / Supplier												AKS no.	
VGG CONSULTING ENGINEERS LTD.												UM10	
Tökn. nr. / vefn. / Ónno. of suppl. / Breyt. / Rev.												9K-70 3	
Tökn. nr. / Ónno. of ISAL / Ónno. of ISAL												168809 3	
Tökn. nr. / Ónno. of ISAL												168809 3	
Breyt. / Rev.		Breyting / Revision		Dags. / Date		Samb. / Approved		Notk. / Released		Tökn. nr. / Ónno. of ISAL		168809 3	
3 EFTIR FRAMKVÆMD		28.09.04		ÓS.									
2 NÝR GRUNNUR		07.05.'04		ÓS.									
1 VINNUTEKNING		09.09.'03		RK.									
