

GRUNNMYND 2.HÆÐAR - HITALAGNIR


1:50

PENNSLUSLAUFA

TENGIKISTA T-2

SLAUFNA NFR. 1	LENGD = 10.8m
SLAUFNA NFR. 2	LENGD = 2.5m
SLAUFNA NFR. 3	LENGD = 10.0m
SLAUFNA NFR. 4	LENGD = 2.8m

UNDIRLAG GÖLFGEISLA
ER EINANGRANDI
TAKKADUKUR

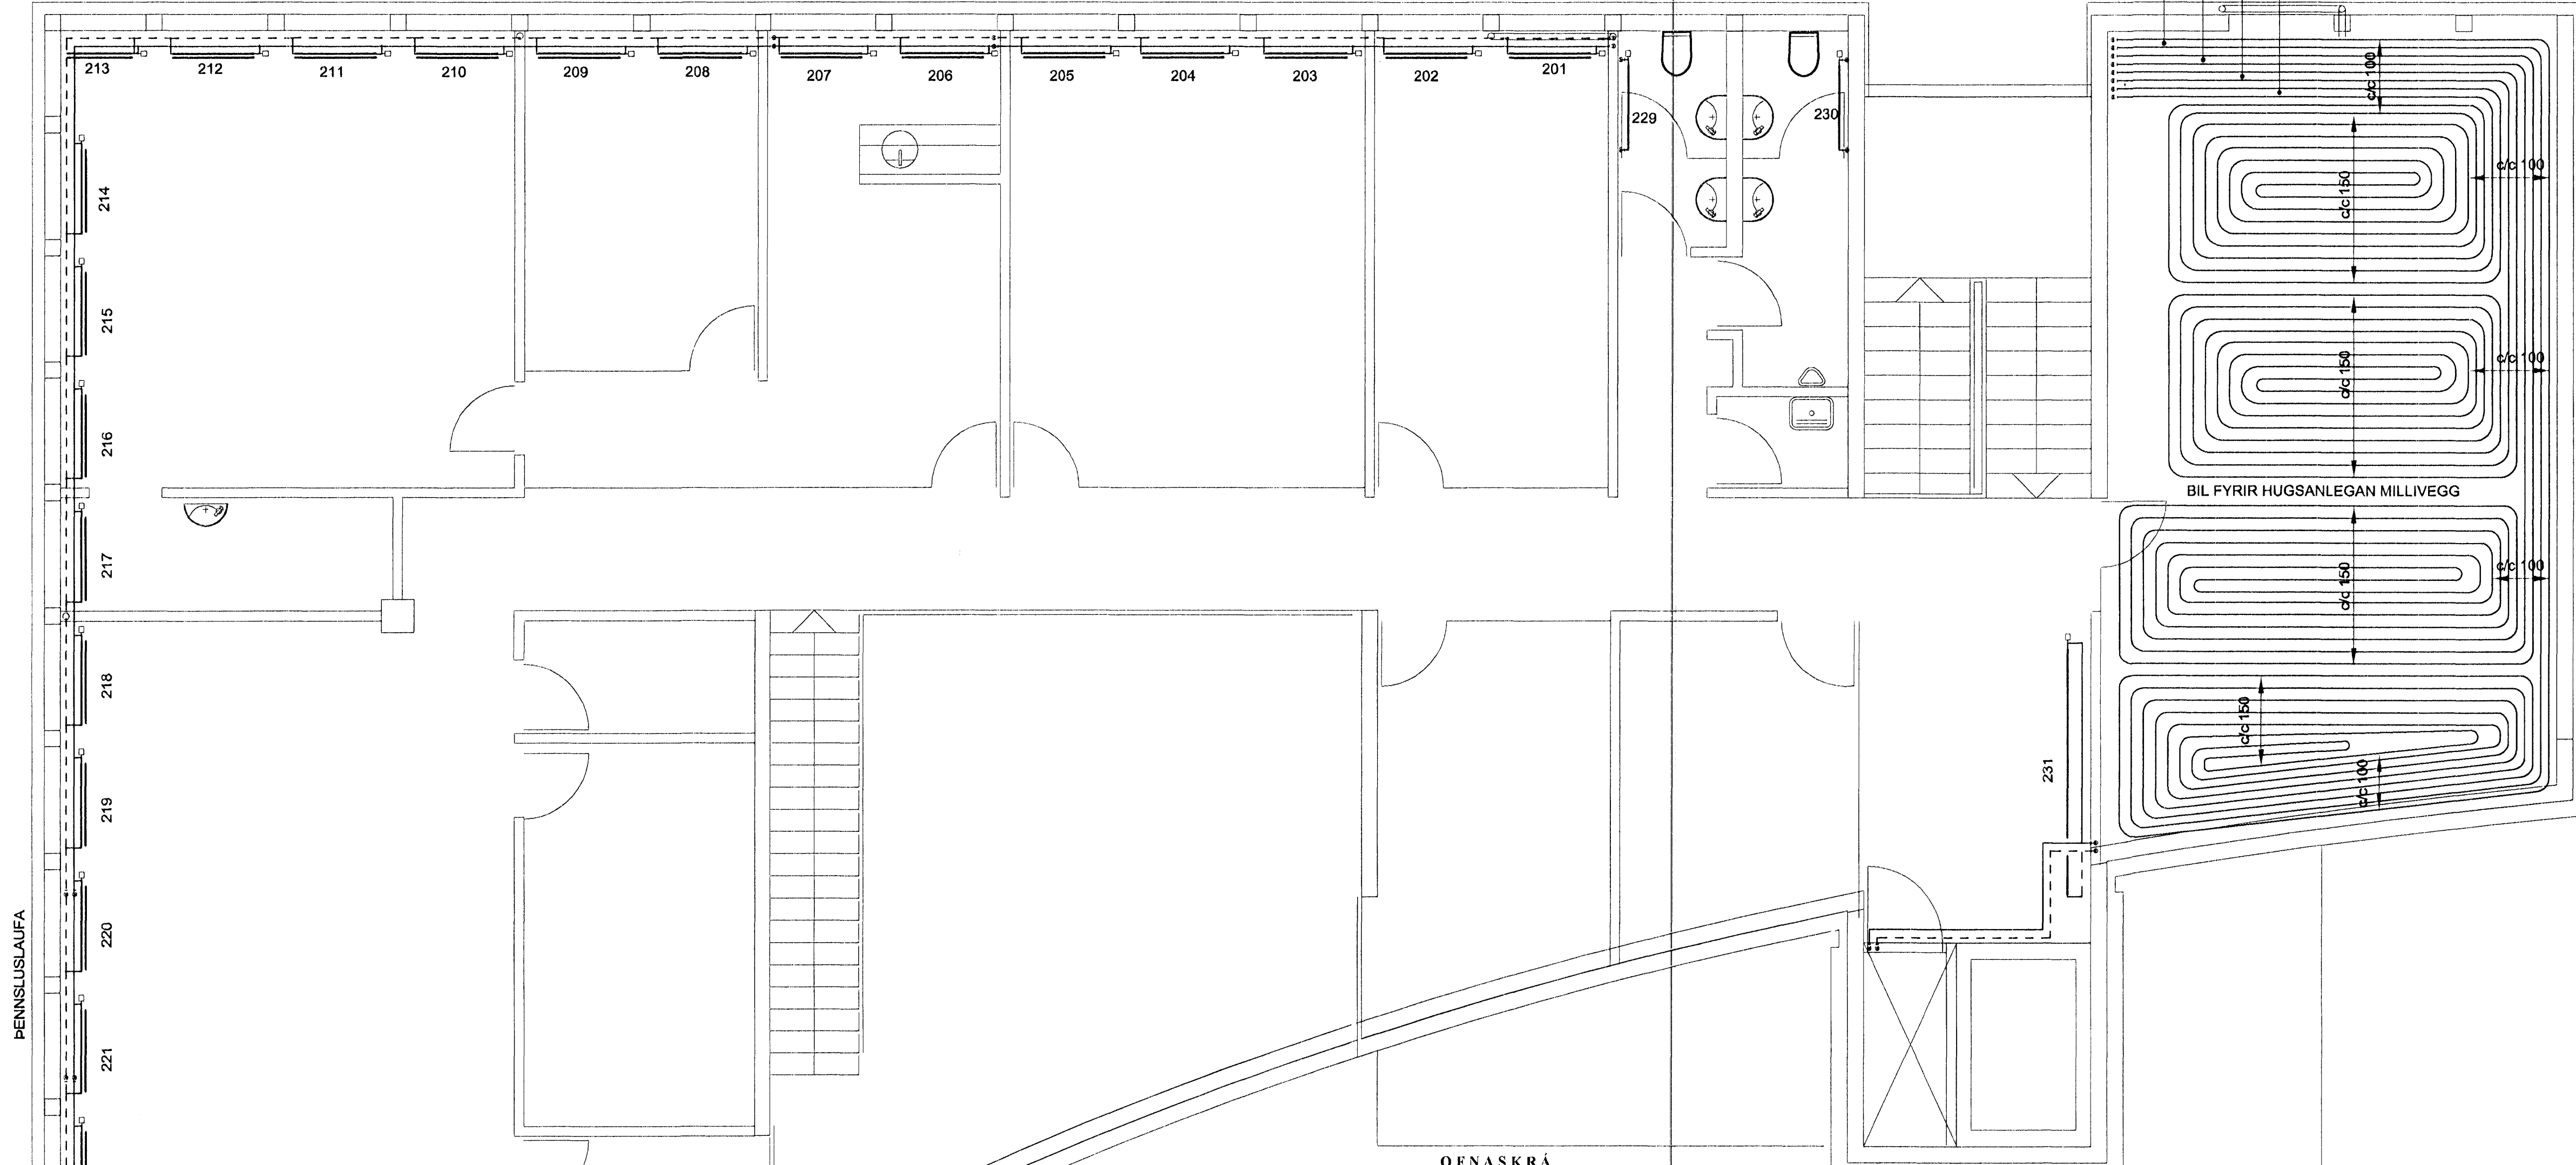

OFNASKRÁ

Tegund, td	Ofn nr.	Stærð ofnloka	Gerð hæð ofna [mm]	Lengd ofna [mm]	Afköst W	Stúta-staðsetn.	Stíllitala Ofnloka Danf-R-A-N	Stíllitala Ofnloka TA-v.vinkli	Stíllitala Ofnloka TA-beinni
	201	DN10	22-560	1000	1197	CB	3	4	4
	202	DN10	22-560	1000	1197	CB	3	4	4
	203	DN10	22-560	1000	1197	CB	3	4	4
	204	DN10	22-560	1000	1197	CB	3	4	4
	205	DN10	22-560	1000	1197	CB	3	4	4
	206	DN10	22-560	1000	1197	CB	3	4	4
	207	DN10	22-560	1000	1197	CB	3	4	4
	208	DN10	22-560	1000	1197	CB	3	4	4
	209	DN10	22-560	1000	1197	CB	3	4	4
	210	DN10	22-280	1000	710	CB	3	4	4
	211	DN10	22-280	1000	710	CB	3	4	4
	212	DN10	22-280	1000	710	CB	3	4	4
	213	DN10	22-280	800	568	CD	2	3	3
	214	DN10	22-560	1000	1197	CB	3	4	4
	215	DN10	22-560	1000	1197	CB	3	4	4
	216	DN10	22-560	1000	1197	CB	3	4	4
	217	DN10	22-560	1000	1197	CB	3	4	4
	218	DN10	22-560	1000	1197	CB	3	4	4
	219	DN10	22-560	1000	1197	CB	3	4	4
	220	DN10	22-560	1000	1197	CB	3	4	4
	221	DN10	22-560	1000	1197	CB	3	4	4
	222	DN10	22-560	1000	1197	CB	3	4	4
	223	DN10	22-560	1000	1197	CB	3	4	4
	224	DN10	22-560	1000	1197	CB	3	4	4
	225	DN10	22-560	1000	1197	CB	3	4	4
	226	DN10	22-560	1000	1197	CB	3	4	4
	227	DN10	22-560	1000	1197	CB	3	4	4
	228	DN10	22-560	1000	1197	CB	3	4	4
	229	DN10	11-560	1000	663	AD	2	2	2
	230	DN10	11-560	1000	663	AD	2	2	2
	231	DN10	11-770	3000	2361	AD	4	6	6

Reginvaldi
Kl. 170347-7499

Byggingarritun
Almannavegur 1
101 Reykjavík
01 JUN 2005
22

Skýringar:
Explanations:

Handwritten signature

5	EFTIR FRAMKVEMD	28.09.04	ÓS.
3	4. OFNAR LEKKADIR - SJA OFNATOFLU	21.06.04	ÓS.
2	NÝR GRUNNUR	07.05.04	ÓS.
1	VINNUTEKNING	09.09.'03	RK.

Breyt./ Rev. Daga/ Date Smb./ Approved Helt heim./ Released

Tilvitnunar nr. ISAL Samein. teikningar nr. ISAL
Ref drawing no. of ISAL Assembly drawing no. of ISAL

This drawing is the property of the Alcan Iceland Ltd. and handed out for personal use only. It may neither be copied nor made available to others without permission of the Alcan Iceland Ltd. The receiver is liable for any misuse.

Fjöldi stúkkja Number of pieces	Hlutur Object	Atriði Item	Efni Material	ea. stk Weight (kg)	total: fjöldi Scale	Athugasemdir Remarks
IV / III / II / I	SKRIFSTOFUHÚS ALCAN GRUNNMYND 2.HÆÐAR HITALAGNIR	Mhl. 94			Stærð Format: A1	Msk. Skala Scale: 1:50
	Varkali / Supplier	Vilborgarata 3			Kostnaður / Cost	4110
	Teiknað Drawn	ÓS.	Yfirfarið Checked		Sambýtt Approved	AKS no. UN10
	ALCAN PRIMARY METAL EUROPE ISAL Alcan Iceland Ltd	Straumsvík IS-222 Hafnarfordur			Drw. no. of ISAL / Tpk. nr. ISAL	9K-72
					168811	3