Format A1 (841x594 mm) is 20 mm outside of this frame

# VEGGMYND TENGIKLEFA

1:20

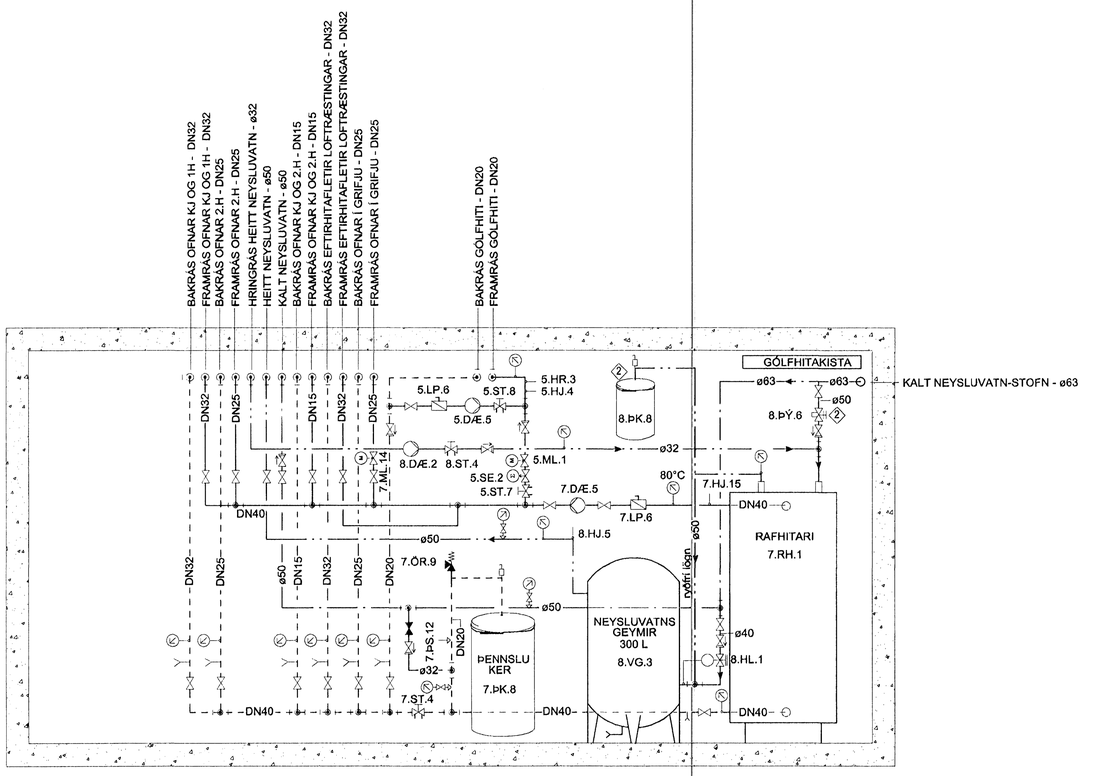


Kt. 170363-7499

Skýringar:
Explanations:

| Breyt. Rev. | Breyting Revision | Dags. Date | Samþ. Approved | Nótk. heimil. Released |
|---|---|---|---|---|
| 2 | EFTIR FRAMKVÆMD | 28.09.04 | ÓS. | |
| 1 | VINNUTEIKNING | 09.09.'03 | RK. | |

Tilv.teikningar nr. ISAL / Ref.drawing no. of ISAL

Samsetn.teikningar nr. ISAL / Assembly drawing no. of ISAL

This drawing is the property of the Alcan Iceland Ltd. and handed out for personal use only. It may neither be copied nor made available to others without permission of the Alcan Iceland Ltd. The receiver is liable for any misuse.

Fjöldi stykkja Number of pieces: IV III II I

Hlutur Object: SKRIFSTOFUHÚS ALCAN Mhl. 94

VEGGMYND TENGIKLEFA

HITALAGNIR Viðbygging 3

Verktaki / Supplier: VGK CONSULTING ENGINEERS LTD.

Teiknað Drawn | Yfirfarið Checked

ALCAN PRIMARY METAL EUROPE
ISAL
Alcan Iceland Ltd
Straumsvík
IS-222 Hafnarfjordur

Teiknað Drawn | Yfirfarið og skráð Checked and filed | Nótkun heimiluð Released

Atriði Item | Efni Material | ea:stk Weight | totalt í heild (kg) Byrjad | Athugasemdir Remarks

Stærð Format: A1 | Mkv. Scale

Kostn.nr.-Bún.nr. / COno.-Eq.no.: 4110 01199

AKS no.: UM10

Teikn.nr. verktaka / Drwg.no. of supp.: 9K-74 | Breyt./Rev.: 2

Samþykkt Approved

Drw.no. of ISAL / Teikn.nr. ISAL: 168814 | Breyt./Rev.: 2

Byggingarfulltrúinn í Hafnarfirði
Byggingarleyfi
01 JÚNÍ 2005