



KERFISMYND-KERFI 5,6,7,8

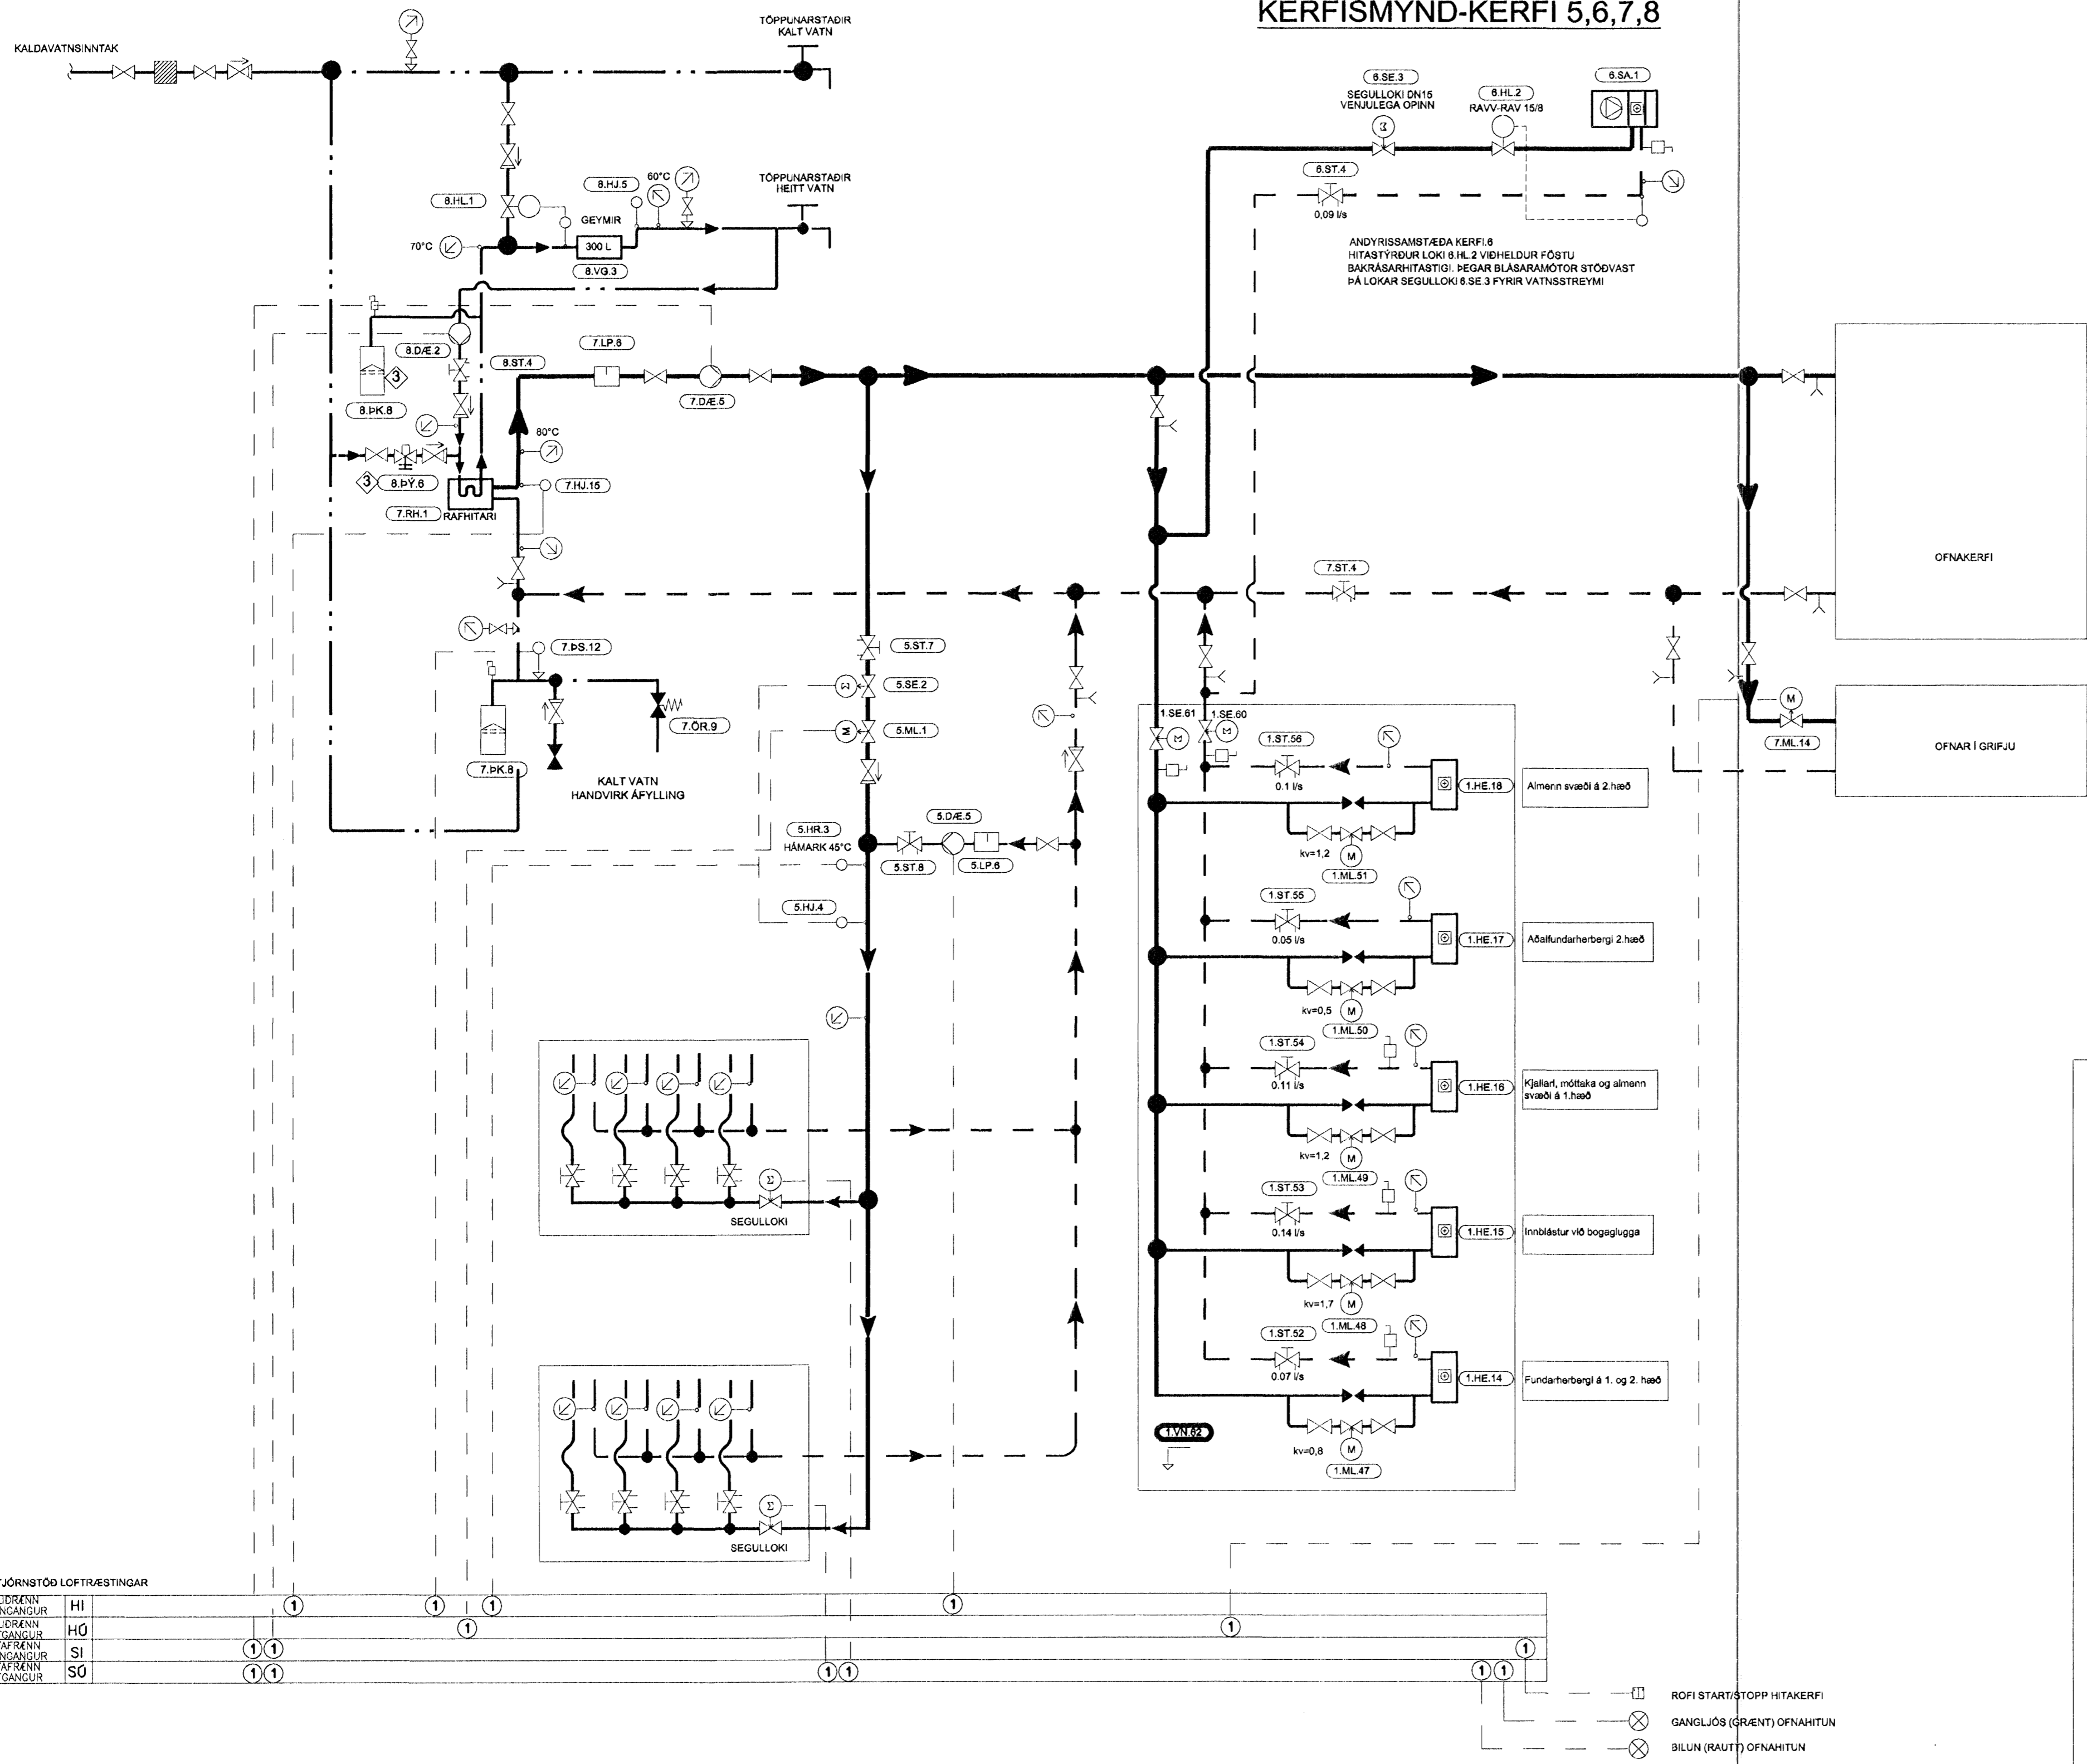

SKÝRINGAR

- 7.ÖR.9 ÖRYGGISLOKI DN20 3.5 bar
- 7.D.É.5 DÆLA G=0.9, pd=80 kPa
- 7.LP.8 LOFTSKILJA DN40, SJÁLFPVIRK
- 7.ST.4 STILLILOKI TA-STAD 0.82 l/s, dp=10 kPa
- 7.ML.14 MÓTORLOKI kv=1.8
- 7.HJ.11 VATNSHITASKYNNJARI 0°C-100°C
- 7.PS.12 ÞRÝSTISKYNNJARI
- 7.BK.8 ÞENNSLUKER 150 L
- 7.RH.1 RAFHITARI 150 Kw
- HITAMELIR
- RENNISLUSMELUR
- ÖLUFYLLTUR ÞRÝSTIMELUR MED LOKA
- TÆMILOKI
- LOKI VANALEGA OPINN
- LOKI VANALEGA LOKADUR
- STILLILOKI (STILLITE)
- EINSTEFNULOKI
- 5.ML.1 MÓTORLOKI kv=0.8
- 5.SE.2 SEGULLOKI DN10
- 5.HR.3 VATNSHITASKYNNJARI 0°C-100°C
- 5.HJ.4 VATNSHITASKYNNJARI 0°C-100°C
- 5.D.É.5 DÆLA G=0.12 l/s, pd=25 kPa
- 5.LP.8 LOFTSKILJA DN15, SJÁLFPVIRK
- 5.ST.7 STILLILOKI TA-STAD 0.07 l/s, dp=10 kPa
- 5.ST.8 STILLILOKI TA-STAD 0.12 l/s, dp=10 kPa
- 8.HL.1 HITASTYRÐUR LOKI Danfoss AV7A-20
- 8.D.É.2 DÆLA G=0.2 l/s, pd=30 kPa
- 8.VG.3 NEYSLUVATNSGEYMR 300 L
- 8.ST.4 STILLILOKI TA-STAD 0.2 l/s, dp=10 kPa
- 8.HJ.5 VATNSHITASKYNNJARI 0°C-100°C
- 8.ÞY.8 ÞRÝSTUAFNARI DN40
- 8.BK.8 ÞENNSLUKER 100 L

DÆMIGERÐ STÝRING VID EFTIRHITARA

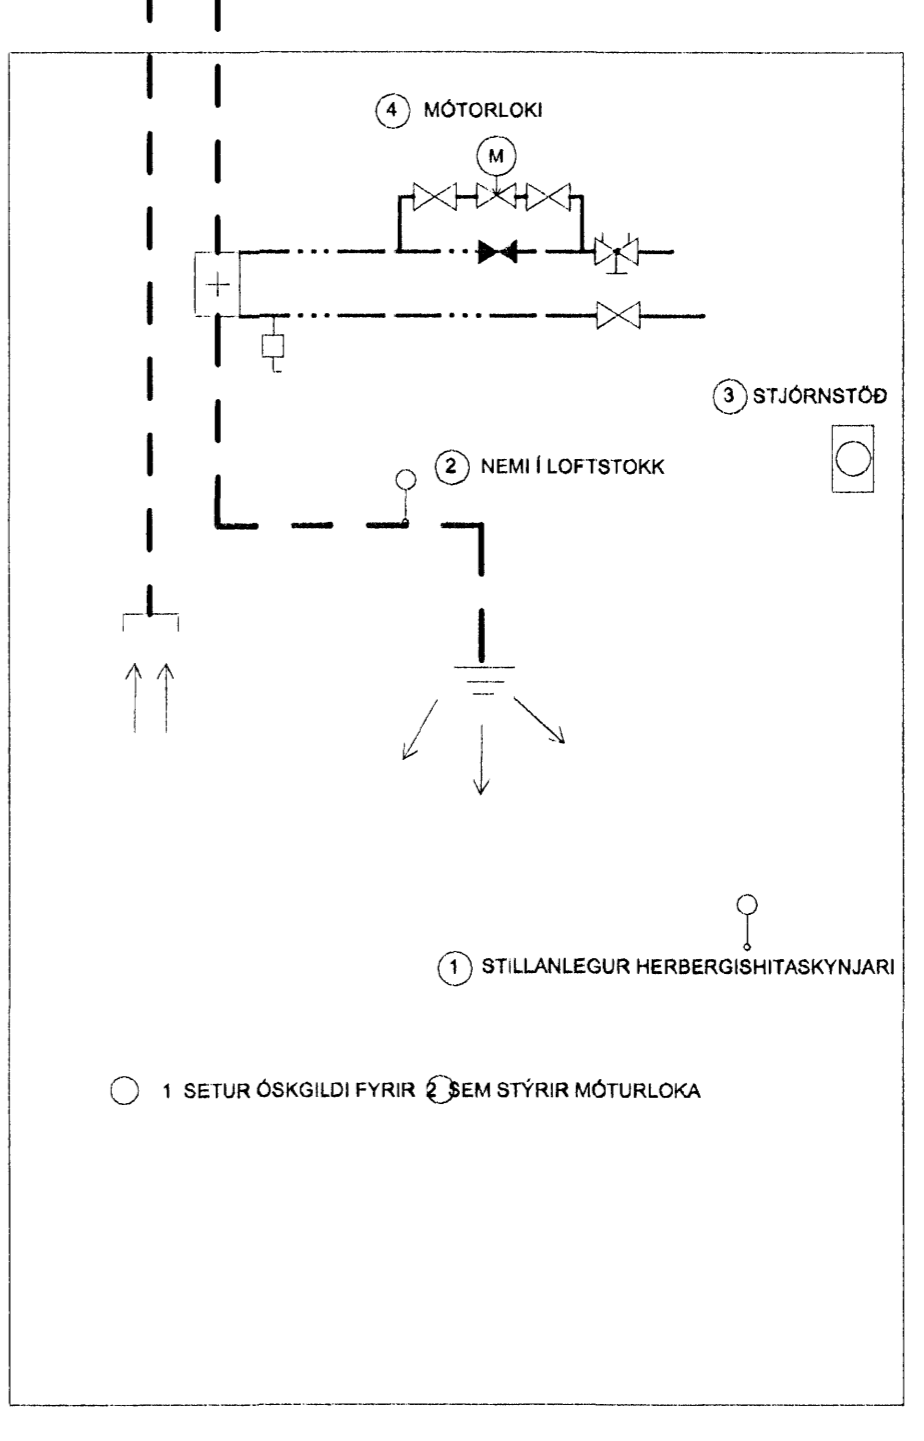

Egmont
Kt. 17.06.2005

2005

Skýringar:
Explanations:

STJÖRNSTÓÐ LOFTRÆSTINGAR	HI	HJ	SI	SO
HEIÐRENN INNGANGUR	1	1	1	1
HEIÐRENN OTANGUR	1	1	1	1
STAFRENN INNGANGUR	1	1	1	1
STAFRENN OTANGUR	1	1	1	1

- ROFI START/STÖPP HITAKERFI
- GANGLJÓB (GREEN) OFNAHTUN
- BILUN (RAUT) OFNAHTUN

VGK

Fjöldi stúkkja Number of pieces	Hlutur Object	Atrið Item	Efni Material	Sö-stk Weight (kg)	Totalt Total weight	Húsgæmdir Remarks	Mhl. 94	Stað Scale	Mkv. Eq.no.	%	Tilvitnað / Signed		
											Teknað / Drawn	Styrkt / Checked	
3	EFTIR FRAMKVEMD												
2	STÆRÐ 5.ST.7 BREYTT												
1	VINNUTEKNING												
Tilvitnað / Signed		Dagur / Date		Samb. / Approved		Húsk. heiml. / Released							
Tilvitnað / Signed		Dagur / Date		Samb. / Approved		Húsk. heiml. / Released							

This drawing is the property of the Alcan Iceland Ltd. and handed out for personal use only. It may neither be copied nor made available to others without permission of the Alcan Iceland Ltd. The receiver is liable for any misuse.

SKRIFSTOFUHOUS ALCAN Mhl. 94
KERFISM. KERFI 5, 6, 7 OG 8
HITALAGNIR
VGK CONSULTING ENGINEERS LTD.

ALCAN PRIMARY METAL EUROPE
ISAL Alcan Iceland Ltd

Strömsvík IS-222 Hafnarfjörður
168815 3