


**GRUNNMYND 3.HÆÐAR - HREINLÆTISLAGNIR**

1:50

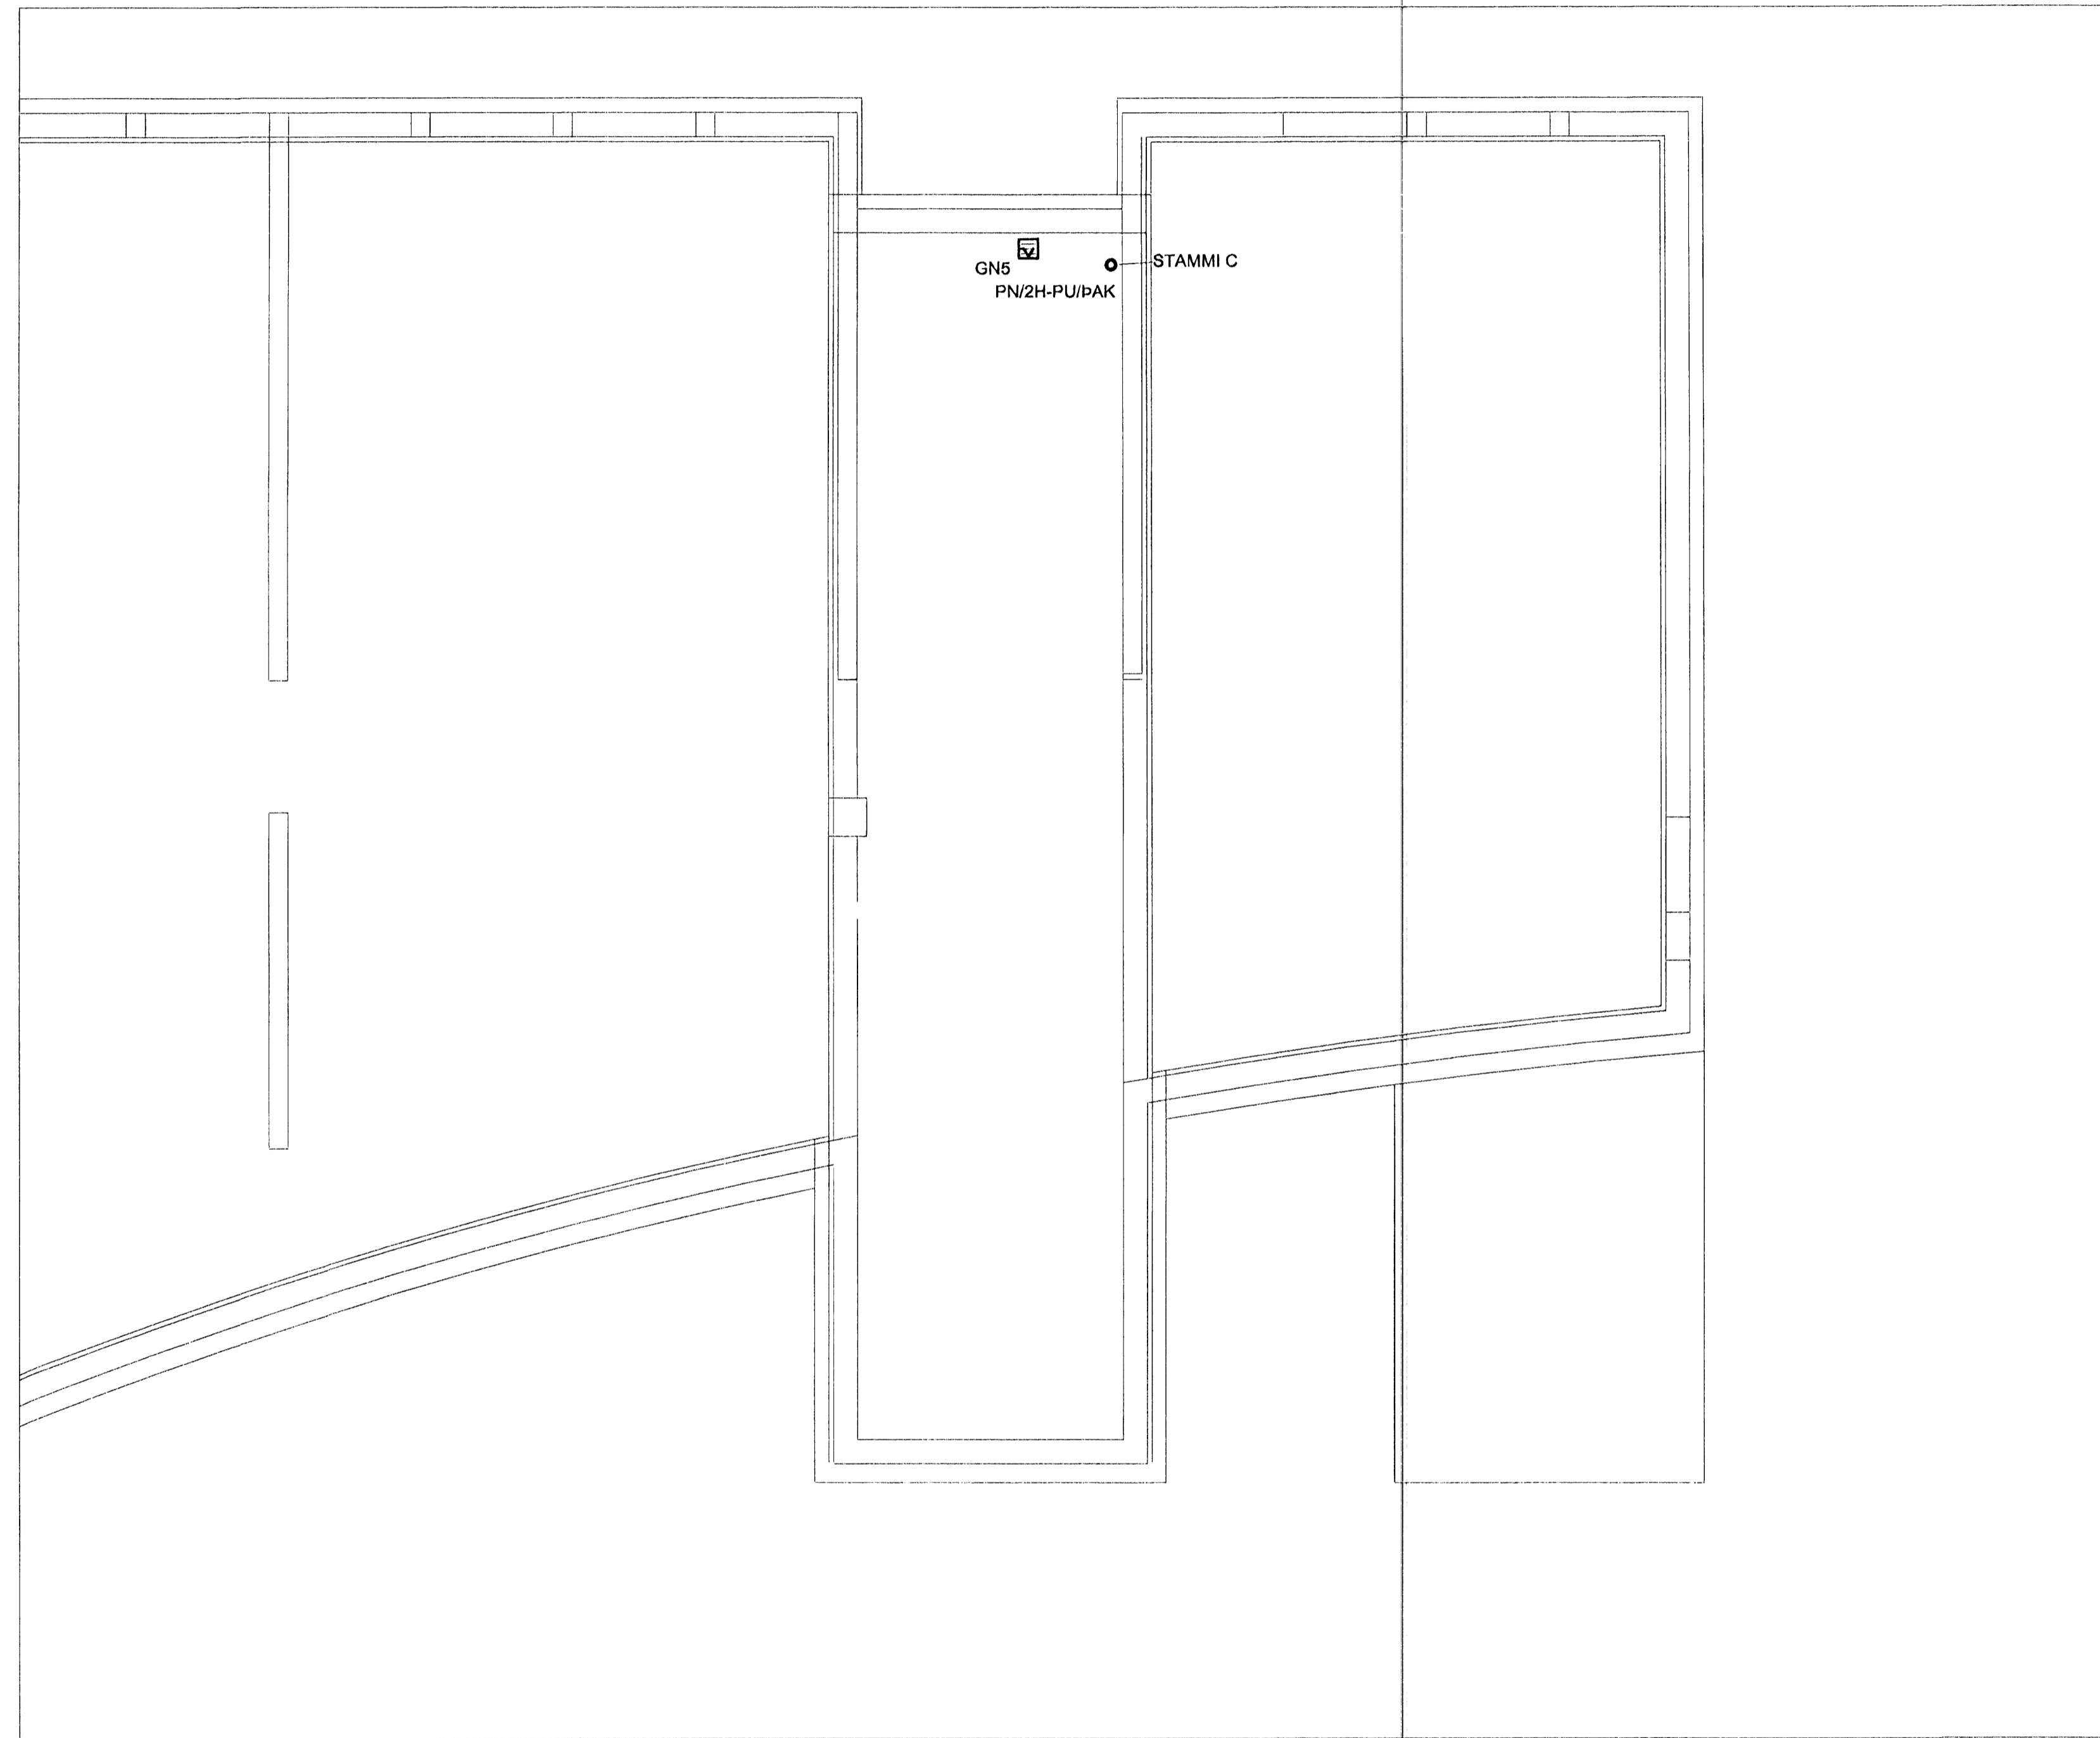


*Eignarforing*  
Rt. 1703

21 JUN 2005

Skýringar:  
Explanations:

*[Handwritten signature]*

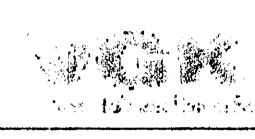

Breyt. Rev.	Daga Date	Samb. Approved	St. St. No.	St. St. No.
2	EFTIR FRAMKVÆMD	28.09.04	ÓS.	
1	VINNUTEIKNING	09.09.'03	RK.	

This drawing is the property of the Alcan Iceland Ltd. and handed out for personal use only. It may neither be copied nor made available to others without permission of the Alcan Iceland Ltd. The receiver is liable for any misuse.

Fjöldi stykja Number of pieces	Hlutur Object	Atriði Item	Efni Material	ea:stk Weight	total: í heild (kg) Eyrsg.	Almátt. Remarks
IV III II I	SKRIFSTOFUHÚS ALCAN	Mhl. 94				
	GRUNNMYND 3.HÆÐAR					
	HREINLÆTISLAGNIR					
	Varkau / Supplier	VGK CONSULTING ENGINEERS LTD.				
	Teknað Drawn	ÓS	Virfarið Checked			
	ALCAN PRIMARY METAL EUROPE					
	ISAL					
	Teknað Drawn		Virfarið og sítt Checked and filed			

Step  
Format A1  
Scale 1:50  
Kostnaður / Cost  
4110  
AKS No.  
01199  
Tæknir. veldi / Drawn of suppl.  
UM10  
9K-68  
2

Drwn. of ISAL / Teknir. ISAL  
168830  
2