Format A1 (841x594 mm) is 20 mm outside of this frame

SÉRMYNDIR - BRUNNAR

1:20

FRÁRENNSLISBRUNNUR DN1000 - BR6

DN1000, STEINSTEYPTUR MEÐ STEYPUJÁRNSLOKI

1:20

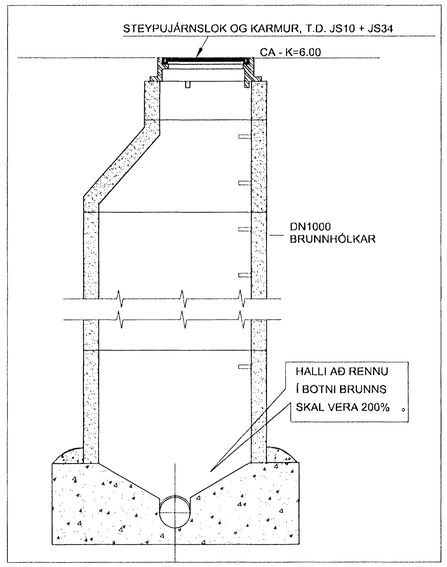

REGNVATNSBRUNNUR BR2 OG BR8

DN600, ÚR PLASTI MEÐ STEYPUJÁRNSLOKI OG SANDFANGI

1:20

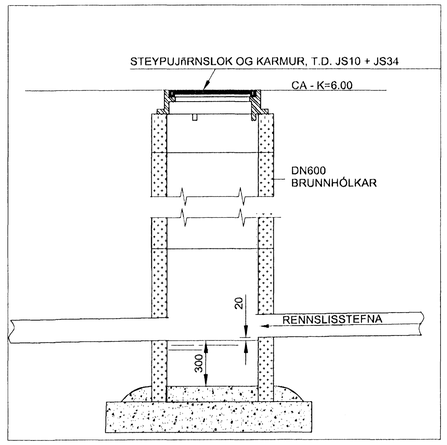

FRÁRENNSLISBRUNNUR BR3, BR4, BR5 OG BR7

DN1000, ÚR PLASTI MEÐ STEYPUJÁRNSLOKI

1:20

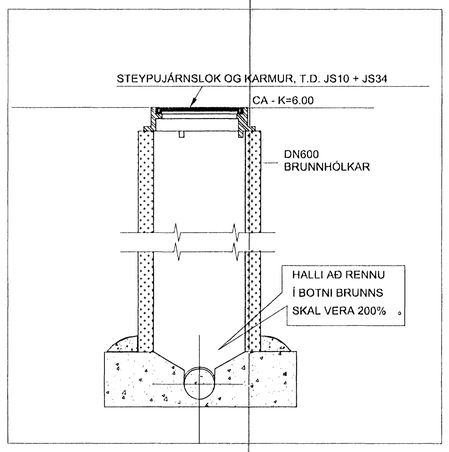

VATNSLÁSBRUNNUR - BR1

DN600, STEINSTEYPTUR MEÐ STEYPUJÁRNSLOKI OG SANDFANGI

1:20

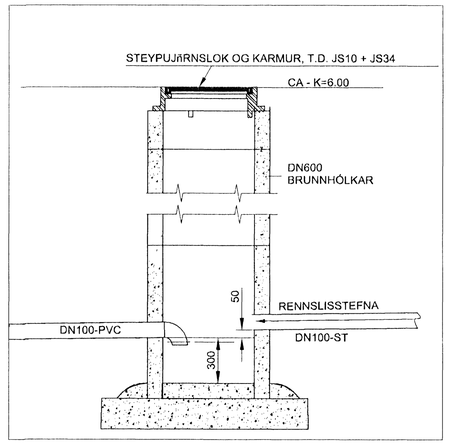

Skýringar:
Explanations:

Breyt. Rev.	Breyting Revision	Dags. Date	Samþ. Approved	Nótk. heimil. Released
3	EFTIR FRAMKVÆMD	28.09.04	ÓS.	
2	BRUNNI 5 BREYTT	17.10.'03	ÓS	
1	VINNUTEIKNING	09.09.'03	RK.	

Tilv.teikningar nr. ISAL / Ref.drawing no. of ISAL

Samsetn.teikningar nr. ISAL / Assembly drawing no. of ISAL

VGK Verkfræðistofa

This drawing is the property of the Alcon Iceland Ltd. and handed out for personal use only. It may neither be copied nor made available to others without permission of the Alcon Iceland Ltd. The receiver is liable for any misuse.

Fjöldi stykkja / Number of pieces: IV | III | II | I

Hlutur / Object	Atriði / Item	Efni / Material	ea.:stk. / Weight	total:í heild (kg) Þyngd	Athugasemdir / Remarks

SKRIFSTOFUHÚS ALCAN — Mhl. 94

SÉRMYNDIR–BRUNNAR

FRÁRENNSLISLAGNIR — Mhuyfsa 3

Stærð / Format: A1 — Mkv. / Scale: 1:20

Kostn.nr.-búnr.nr. / COno.-Eq.no.: 4110 01199

AKS no.: UM10

Verktaki / Supplier: VGK CONSULTING ENGINEERS LTD.

Teikn.nr. verktaka / Drw.no. of suppl.: 10K–20 — Breyt./Rev.: 3

Teiknað / Drawn: ÓS — Yfirfarið / Checked

Samþykkt / Approved

ALCAN PRIMARY METAL EUROPE
ISAL
Alcan Iceland Ltd
Straumsvík
IS-222 Hafnarfjörður

Drw.no. of ISAL / Teikn.nr. ISAL: 168833 — Breyt./Rev.: 3

Teiknað / Drawn — Yfirfarið og skráð / Checked and filed

Notkun heimiluð / Released

01 JUNE 2005