


A
9K-77
9K-78
1:20

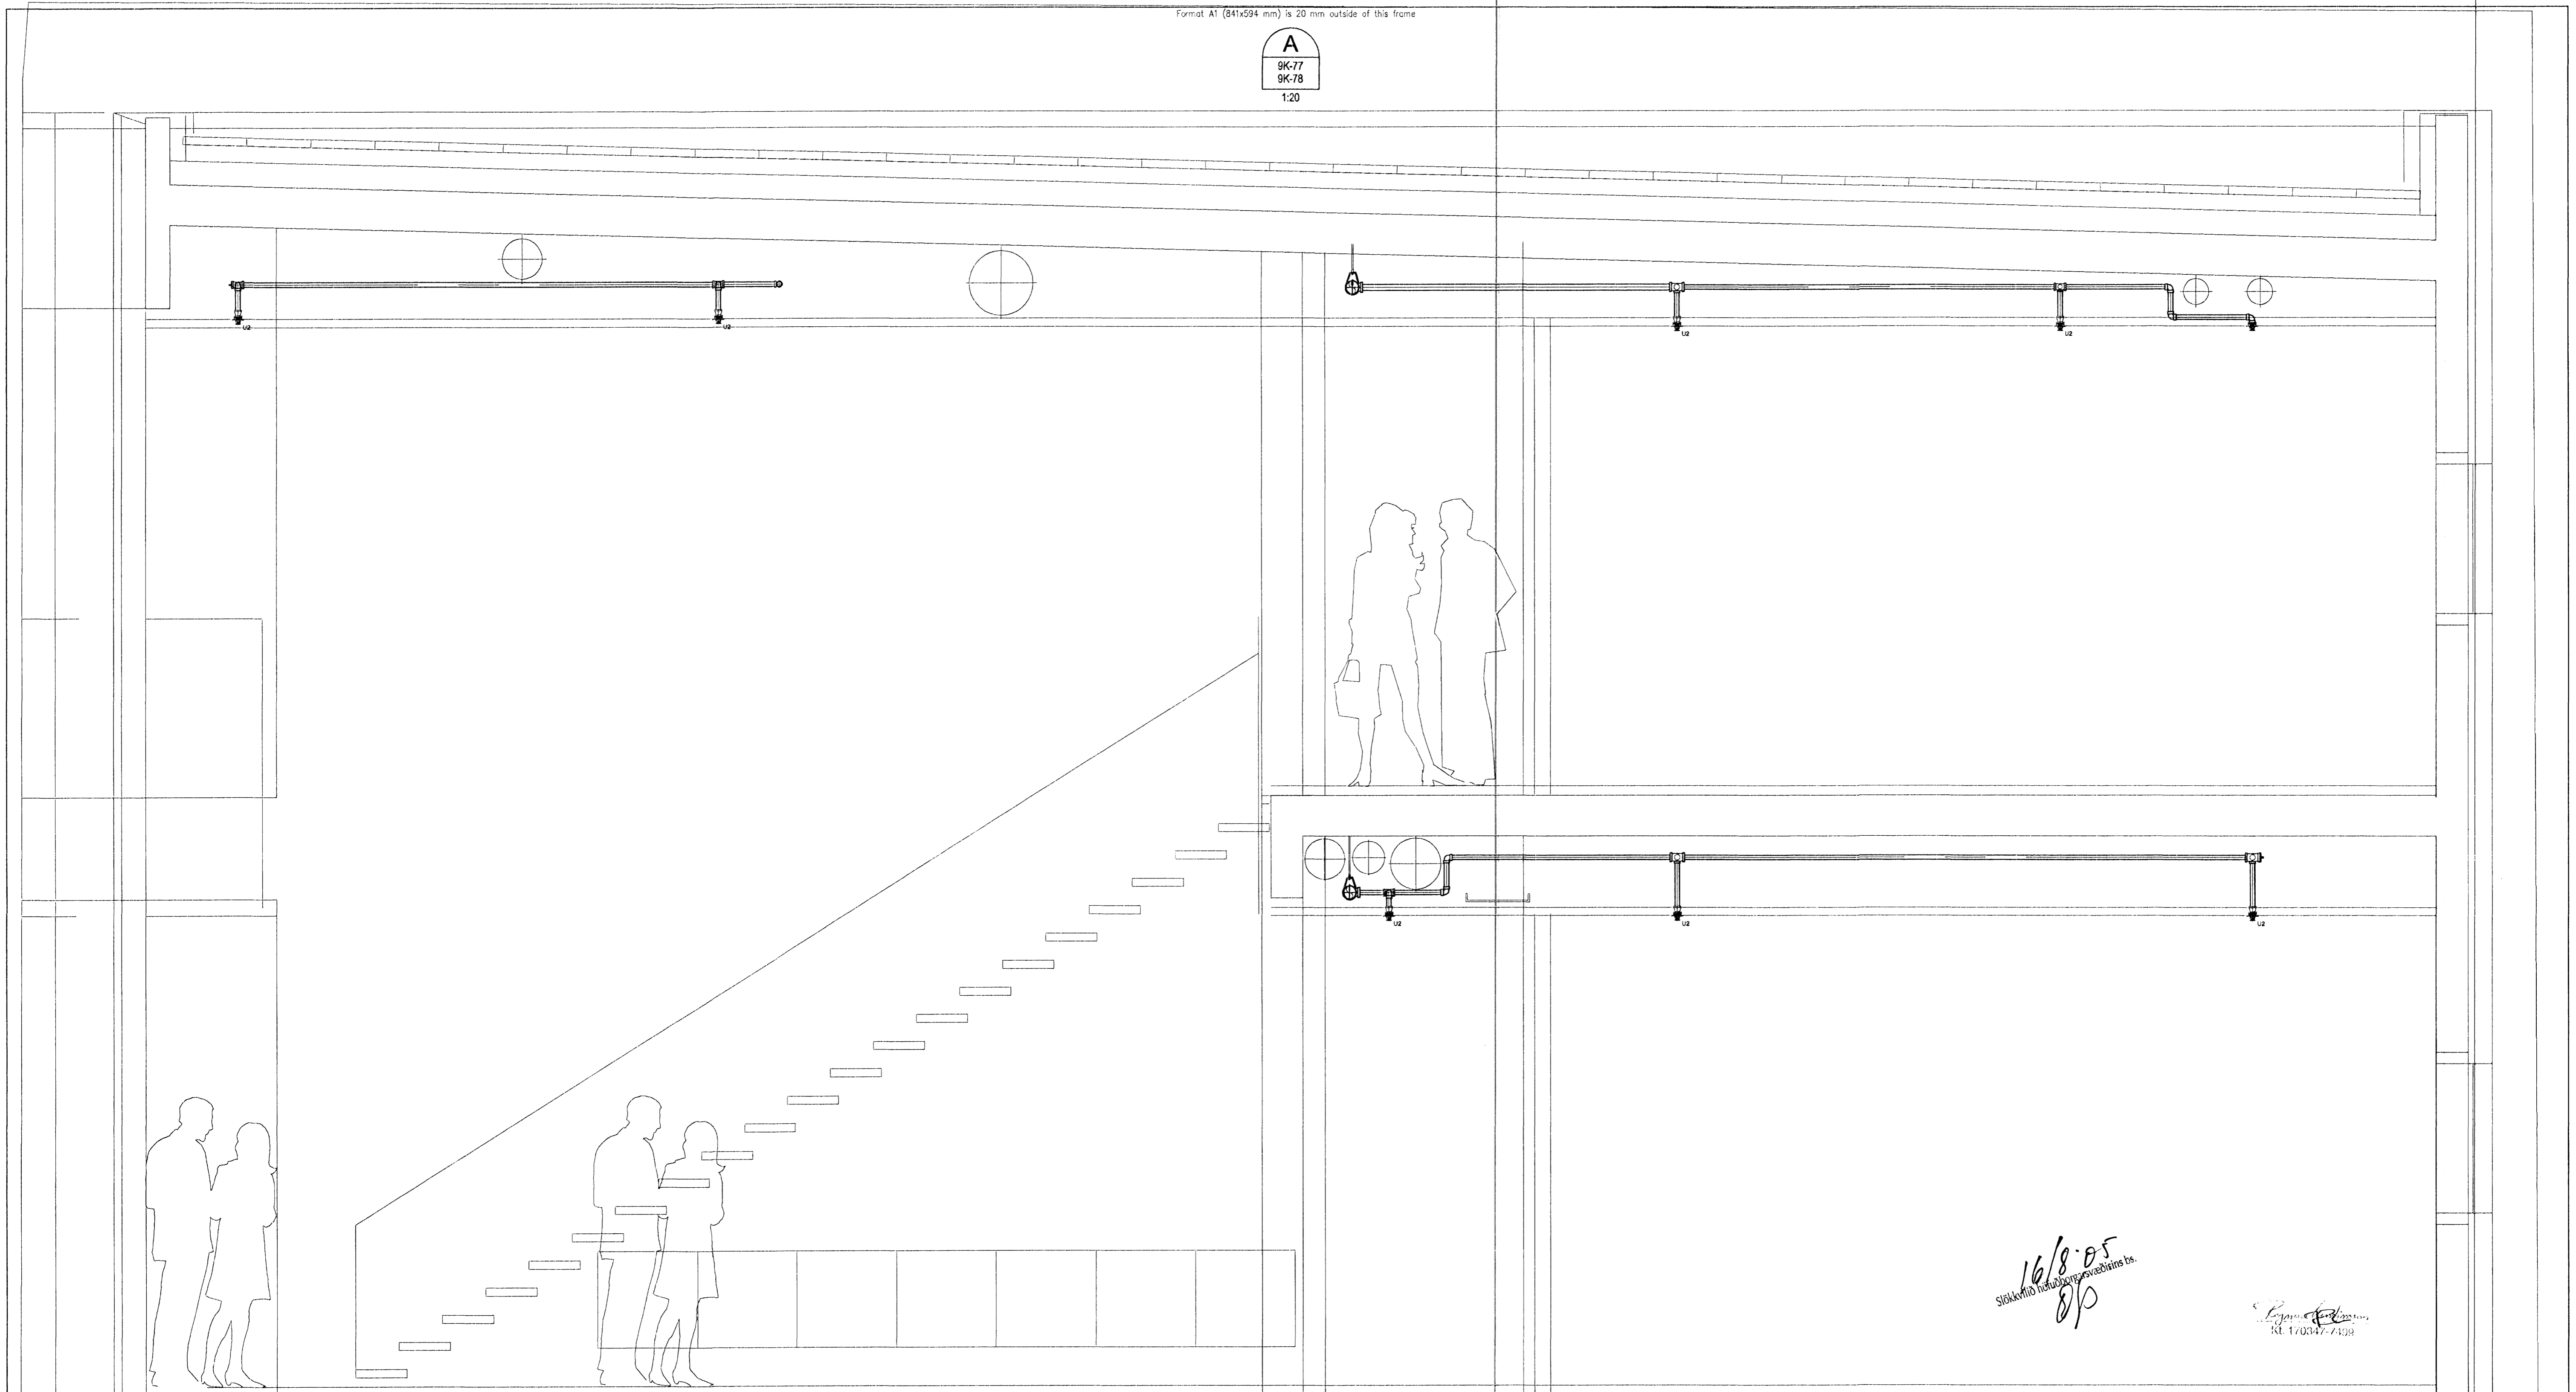

16/8-05
8/0

Byggingafráttir
Alfreitt Þann
18 AUG 2005

SKÝRINGAR

- U₁ = Uppvísandi Quick response úðari, K=80, DN15, messing dreifiplata 100-150 mm frá lofti
- U₂ = Hálfínfeldur niðurvísandi Quick Response úðari K=80, DN15, krómaður með krómaðri rósettu
- U₃ = Hálfínfeldur Quick response hlóðarúðari, K=80, DN15, krómaður með krómaðri rósettu
- U₄ = Niðurvísandi Quick response úðari, K=80, DN15, messing dreifiplata 100-150 mm frá lofti
- U₅ = Hálfínfeldur niðurvísandi Quick response hlóðarúðari, K=80, DN15, krómaður með krómaðri rósettu
- * = Úðari yfir kerfisiotti

PU/PN = Pípa upp/niður
Allar ómálsettar pípur eru DN25
Nákvæm stöðsetning úðara, sjá loflátið arkitekta

Skýringar:
Explanations:

Breyt./Rev.	Daga/Date	Samb./Approved	Netk. heimil./Released
3	28.09.04	Slp.	
2	05.05.04	Slp.	
1	09.09.03	RK.	

This drawing is the property of the Alcan Iceland Ltd. and handed out for personal use only. It may neither be copied nor made available to others without permission of the Alcan Iceland Ltd. The receiver is liable for any misuse.

Fjöldi stykja/Number of pieces	Hútur/Objekt	Altrið/Item	Efni/Material	ea.stk/Weight	Ítalat./T. heild/Scale	Althugasemdir/Remarks
IV II I I	SKRIFSTOFUHÚS ALCAN	Mhl. 94			A1	1:20
	SNIDMYND A-A				4110	01199
	SLÖKKVIÐDALAGNIR				UM10	
	VGK CONSULTING ENGINEERS LTD.				10K-23	3
	ALCAN PRIMARY METAL EUROPE				168834	3