



V:\2008\06811\06811-Kaplakriki-FH\Sheet\FH\Smáspenna\06811-FH_Smáspenna-B.dwg

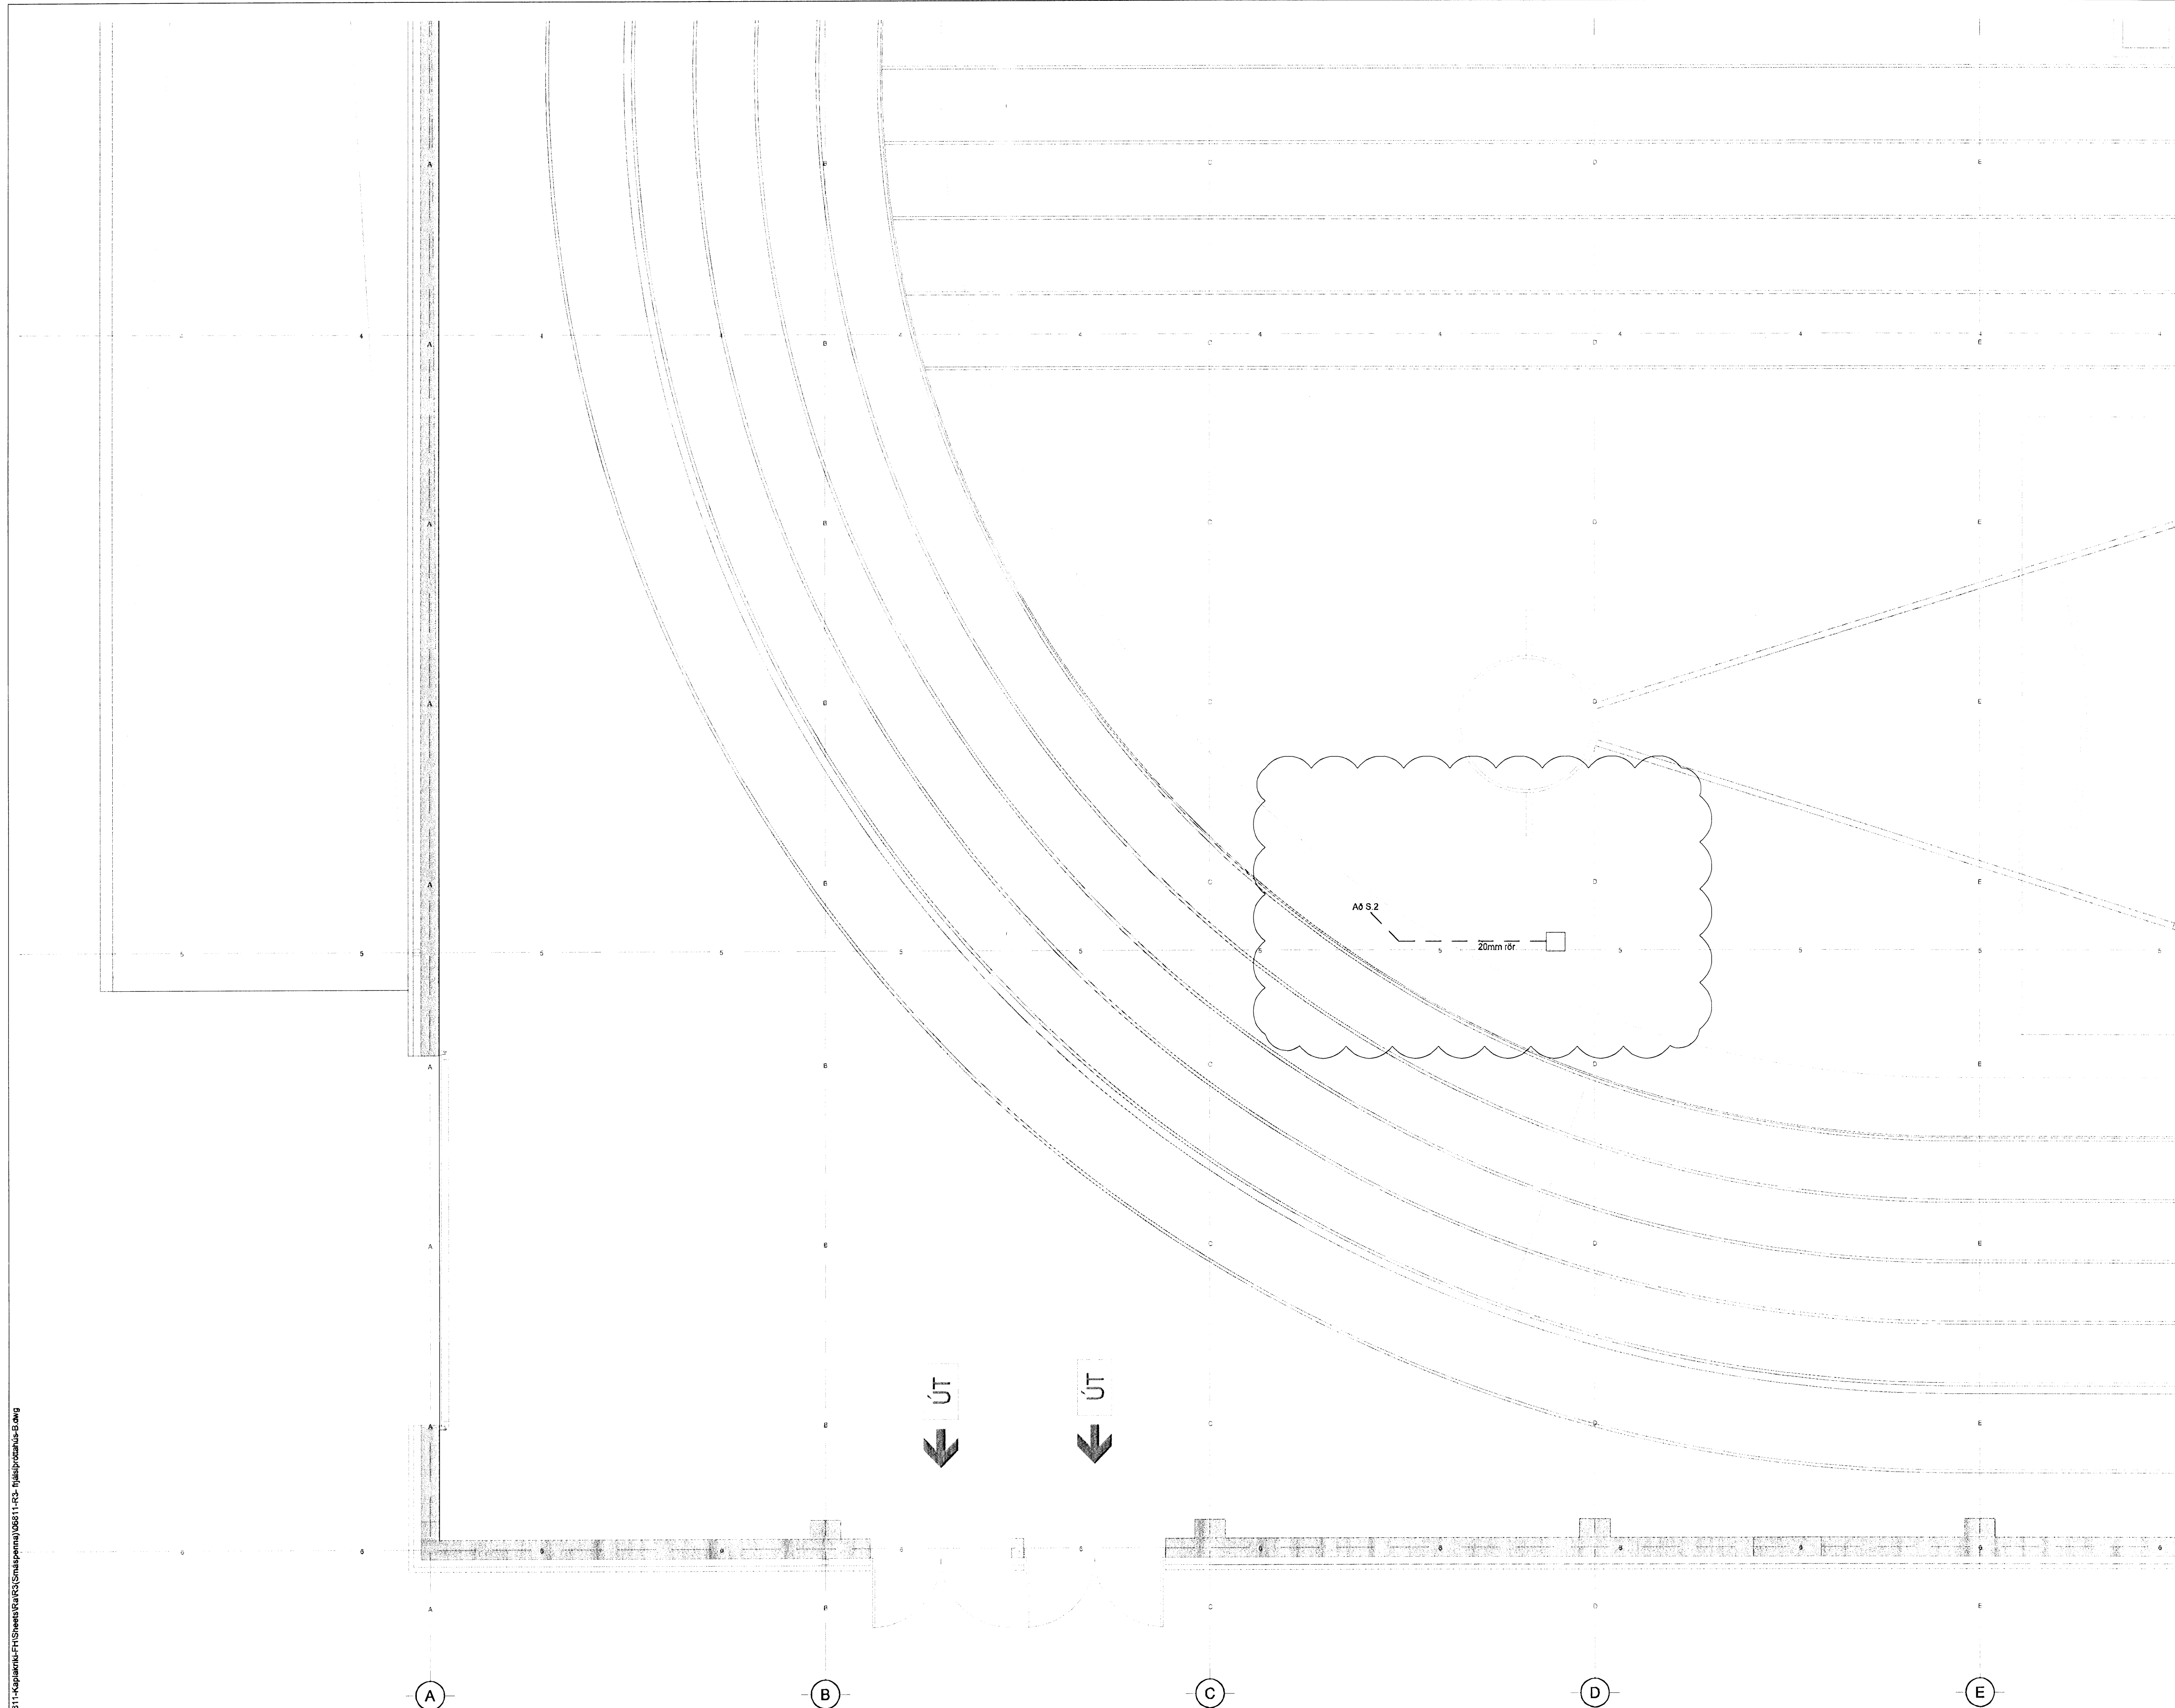

BATTERI
 0604
 25.08.08
 SÁMFER
 KRISTIN

KAPLAKRIKI

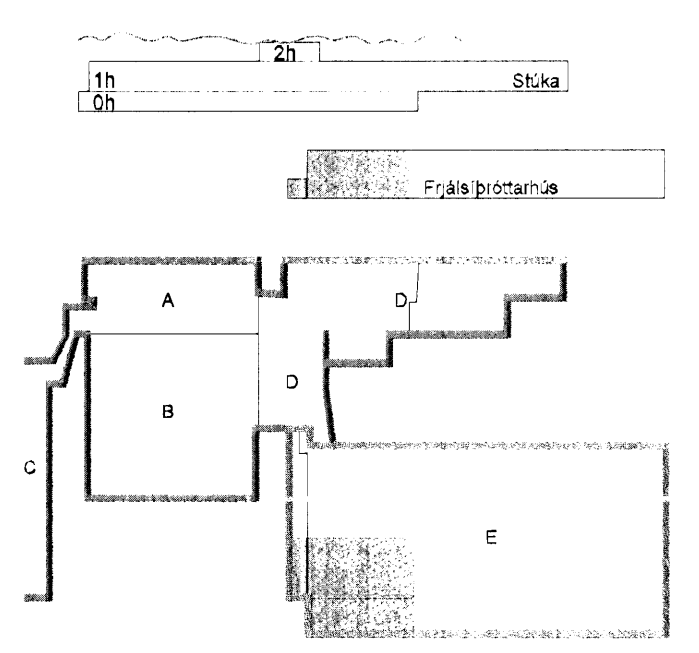

A. 17.09.08 Óskilds félag til SF/ÓG
 Útg. Dags. Skýring Hannasýrfraró



VERKFRÆÐISTOFA

BÆJARHRAUN 20 · 220 HAFNARFJÖRDUR · KENNIT. 710796-2899
 vsb@vsb.is · Sími 585 8600 · Fax 585 8610 · www.vsb.is

Áritun sérhönnuðar
 Örn Guðmundsson Kt: 220961 2739
 Verkefni
 KAPLAKRIKI
 HAFNARFIRÐI

Verkhúsi
 Rafkerfi
 Smáspenna frjálspípróttahús
 Grunnmynd

Hannað RVK/HJ	Teknað RVK/HJ	Yfirfarið ÓG	Kvarði 1:50	Síða / A1
Dags 18.03.2008	Verkefni 06811	Teikning B R304	Útgáfa A	