


Hröflur S. Gunnlaugsson
Kt. 110457-2789

KAPLAKRIKI

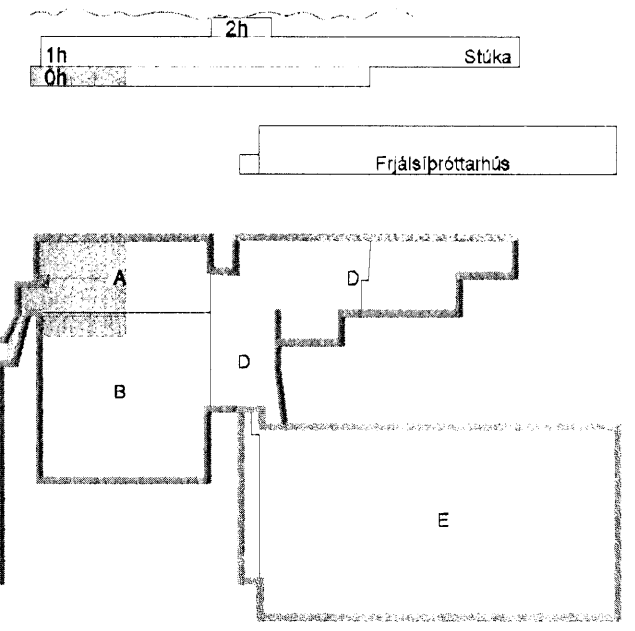

C	01.10.08	Breytingar á neyslúvatni	HG/KMJ/SÁS
B	28.05.08	Breyting vegna sturuklæfa o.fl.	KMJ/SÁS
A	23.11.07	Verktækning	KMJ/SÁS
Dig.	Dags	Skýring	Hanna Þ. Yfirfaró



VERKFRÆÐISTOFA

BÆJARHRAUN 20 · 220 HAFNARFJÖRÐUR · KENNIT. 710796-2899
vsb@vsb.is · Sími 585 8600 · Fax 585 8610 · www.vsb.is

Artun skýrsmunar
Sveinn Áki Sverrisson Kt. 230855 5609
Verkefni
KAPLAKRIKI
HAFNARFIRÐI

Verkefni			
Lagnir			
Neyslúvatns- og hitalagnir			
Grunnmynd kjallara			
Hanna	Teknað	Yfirfaró	Kvart.
KMJ	KMJ	SÁS	1:50
Dags	Verkefni	Tækning	/ A1
30.04.07	06811	A P201	Síða
			C

V:\00000511\06811-Kaplakriki-FHS\Sheets\A_P201.mxd.dwg