


Skýringar:
 Öll mál eru millimetrar [mm]
 Gatamerkingar:
 br. (breidd), hæð og lengd gats
 K=kóti neðri brúnar gats

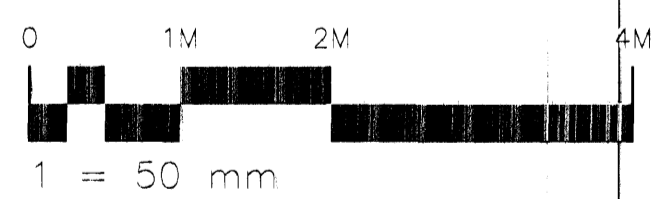

Alcan Iceland
 KILTONHEVU
 22.09.2003

Skýringar: Explanations:	This drawing is the property of the Alcan Iceland Ltd. and handed out for personal use only. It may neither be copied nor made available to others without permission of the Alcan Iceland Ltd. The receiver is liable for any misuse.	Fjöldi stúkkja Number of pieces IV III II I	Hlutur Object Mhl.01 Víkurgata 3 / ál- og tækjageymsla Burðarbol – gataplán Grunnmynd 1.hæð	Atrúð Item SG	Efnir Material SG	Eignastik Weight SG	Stærð Size A1	Mál Scale 1:50	Athugasemdir Remarks
A Reyndartekningar 3 Bætt við götum vegna ratiafagna og loftfresingu 2 Göt í línu S-N bætt við 1 Gólfhæð og hæð á götum hækkað	Dags. Date 05.07.05 26-02-04 15-12-03 8-12-03	Samþ. Approved SG SG SG	Tæknir. / Verkt. / No. of suppl. / Ref. No. 7510 12094 US33	Tæknir. / Verkt. / No. of suppl. / Ref. No. 168915 A					
Brætt. Rev. Tæknir. / Verkt. / No. of suppl. / Ref. No. ISAL Alcan Iceland Ltd	Bræyting Revision Sameiðn. teikningar nr. ISAL Assembly drawing no. of ISAL	Dags. Date 22.09.2003	Tæknir. / Verkt. / No. of suppl. / Ref. No. 168915 A	Tæknir. / Verkt. / No. of suppl. / Ref. No. 168915 A					