


HEILBRIGÐISEFTIRLIT
HAFNARFIJARDAR-
OG KÓPAVOGSSVÆÐIS
Gardatorgi 7 - 200 Gardaby
27.11.05 *[Signature]*

ÞAKNIÐURFÖLL SJÁ TEIKNINGAR ARKITEKTA

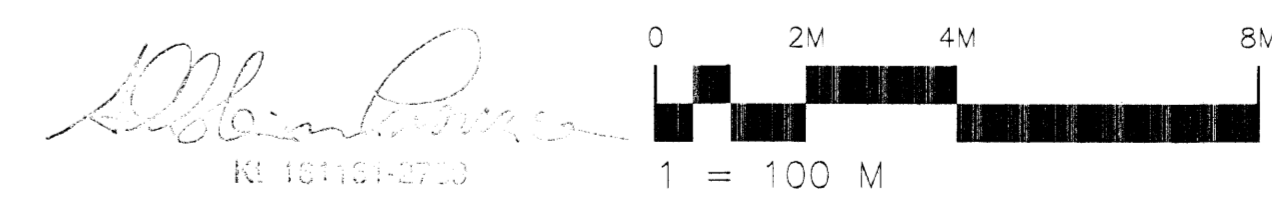

Skýringar:
Explanations:

Breyt. / Rev.	Breyting / Revision	Dagur / Date	Samp. / Approved	Nök. / Noted	hæmt. / Released
A	Reyndartekningar	05.07.05	SG		
3	Vaskur ferður á snyrtingu karla 1.hæð	06-12-04	SG		
2	Hæðalínur í tækjageymslu	4-5-04	SG		
1	Ólífhæð og hæð á lögnum hækkað	8-12-03	SG		

The teikningar nr. ISAL
Redrawing no. of ISAL

Samsettn.teikningar nr. ISAL
Assembly drawing no. of ISAL

Fjöldi stúkkja / Number of pieces	Hútur / Object	Attriði / Item	Efni / Material	æð. / Weight	Ítalátt / Total	Althugsamerki / Remarks
IV	Mhl.01 Víkurgata 3 / ál- og tækjageymsla				7510	
	Lagnir - Frárennslí 1.hæð				12094	
	Grunnmynd 1/3				US33	
	Strendingur ehf. verkfræðipjónusta				301	
	ALCAN PRIMARY METAL EUROPE				168917	

This drawing is the property of the Alcan Iceland Ltd. and handed out for personal use only. It may neither be copied nor made available to others without permission of the Alcan Iceland Ltd. The receiver is liable for any misuse.

Stað. / Scale: A1
Másk. / Max. Scale: 1:100
Kostnaður / Cost: 7510
AKS númer / AKS No.: 12094
Tækn. / Drawn: JW
Prófað / Checked: SG
Dagur / Date: 22.09.2003
Tækn. / Drawn: ISAL
Prófað / Checked: SG
Dagur / Date: 22.09.2003
Tækn. / Drawn: ISAL
Prófað / Checked: SG
Dagur / Date: 22.09.2003