
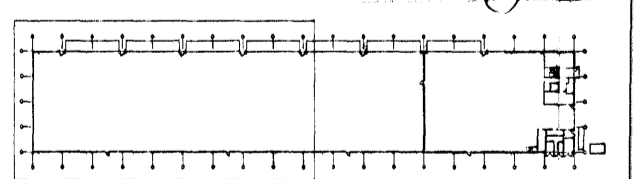


HEILBRIGÐISEFTIRLIT
HAFNARFIARÐAR-
OG KÓPAVOGSSVÆÐIS
Gardatorgi / - 200 Gardabý
24.05.2005 *[Signature]*

ÞAKNIÐURFÖLL SJÁ TEIKNINGAR ARKITEKTA

[Signature]
NL101101-27.10

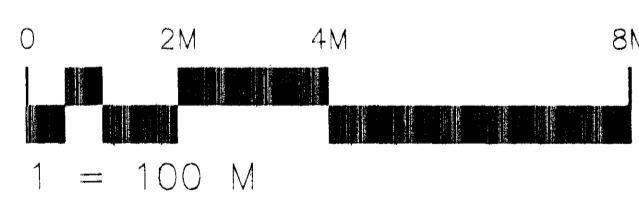

Skýringar:
Explanations:

Tilvit. teikning nr. ISAL Ref. drawing no. of ISAL	Breyt. Rev.	Dags. Date	Samþ. Approved	Notk. heiml. Released
A	Reyndartekningar	05.07.05	SG	
1	Gólfhæð og hæð lögnum hækkað	8-12-03	SG	

This drawing is the property of the Alcan Iceland Ltd. and handed out for personal use only. It may neither be copied nor made available to others without permission of the Alcan Iceland Ltd. The receiver is liable for any misuse.

Fjöldi stykja Number of pieces	Hlutur Object	Atriði Item	Efni Material	Þyngd Weight (kg)	Stærð Size	Althugsamir Remarks
IV III II I	Mhl.01 Víkurgata 3 / Ól- og tækjageymsla				A1	
	Lagnir - Frárennslí 1.hæð			7510	12094	
	Grunnmynd 2/3			US33		
	Strendingur ehf. verkfræðipjónusta			302	A	
	ISAL					
	ALCAN PRIMARY METAL EUROPE					
	IS-222 Hafnarfordur					
	168918				A	