



Mótteldi
13.09.2010

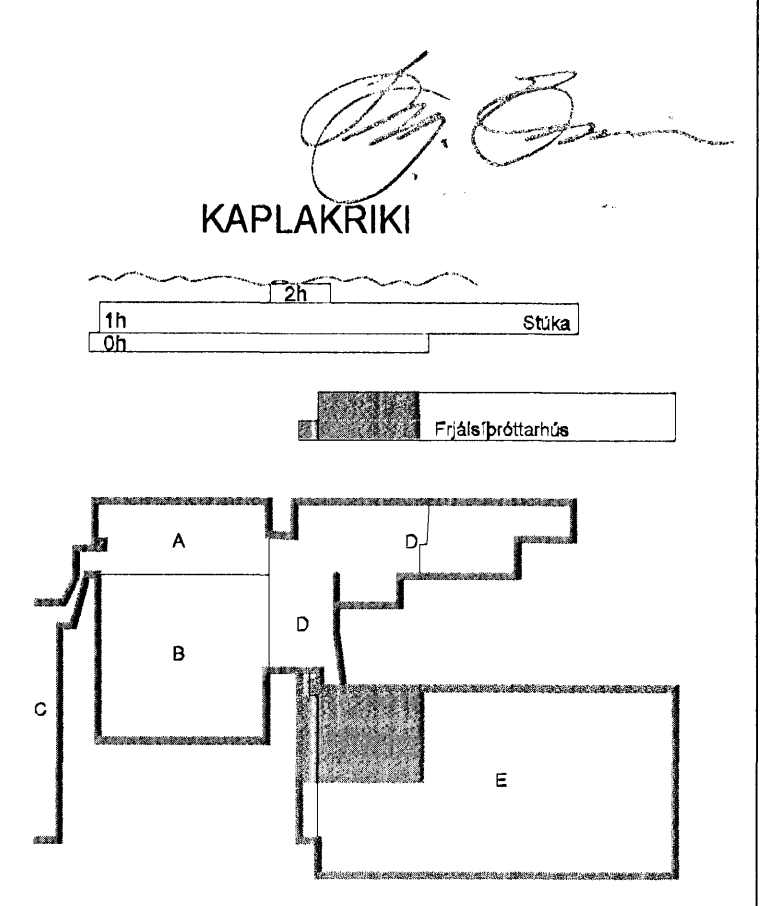

A 02.09.10 NL BSG:OG
Útg. Dags. Skýring Hannabryfirar

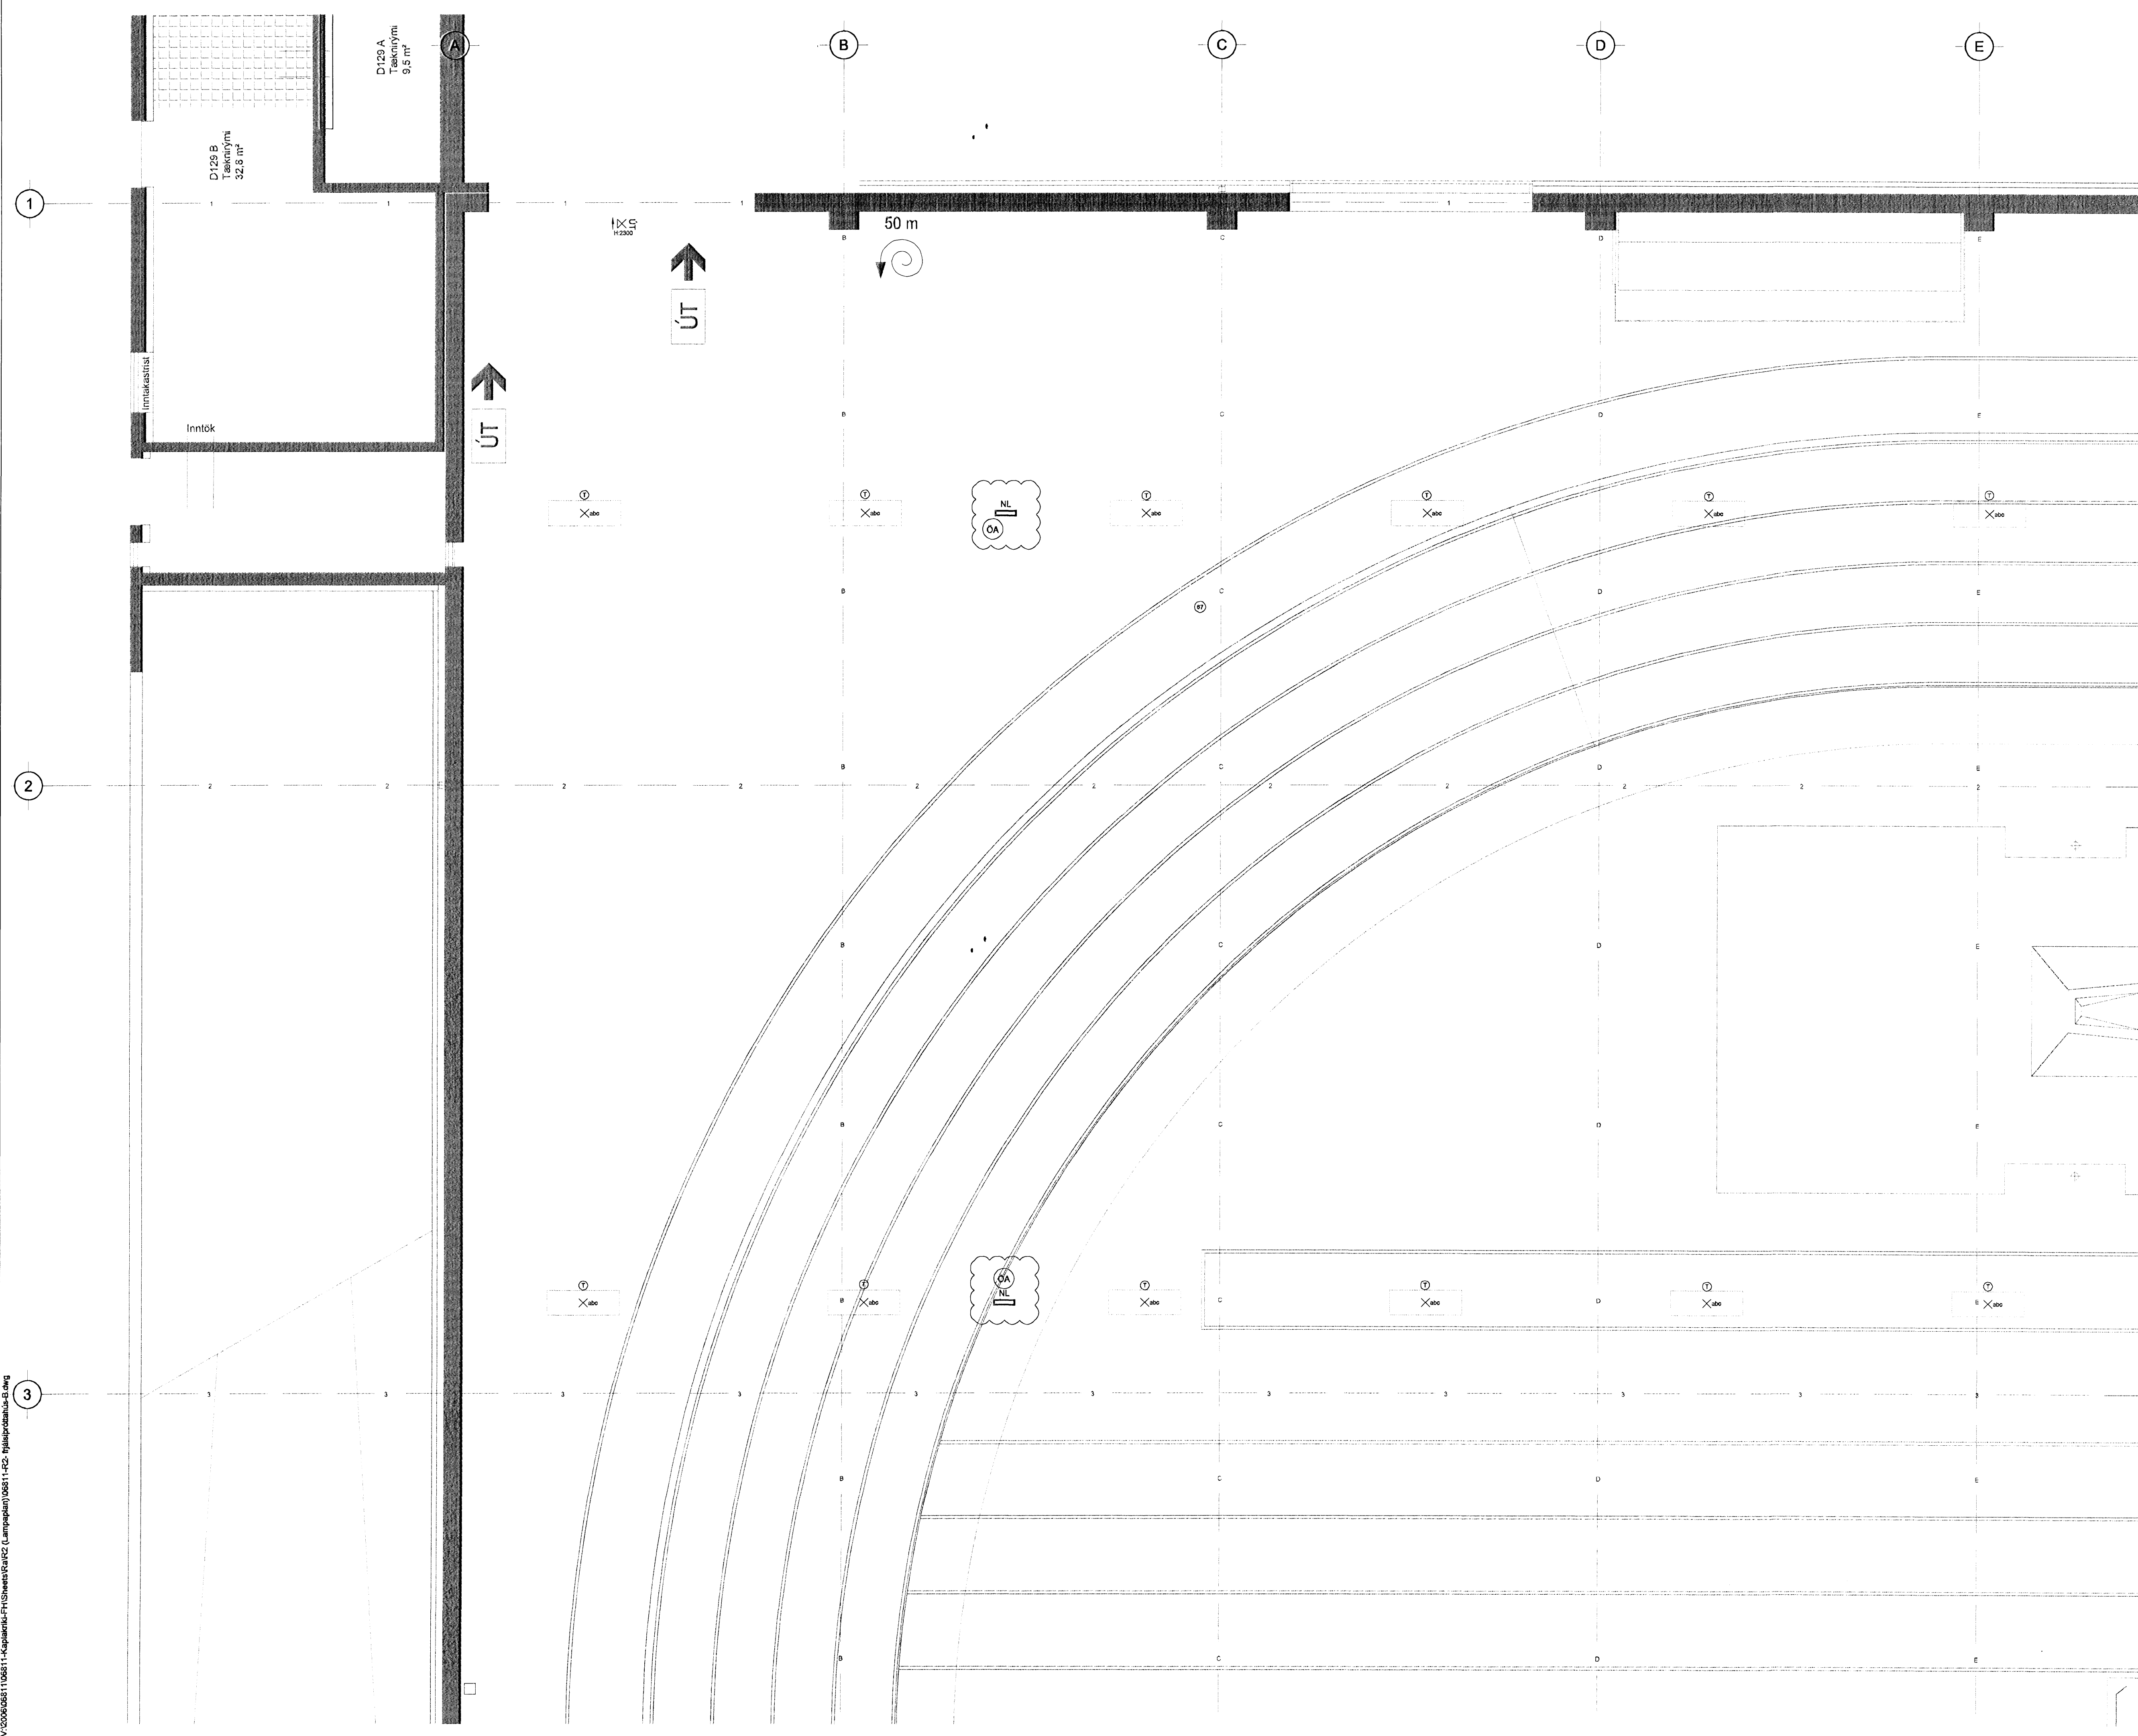

BÆJARHRAUN 20 · 220 HAFNARFJÖRDUR · KENNIT. 710709-2899
vab@vab.is · Sími 585 8600 · Fax 585 8910 · www.vab.is

Aritun séðhönnuðar Örn Guðmundsson Kt: 220961 2739					
Verkefni KAPLAKRIKI HAFNARFIRÐI					
Verkipti Rafkerfi Lampaplan frjálsspróttahús Grunnmynd					
Hannabryfirar	Teknað	Yfirfarð	Kvarði	Síða	
RVK/HJ	RVK/HJ	ÖG	1.50	/A1	-
Dags.	Verkefni	Tekning	Útgáfa		
18.03.2008	06811	B R201	A		

V:\2009\06811\06811-Kaplakriki-FH\Sheets\KRIK2 (Lampaplan)\06811-02-Þjálpspróttahús-03.dwg