

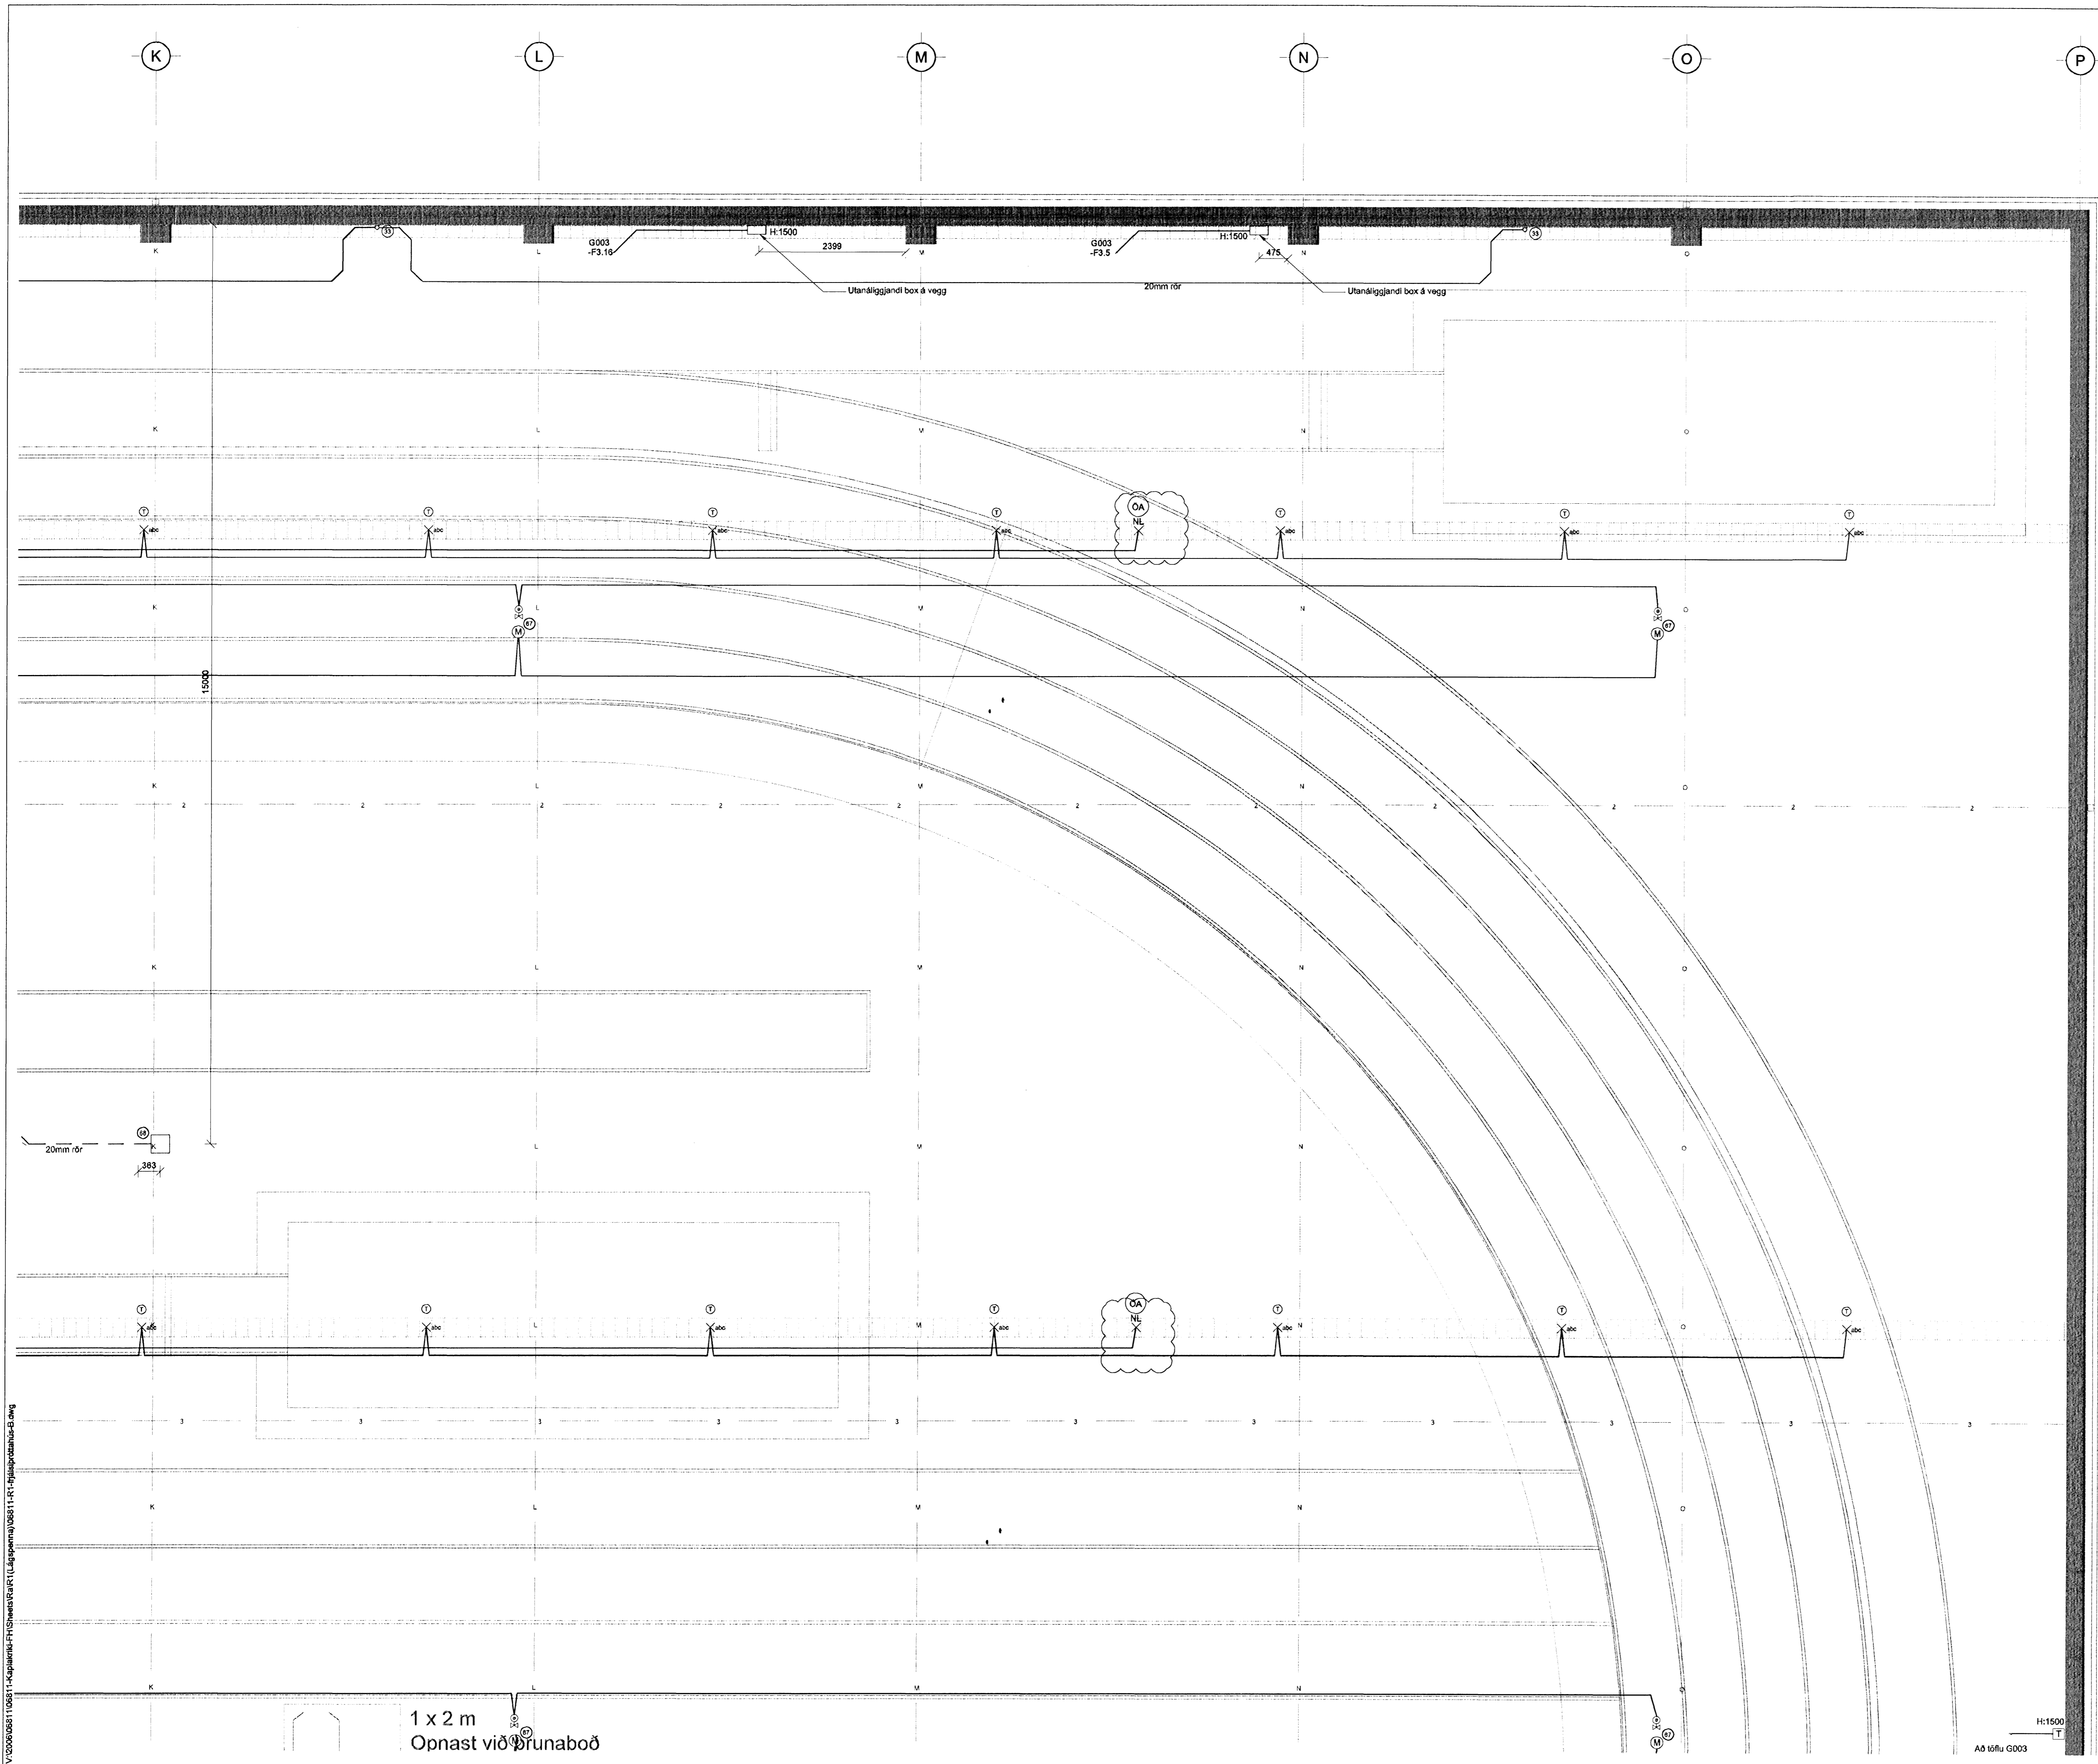


Mótteld  
13.09.2010

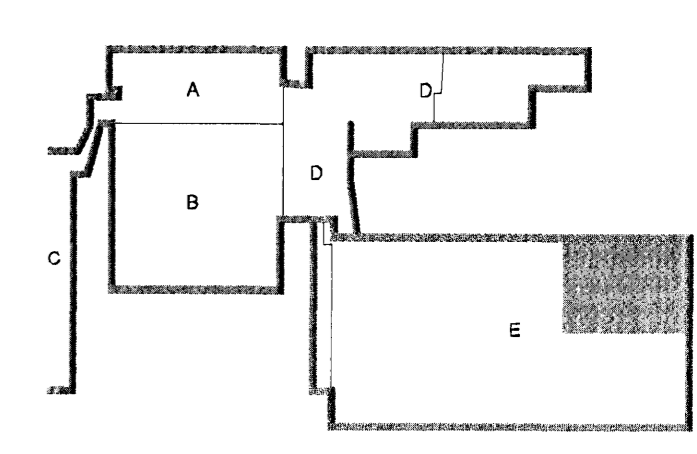

KAPLAKRIKI

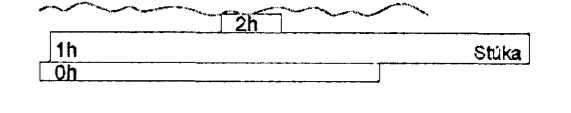

D	02.09.10	NL	BSG/ÓG
C	05.11.09	Box flæði til	BSG/ÓG
B	13.10.09	Gólfbox máisset	BSG/ÓG
A	17.09.08	Ný gólfslas	SF/ÓG
Útg.	Dags.	Skýring	Hannabryfirfarð



VERKFRÆÐISTOFA

BÆJARHRAUN 20 · 220 HAFNARFJÖRÐUR · KENNIT. 710798-2899  
 vsb@vab.is · Sími 595 8600 · Fax 595 8610 · www.vsb.is

Áritun sérhönnuðar Óm Guðmundsson Kt: 220981 2739					
Verkefni KAPLAKRIKI HAFNARFIRÐI					
Verkefni Rakkerfi Lágspenna frjálspróttahús Grunnmynd					
Hannabryfirfarð	Tasknað	Yfirfarð	Kvartí	/A1	Síða
Dags.	Verkefni	Taskning	Taskning	Útgáfa	
18.03.2008	06811	BR103	D		


1 x 2 m  
Opnast við Brunaboð