


Samþykkt þann
 21 OCT 2009
 Byggingarfulltrúinn (Fafnir 31)
 F.h. Sigurður Steinar Jónsson

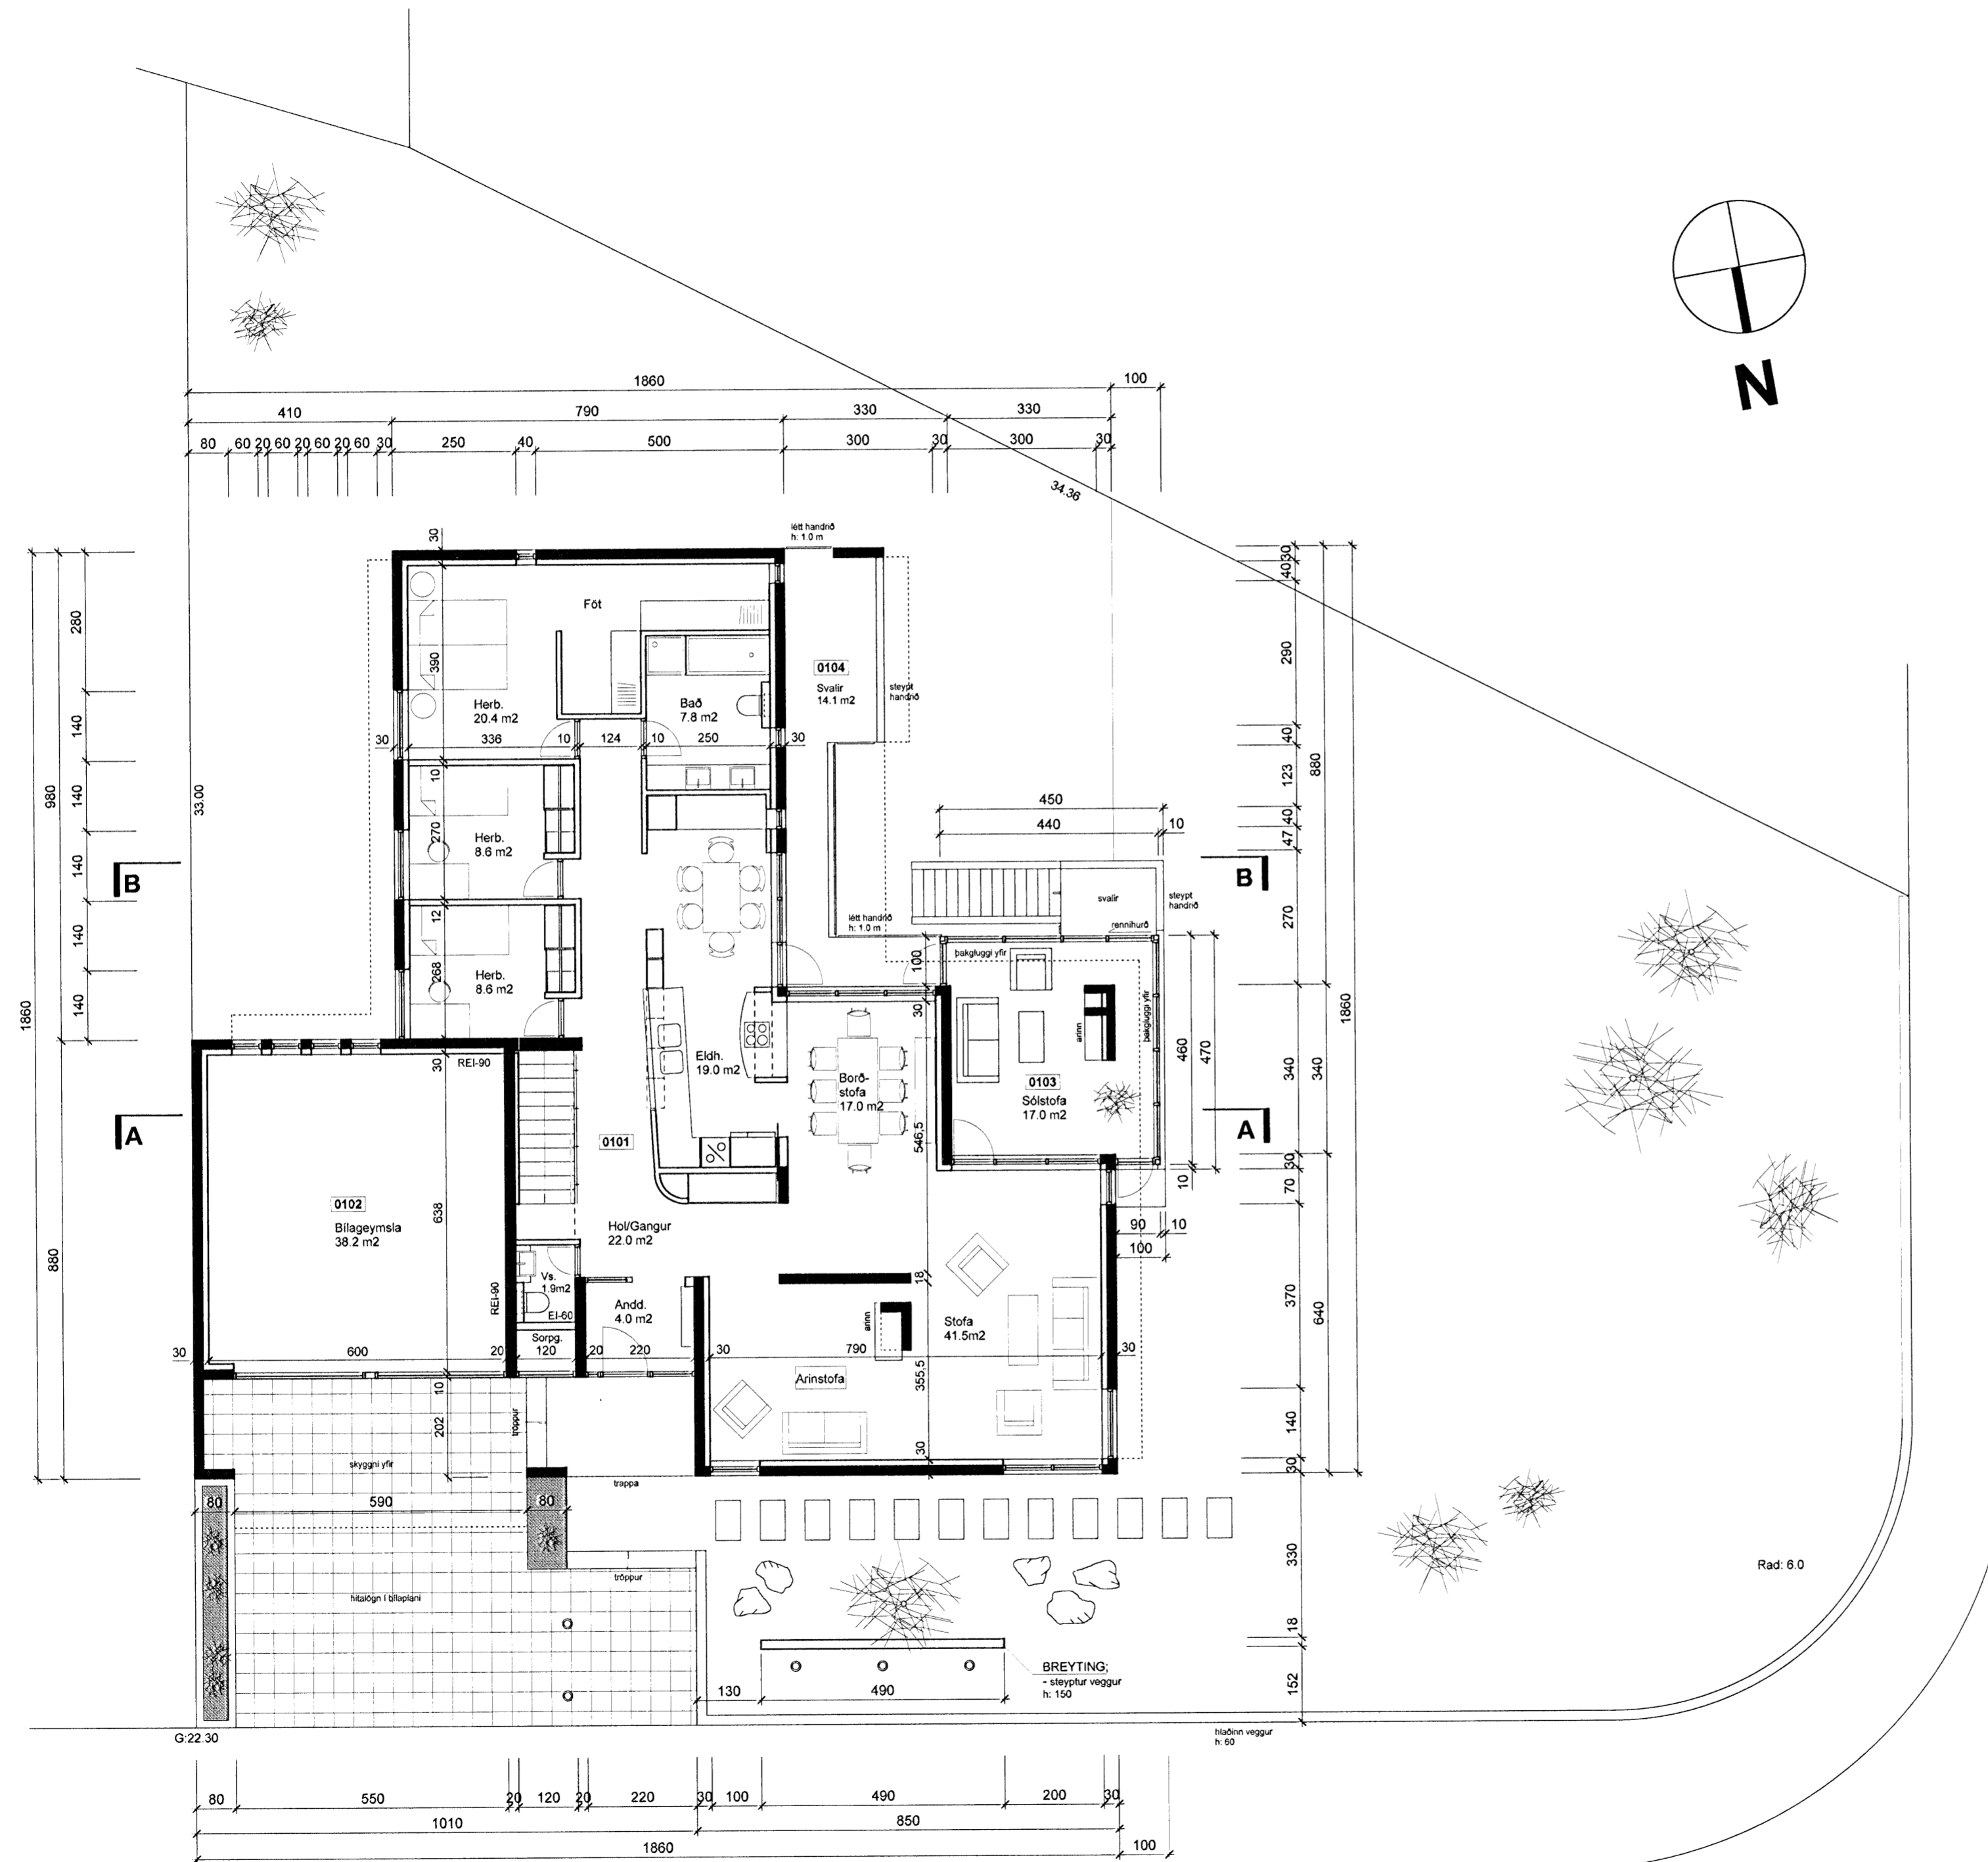

GRUNNMYND 1:100
 - Efri hæð

MÍÐVANGUR 5 HAFNARFJÖRÐUR

Aðaluppdráttur :

1.02

Grunnmynd efri hæðar

Dags.10.9.09

M.kv: 1 : 100

Gunnar Páll Kristjánsson

Gunnar Páll Kristjánsson arkitekt
 RÝMA ARKITEKTAR Borgartún 6, 105 Reykjavík kt: 260665-3679
 sími: 552 9515 gsm: 698 5665 netfang: gunnarpall@internet.is