


GRUNNMYND 1 HÆÐAR 1:50

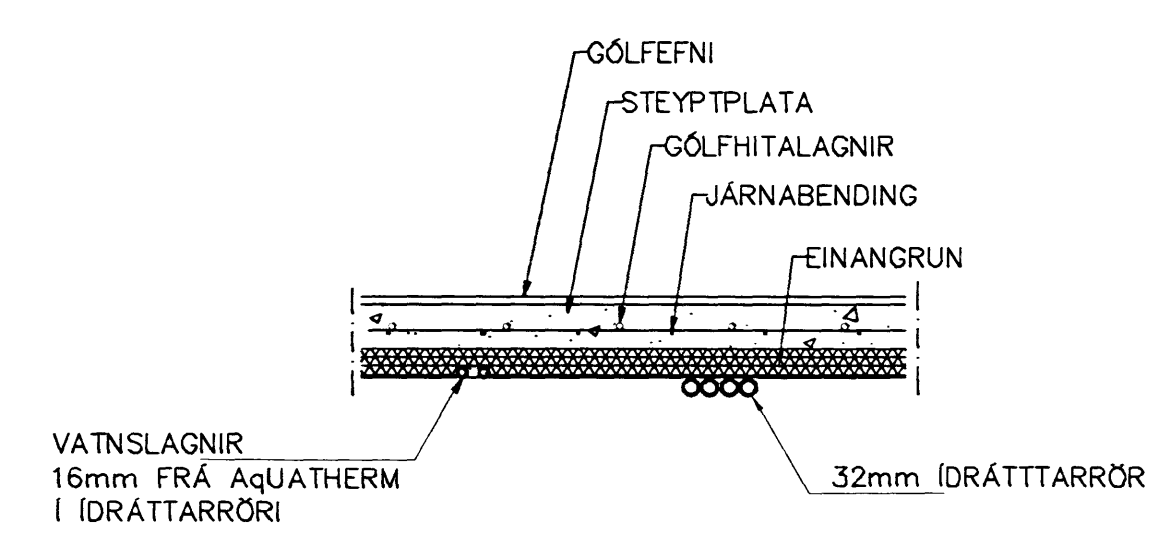

LAGNIR, SNID, 1:20

GÓLFHITALAGNIR
 16x2.0 Pe-PEX c/c100 OG 200
 SJÁ SNID

1	27/7/2010	breytt lega lagna	sp
Br.	Dags.	Eðli breytinga	Sign
FURUÁS 19-21 HAFNARFIRÐI GÓLFHITALAGNIR 1 HÆÐAR			
MKV. 1:50 1:20			
DAGS. APRIL 2008			
VERK NR. 2724			
TEIKN. NR. 2-04			
HANNAD SIG. ÞORLEIFSS. KT. 241148-3009			
TEIKNAD G.H.			
YFIRFARIÐ			
TEKNIÞJÓNUSTA SIGURDAR ÞORLEIFSSONAR ehf STRANDGÖTU 11 220 HAFNARFIRÐI Sími 855-4295 FAX 855-2675 E-mail tekh@tshnet.is kt: 440853-2530			

Handwritten signature