
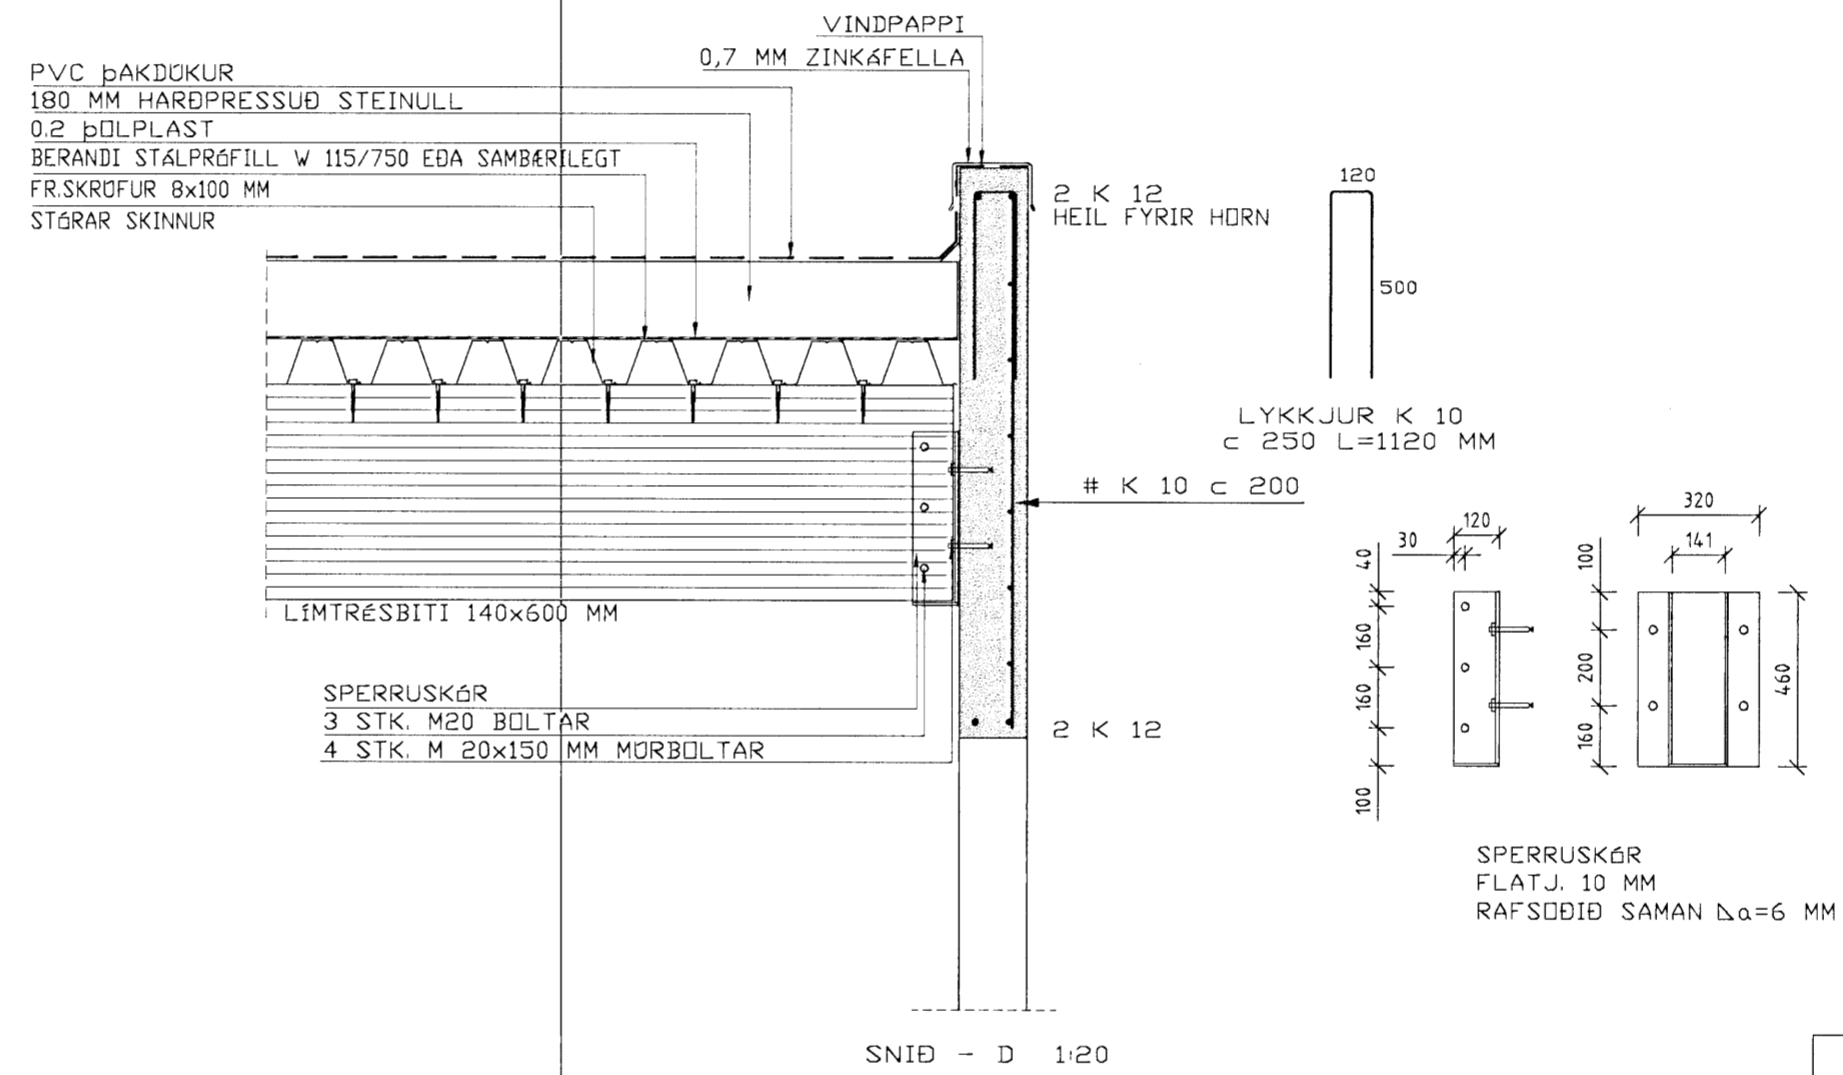


Handwritten mark

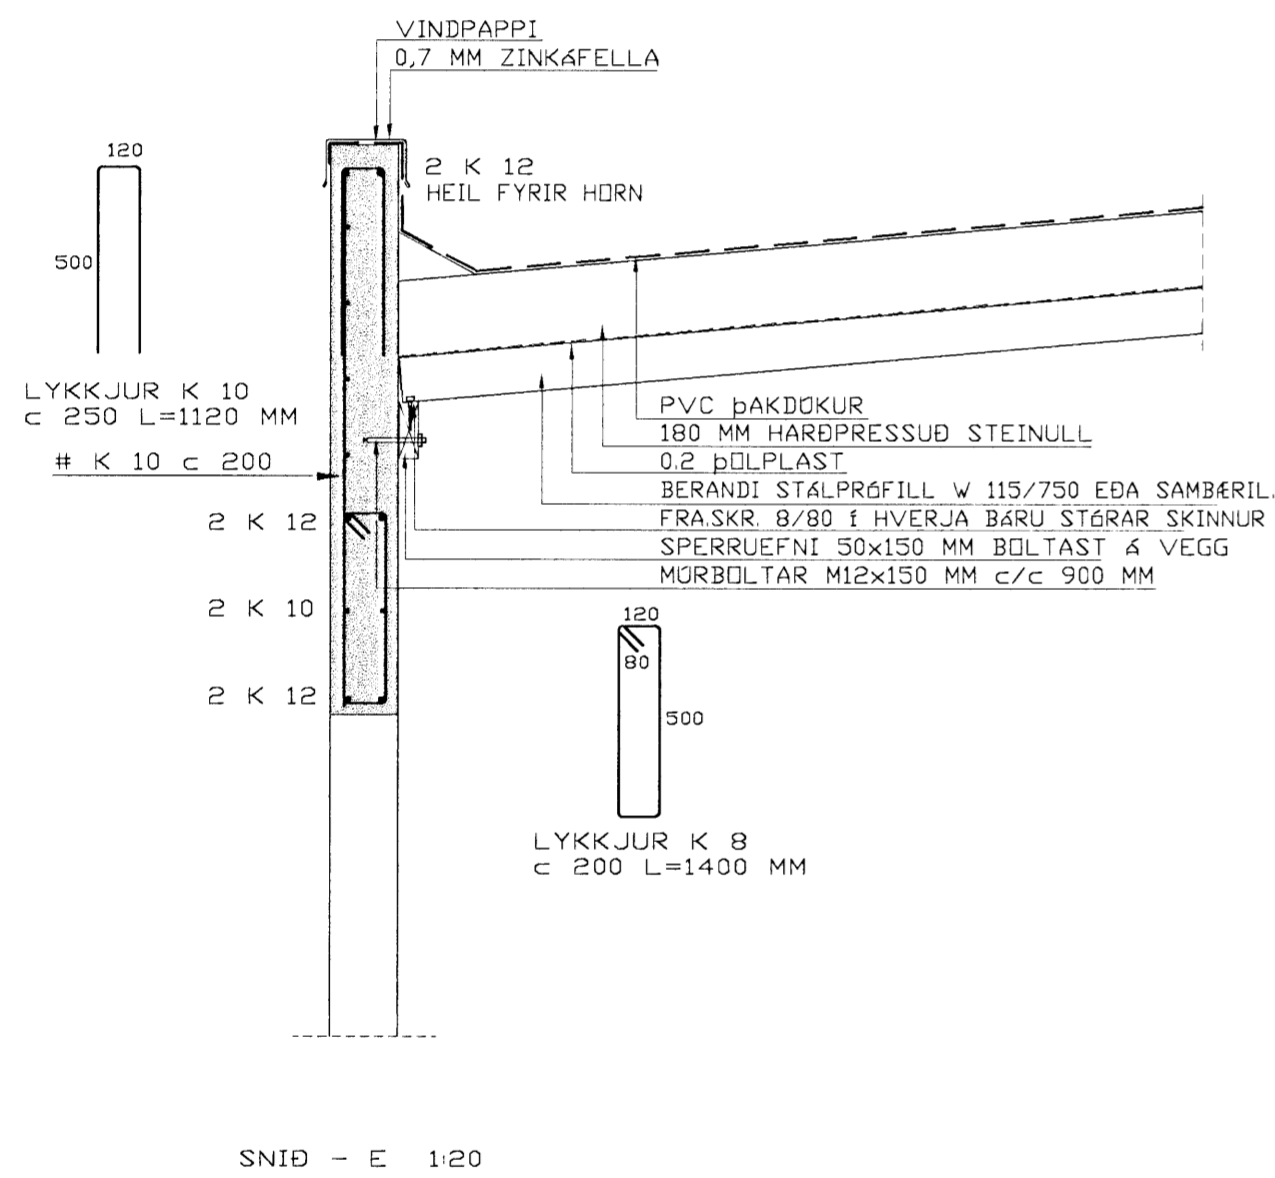

Breytingar		
A	júní, 2008	snidum breytt

ÁLFHELLA NR.13, HAFNARFIRÐI

HERMANN ISEBARN MFI
 TEIKNISTOFA SUDURLANDSBRÁUT 48
 s 5887544 kt 050244-4319 netfang his@simnet.is

Mál	120	ÞAKBITAR OG VEGGIR
Dags.	feb. 2008	SNID
Blad	10	
Yfirfarid		
Hannad	<i>Handwritten signature</i>	