
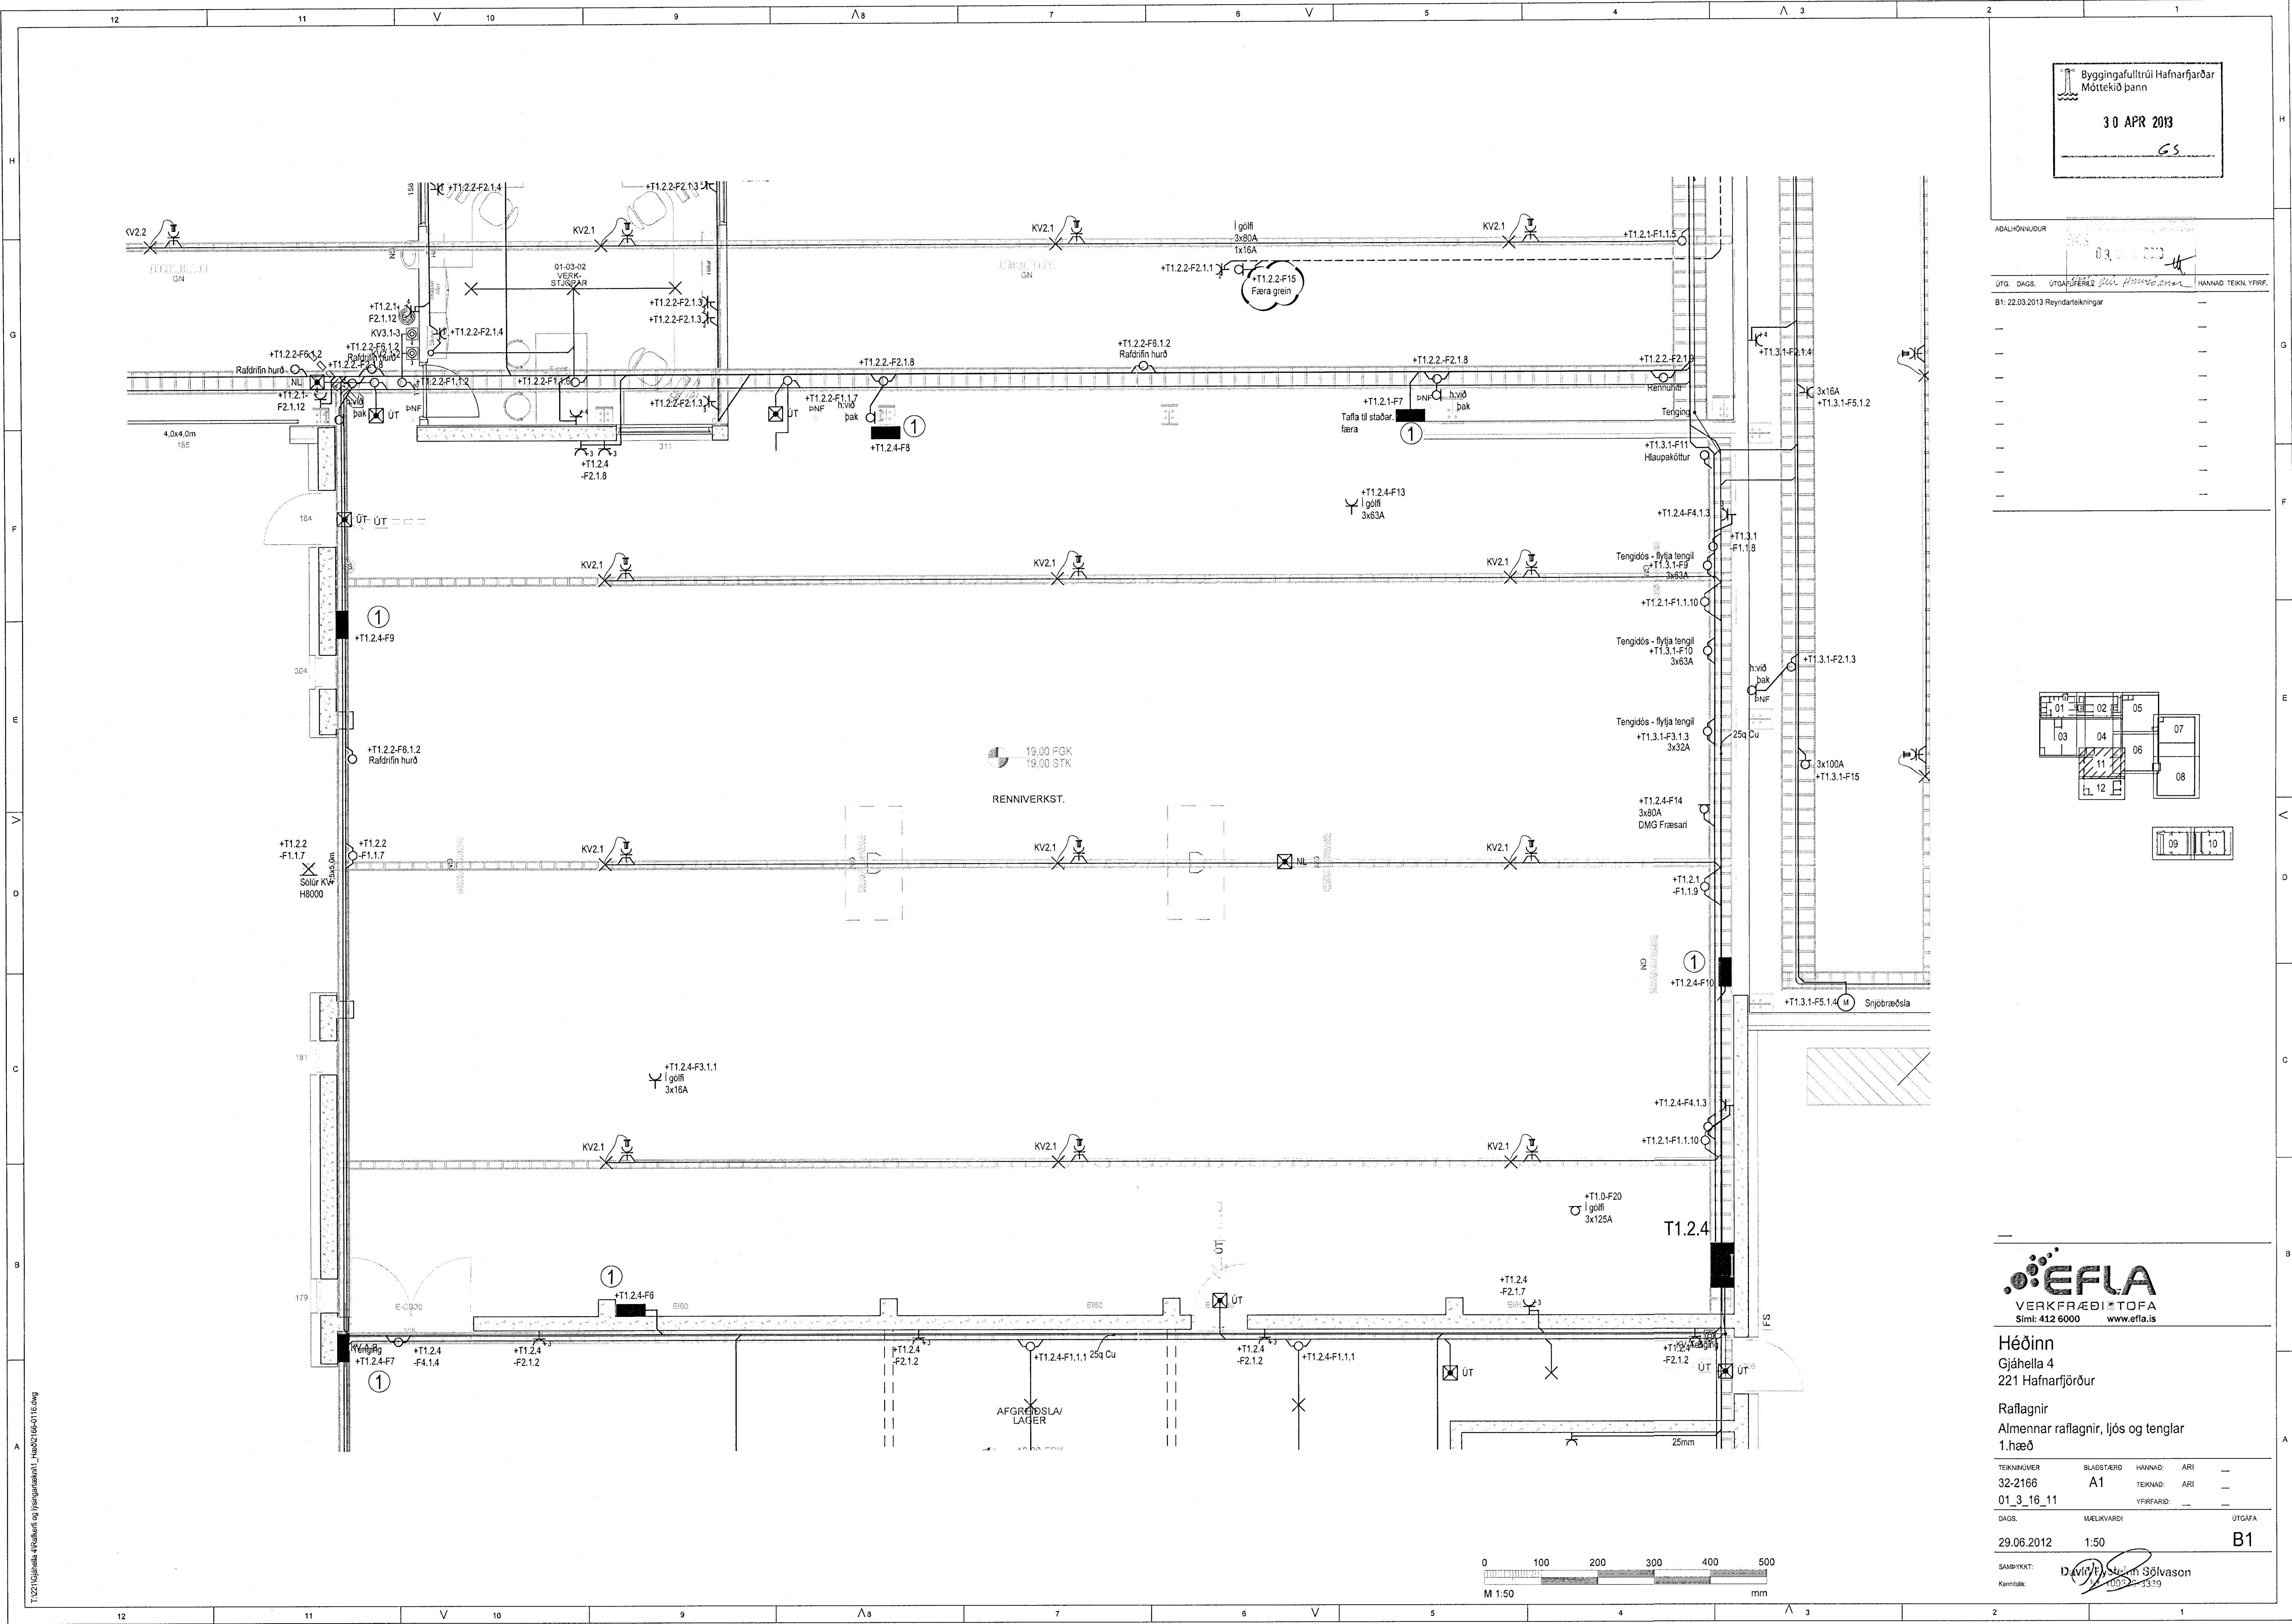


ADALHÖNDUR
UTGAÐSFRÉTTI
HANNAD TEKN. YRFR.
B1: 22.03.2013 Reyndartekningar

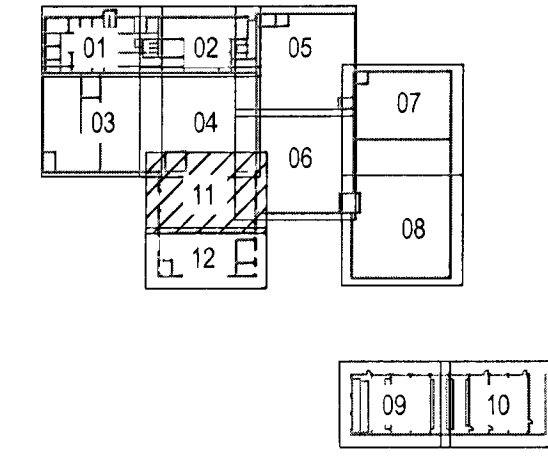


Héðinn
Gjáhella 4
221 Hafnarfjörður

Raflagnir
Almennar raflagnir, ljós og tenglar
1.hæð

TEKNIJEMUR	BLASTÆRÐ	HANNAD	ARI
32-2166	A1	TEKNAD	ARI
01_3_16_11		YRFRARID	
DAGS.	MELKVARDI	UTGAFA	
29.06.2012	1:50	B1	

SAMBYKKT: Davíð Steinn Sólvason
Kennitala: 1002213329

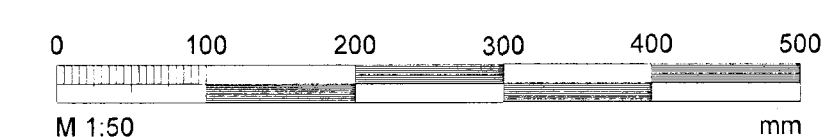

