


G12

1 stk.: 2 gluggar, 1 topphengdur gluggi, 1 hægrihengdur gluggi

90° horn

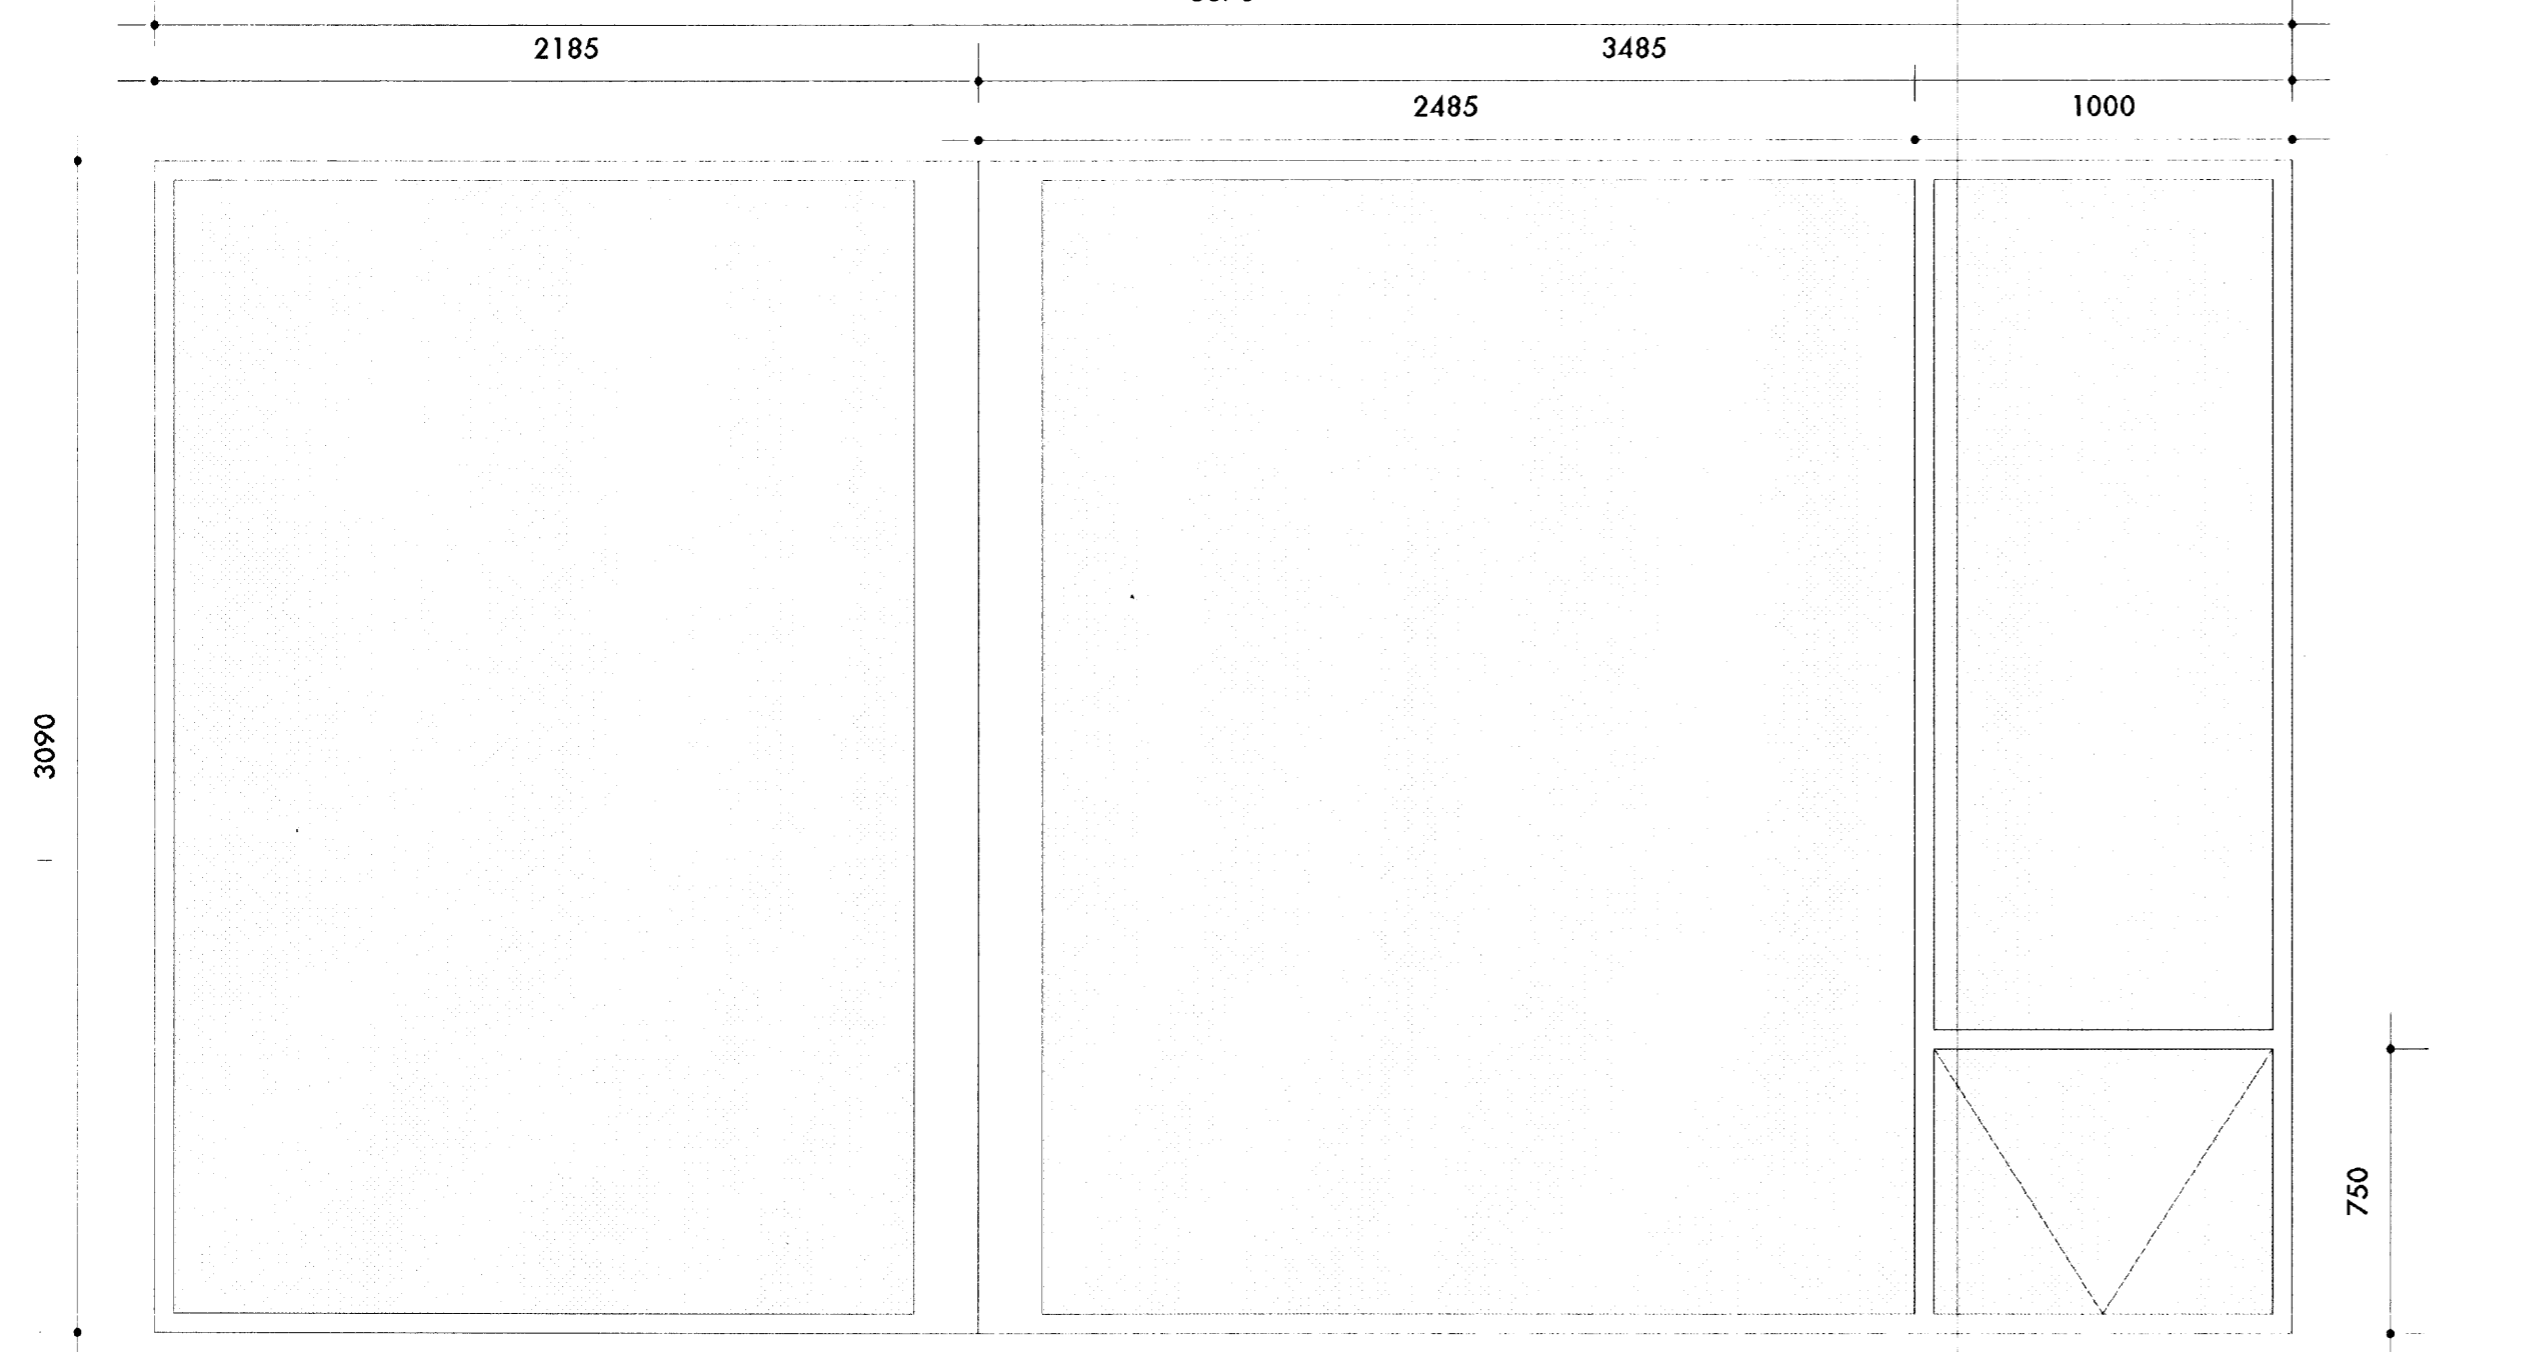

G13

1 stk.: 3 gluggar og 1 topphengdur gluggi

90° horn



breytt G12, bætt við tveimur opnanlegum fögum.

Kristín B. Gunnarsdóttir
 kristin brynja gunnarsdottir
 kt.: 040766 5889
 arkitekt faf
 k@einrum.com
 stefan swersen
 arkitekt faf maa
 s@einrum.com

einrúm arkitektar
 kt.: 471201 2860
 glaðheimur 20 | 104 reykjavík
 sími 553 8989 | fax 568 8989 einrúm

Skógarás "L", Hafnafjörður
teikning 0648 302

efni Gluggateikningar
 dags. 16.01.2008
 breytt
 mkv 1:20

skjaltekið er teikningu höfundar
 og er hún á eigin höndum