Format A1 (841x594 mm) is 20 mm outside of this frame

Samþykkt þann
07 OCT 2009
Byggingafulltrúinn í Hafnarfirði
F.h. Sigurður Steinar Jónsson

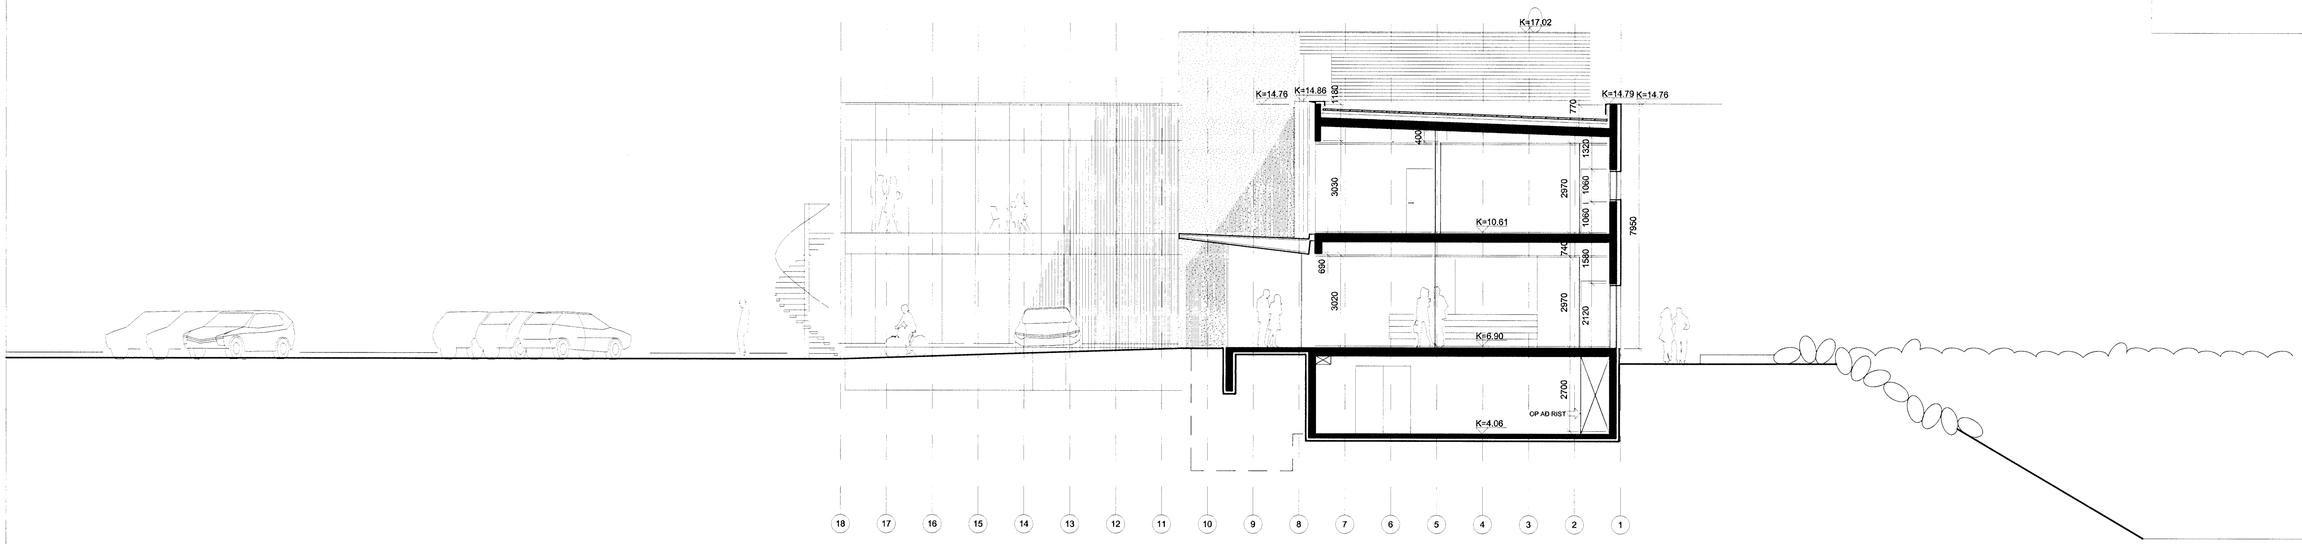

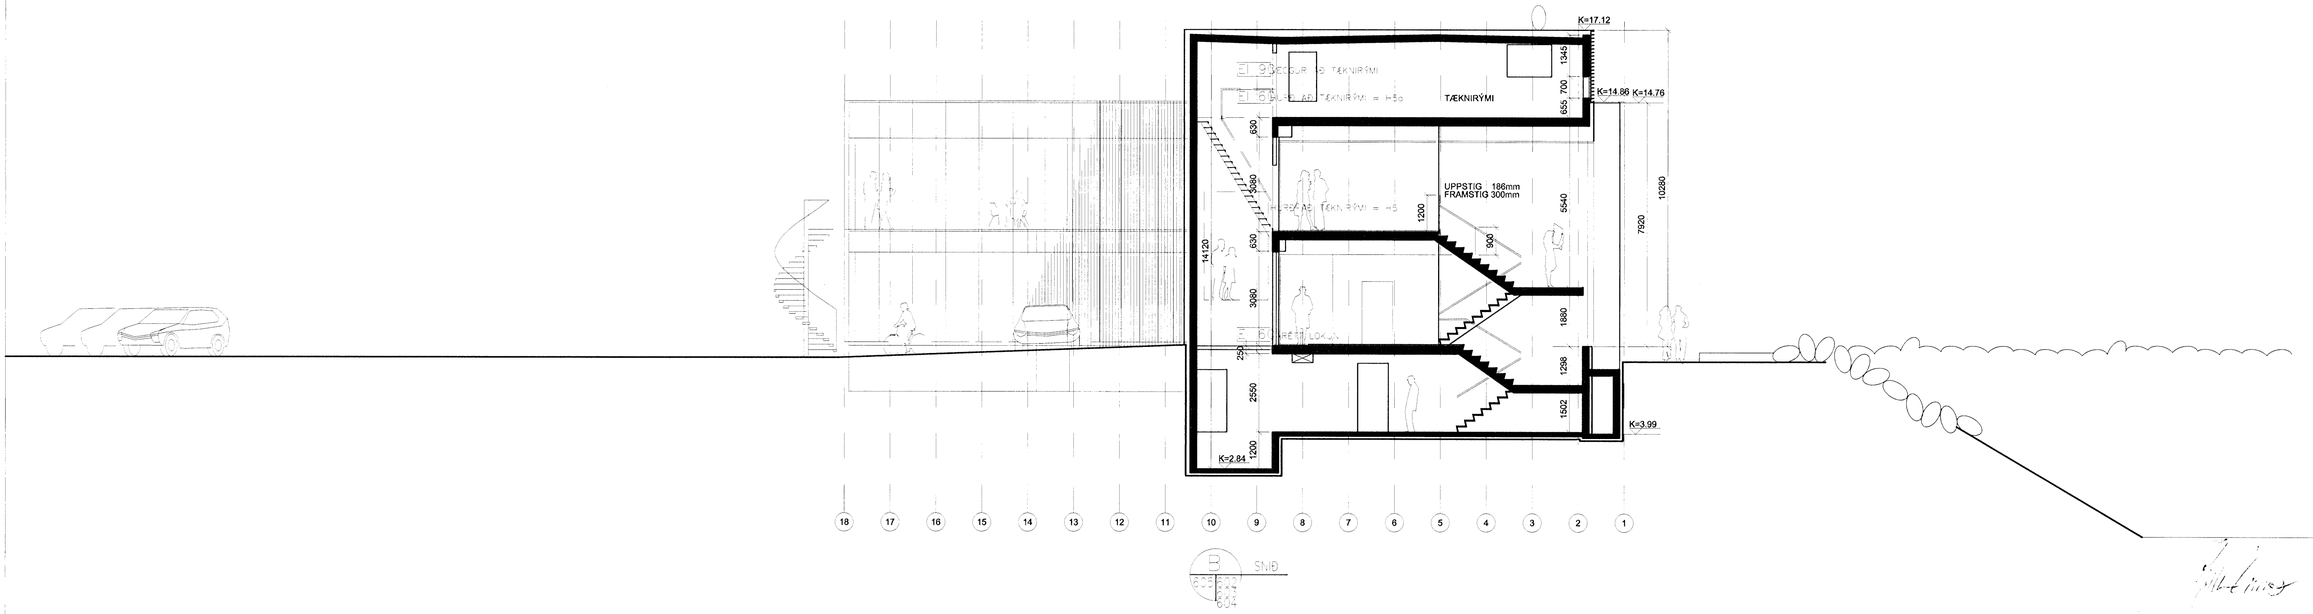

Skýringar:
Explanations:

NGIMUNDUR SVEINSSON
JÓHANN EINARSSON
ÓLAFUR ÓSKAR AXELSSON

Teiknistofa
Ingimundar Sveinssonar
Ingólfsstræti 3
101 Reykjavík
Sími 5204900
Fax 5204901
tis @ tis.is
www. tis. is

Breyt. Rev.	Breyting Revision	Dags. Date	Samþ. Approved	Notk. heimil. Released
B	Gervinnattadiskur	1509090	150909	
A	Reyndarteikning	211105	211105	
3	Sníð B, hurð að lagnastokk og lárétt lokun, hurð að tæknirými	010704	010704	
2	Kvétiai á Þakprún aðalbyggingar hækkaður um 68mm	220304	220304	
1	Aðalteikning	010703	010703	

Tilv.teikningar nr. ISAL
Ref.drawing no. of ISAL

Samsetn.teikningar nr. ISAL
Assembly drawing no. of ISAL

This drawing is the property of the Alcan Iceland Ltd. and handed out for personal use only. It may neither be copied nor made available to others without permission of the Alcan Iceland Ltd. The receiver is liable for any misuse.

Fjöldi stykkja / Number of pieces: IV III II I

Hlutur / Object: SKRIFSTOFUHÚS ALCAN Mhl. 01
VÍKURGATA 3
SNIÐ A OG B

Atriði / Item | Efni / Material | ea.:stk / Weight | total:1 heild (kg) Þyngd | Athugasemdir / Remarks

Stærð / Format: A1 | Mkv. / Scale: 1:100
Kostn.nr.-bún.nr. / CCno.-Eq.no.: 4110 12093
AKS no.: UM10

Verktaki / Supplier: Teiknistofa Ingimundar Sveinssonar ehf
Teikn.nr. vertaka / Drw.no. of suppl.: 605 | Breyt./Rev.: B

Teiknað / Drawn: JE/LGS 01072003 | Yfirfarið / Checked: JE 01072003
Samþykkt / Approved

RioTintoAlcan
ISAL
Straumsvík
Alcan Iceland Ltd
IS-222 Hafnarfjordur

Drw.no. of ISAL / Teikn.nr. ISAL: 168605 | Breyt./Rev.: B

Teiknað / Drawn | Yfirfarið og skráð / Checked and filed | Notkun heimiluð / Released