


Sambýkt bann
14. OCT 2008
Byggingufræðingur Hafnar, 31
Fh. Sigurður Steinarjónsson

- D: Reynndartekning, brunamerkingar. 23.01.2008
 - C: Brunatökn, breytingarský 22.03.2005.
 - B: Þrófunarverksmiðja oft. 25.01.2005
 - A: Brunhönnun og merkingar. 26.08.2004.
- BREYTINGAR: DAGS:

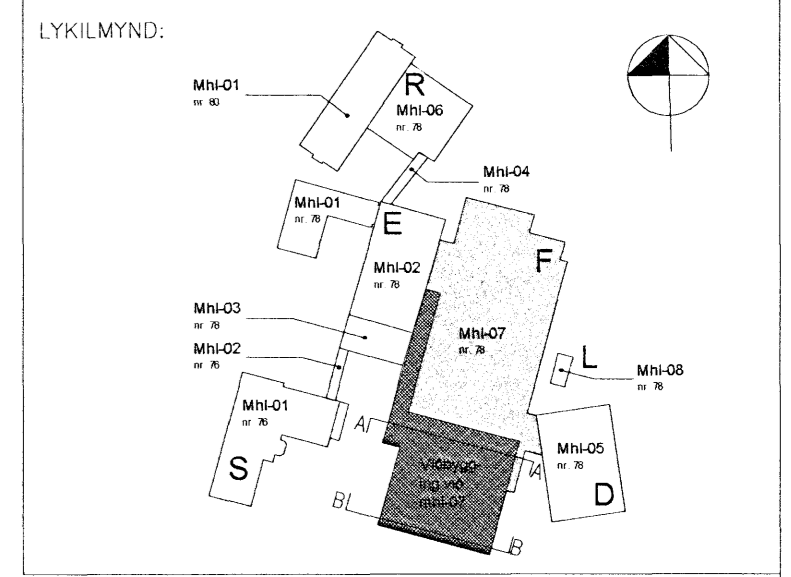

VERKKAUPLI:

REYKJANIKRYGGUR 78
BYGGINGARLÍTI - F-VERKSMIÐJA
ADALUPPDRATTUR
GRUNNMÝND 1 HÉDAR.

VERKI: DELT-0416 DAGS: 03.06.2004.
KVARÐI: 1:100 TEIKNAD: PAM/ÖB
SKRÁ: A-0102.cwg

ÚTI INNI
ARKITEKTAR
DINGHÖLFSSTRÆTI 27 101 REYKJANIK
SÍMAR 5527660 & 5627660 FAX 5527661
VEFANG: www.uti.is
BÁLDUR Ö. SWANARSSON ARKITEKTAR FAI
1203357-5149
JÓN ÖR. ÞORVALDSSON ARKITEKTAR FAI
021256-7579
TEIKNINGAR: **A-0102** BREYTING: **D**