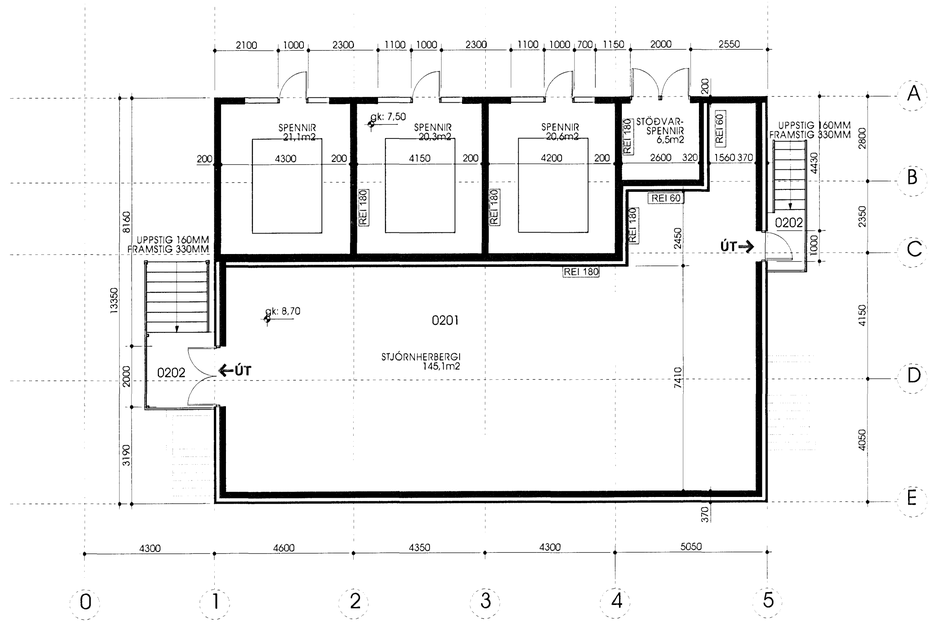

1 GRUNNMYND 2. HÆÐ
mkv. 1:100

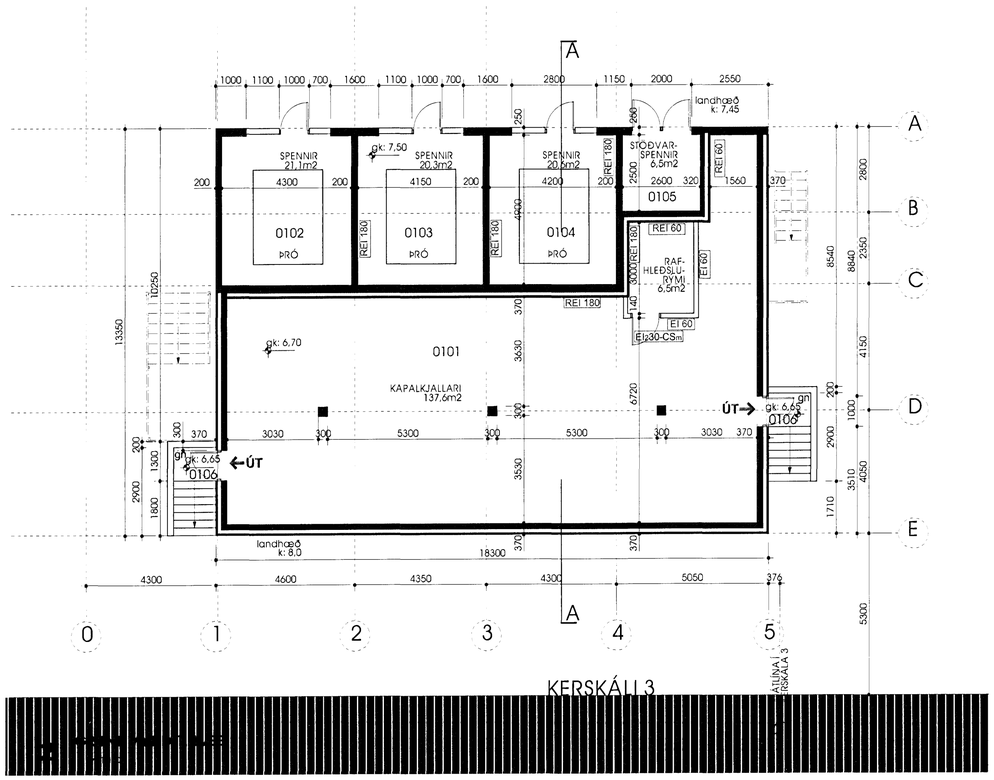

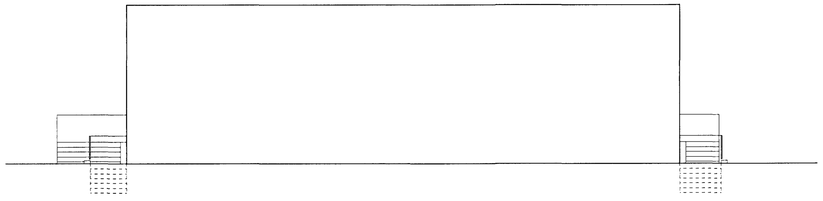

3 ÚTLIT SUÐAUSTUR
mkv. 1:100

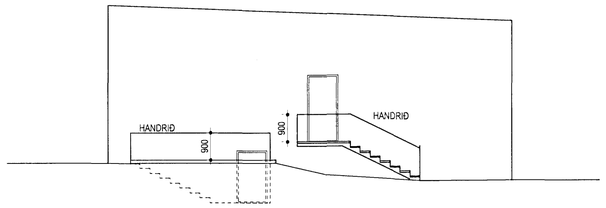

4 ÚTLIT NORÐAUSTUR
mkv. 1:100

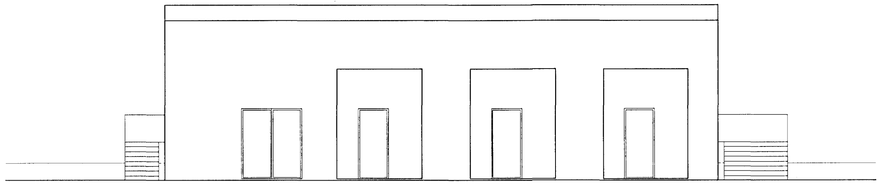

5 ÚTLIT NORÐVESTUR
mkv. 1:100

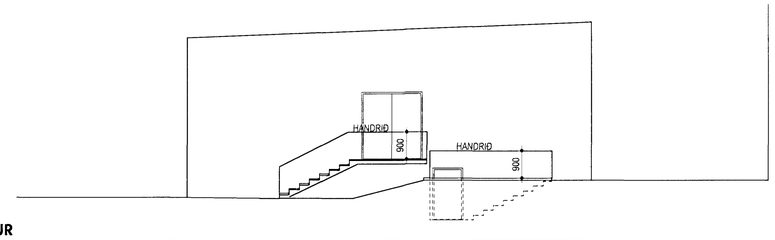

6 ÚTLIT SUÐVESTUR
mkv. 1:100

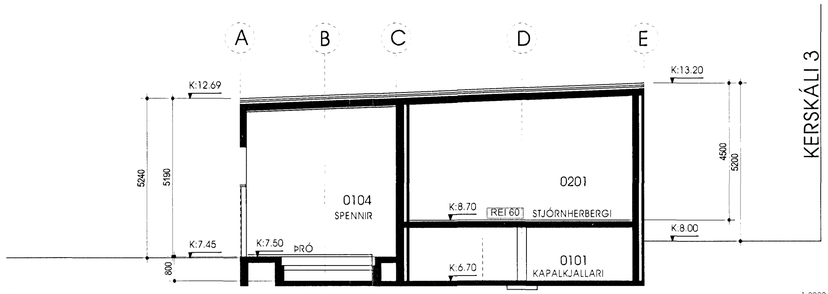

7 SKURÐUR AA
mkv. 1:100

Samþykkt þann
03 MAY 2012
Byggingafulltrúinn í Hafnarfirði
F.h. Sigurður Steinar Jónsson

3.4.2012
HERBRIGÐISEFTIRLIT
HEILBRIGÐISEFTIRLITS
OG KÖPAVOGSUMDÆMIS
Garðatorgi 7 - 210 Garðabæ

28.03.2012

1:2000
100 0 100

Skýringar:
Legend:

C:\Users\lilja\Desktop\As built teikningahaus.dwg

Útg.nr. Rev.no	Lýsing Description	Dagsetning Date	Hanv/Tkn Des/Drw	Yfirf Ckd	Samþ. Appr.	Nota heim Suppl Ref	Nota heim ISAL Ref
A	As Built	09.03.2012	SK	SK			

This drawing is the property of Rio Tinto Alcan Iceland Ltd. and handed out for personal use only. It may neither be copied nor made available to others without permission of Rio Tinto Alcan Iceland Ltd. The receiver is liable for any misuse.

Stærð: Format: A1 Mkv.: Scale: 1:100
Dimensions without tolerances according to ISO 2768-1 medium.

HRV & HATCH JOINT VENTURE
ISAL PRODUCTION UPGRADE

GLÁMA·KÍM
Aðalteikn. burðarvirki hús, lóð, fráveita, s. 420 4140, f. 420 4141, kt. 440 690 1230, glamakim@glamakim.is, www.glamakim.is

Dagsetning / Date	05.10.2010
Hannað / Designed	SK/BBJ
Teikn / Drawn	BBJ/SK
Verktaki / Supplier	GLÁMA·KÍM
Teikn.nr.verktaka / Supplier drw.no.	A0.02
Samþykkt / Approved	
Yfirf / Chkd	ÁK
Hluti af / Part of:	

IDP-212 SUBSTATION 140
DREIFISTÖÐ
GRUNNMYNDIR, ÚTLIT OG SNEIÐINGAR

Teg.teikningar / Dwg. type: AÐALUPPDRÁTTUR
Architectural: Building Application

Rio Tinto Alcan
ISAL
Alcan Iceland Ltd
Straumsvík
IS-222 Hafnarfjörður
Iceland

ISAL Yfirfarið og skráð, dags / ISAL Checked, date
ISAL Samþykkt, dags / ISAL Approval, date

Flokkur nr.:	Blað nr.:	Næsta blnr.:
Kostn.nr.-Cono. / Búnn.nr.-Eq.no		
4011	16406	
AKS		
UB140		
Teikn.nr. ISAL /Drw.no. of ISAL		Breyt./Rev.
251403		A