


16/6 '10 *EL*

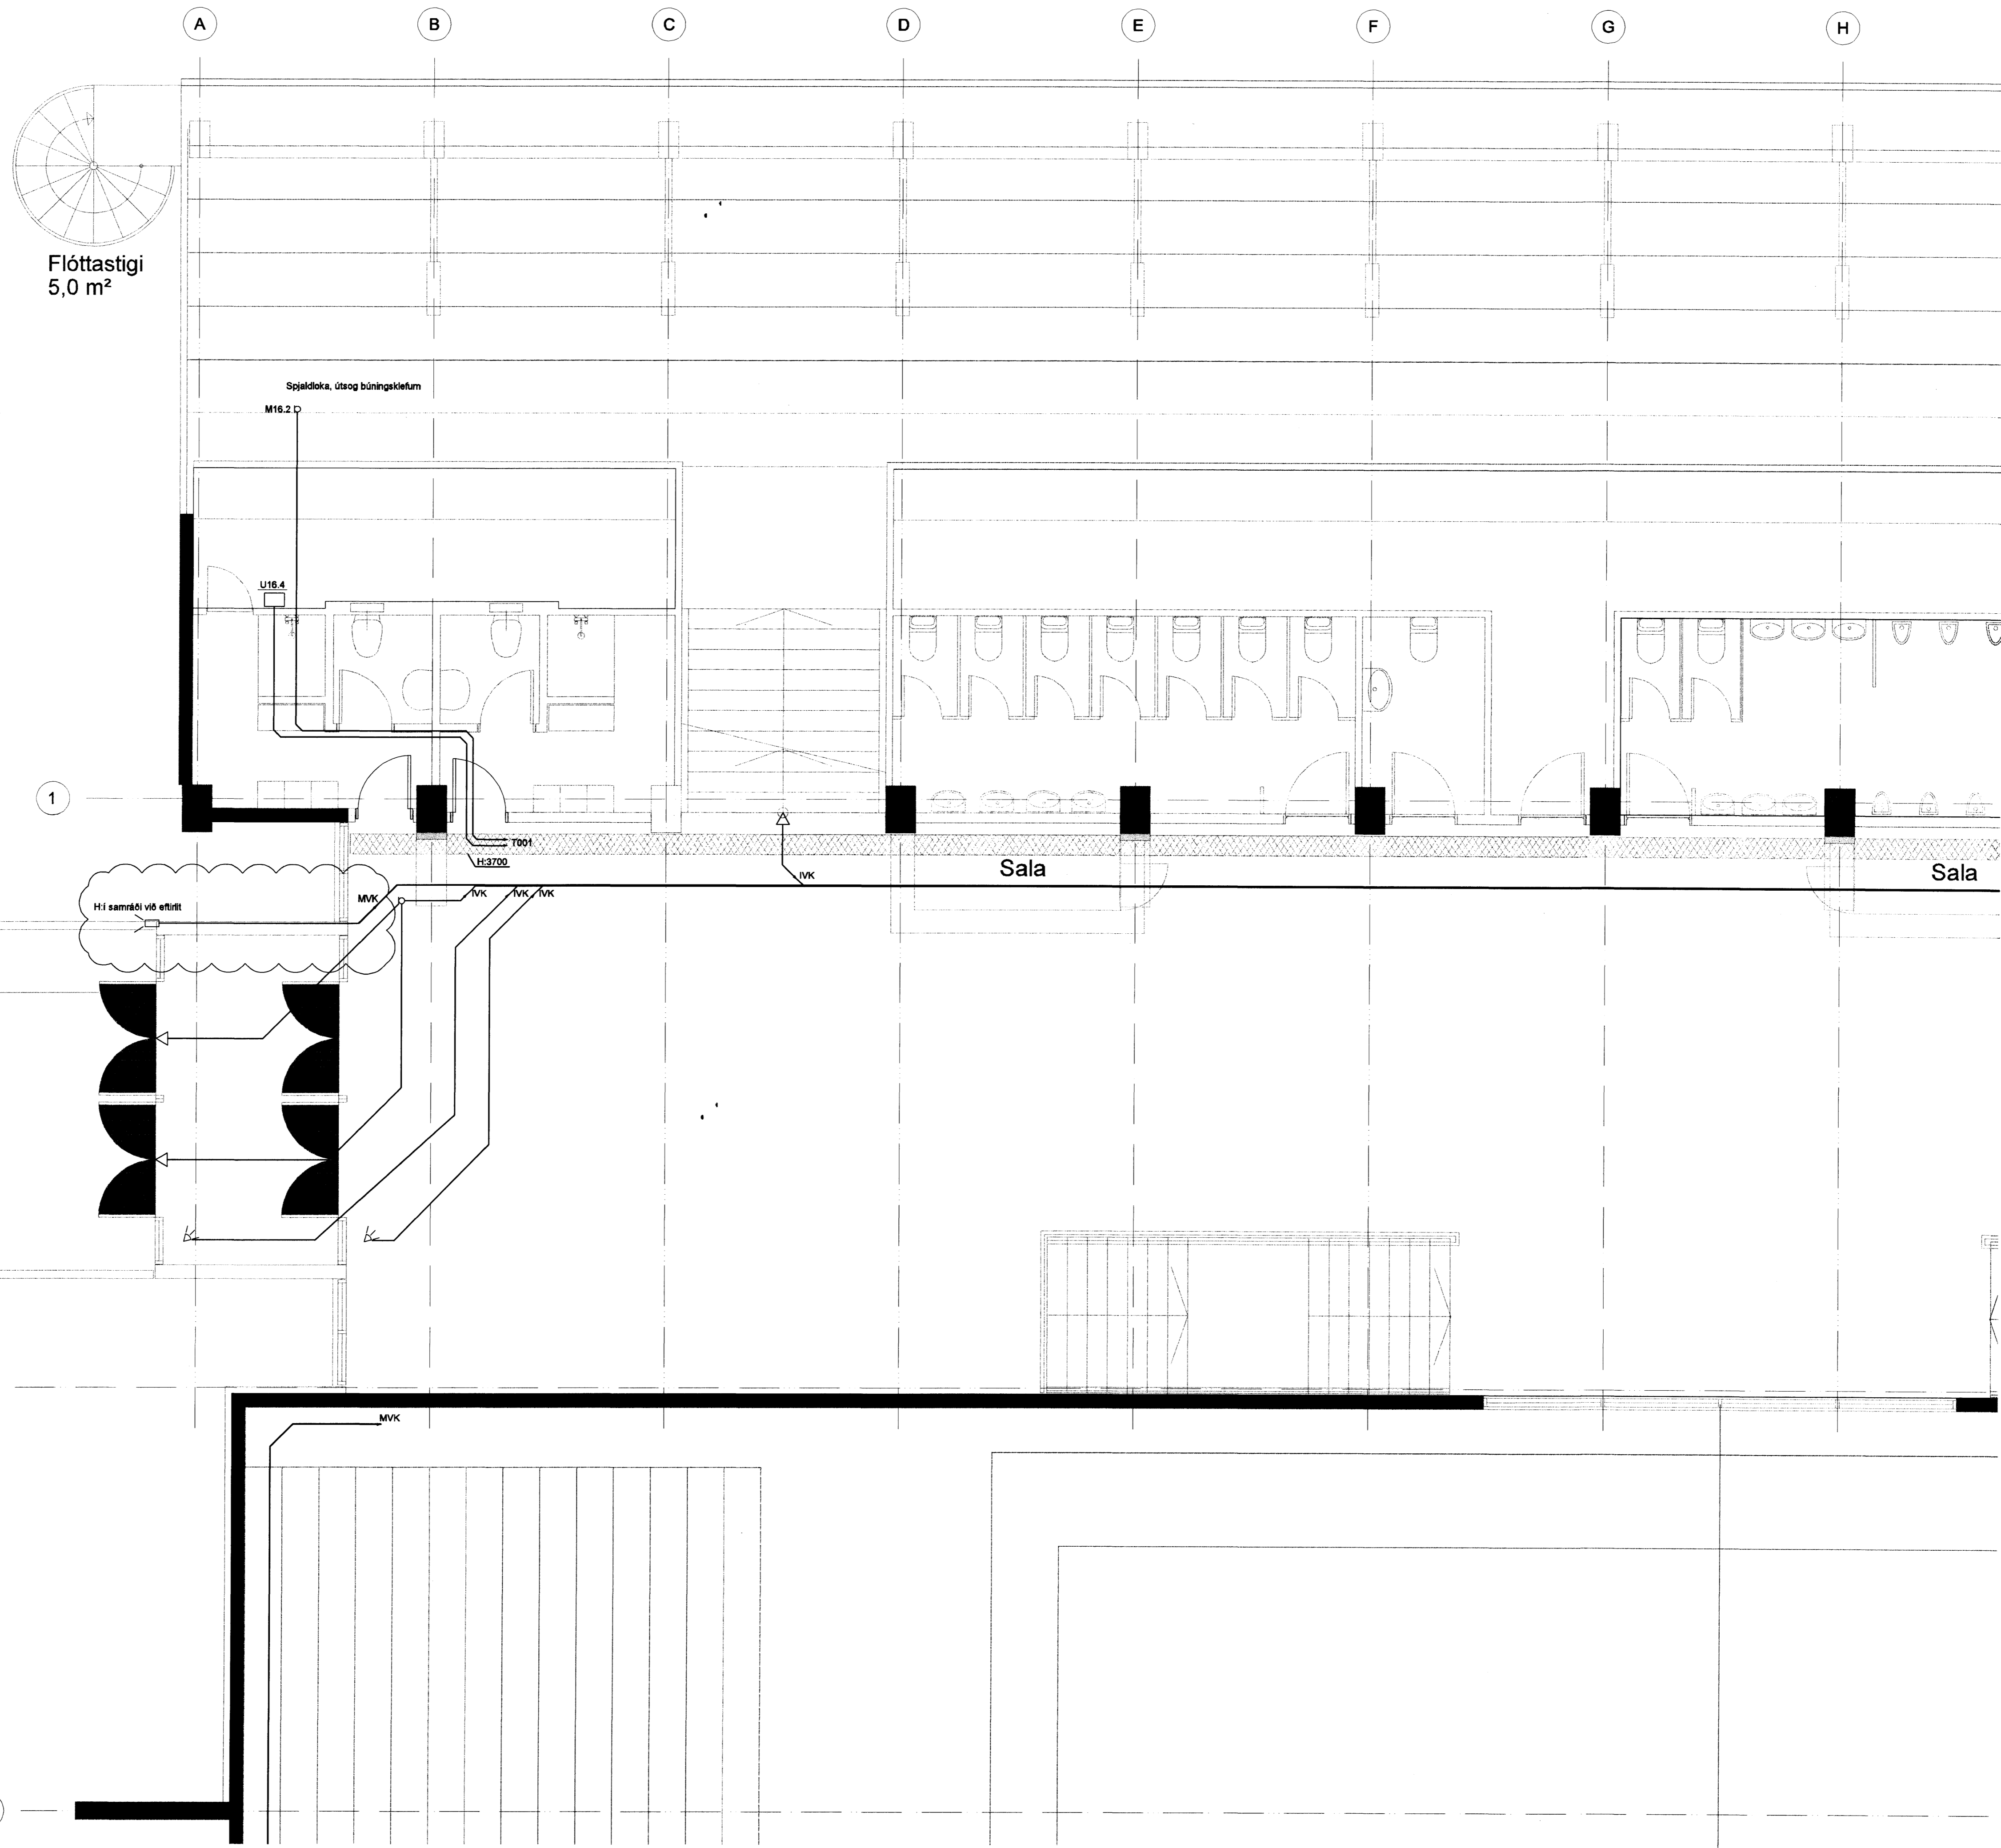

Flóttastigi  
5,0 m<sup>2</sup>

Spjaldloka, útsög bíningsklefum

M16.2 D

U16.4

H3700

Sala

Sala

Hi samræði við eftirlit

MVK

IVK

IVK/IVK


ke

ke


MVK

B I


3

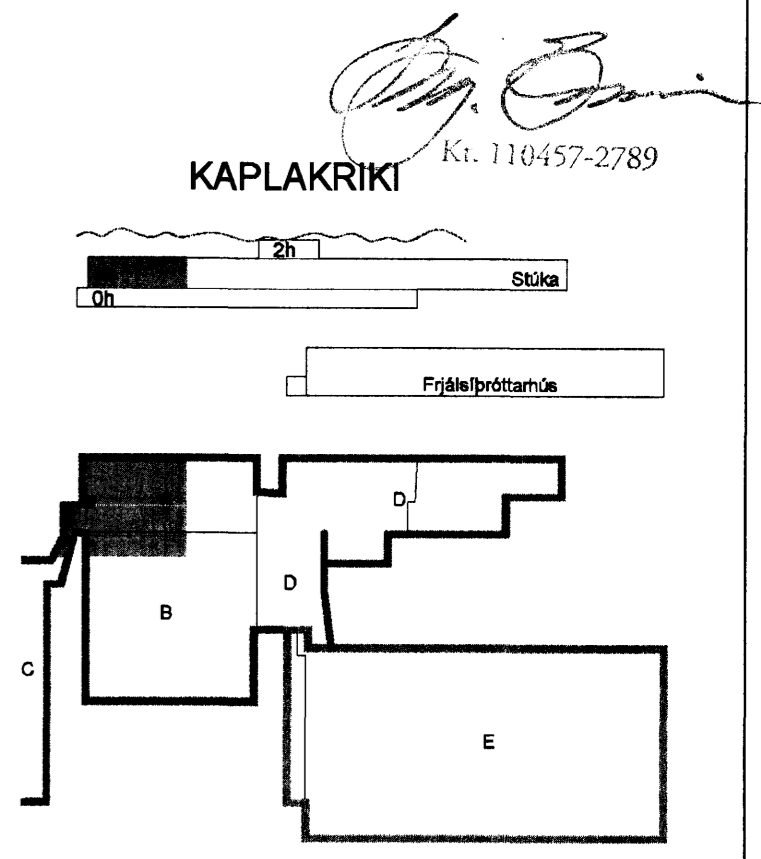

KAPLAKRIKI Kt. 110457-2789

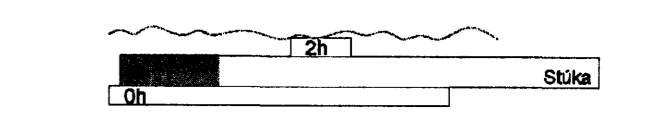


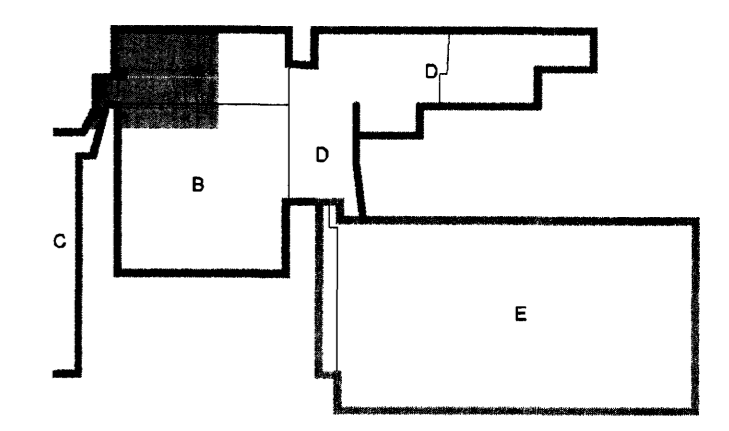

B	15.06.10	Myndavélaferli	BSS/ÖG
A	14.01.10	Innbrotavörðunarkerfi	BSS/ÖG
Úg.	Dags.	Skýring	Hannað/Vírfaró

**VSB**

VERKFRÆÐISTOFA

BEIJAHRÁUN 20 · 230 HAFNARFJÖRDUR · KENNIT. 710706-2899  
vab@vab.is · Sími 565 8600 · Fax 565 9610 · www.vab.is

Áritun sérhönnuðar  
Örn Guðmundsson Kt: 220961-2739

Verkefni  
**KAPLAKRIKI  
HAFNARFIRÐI**

Verktali  
**Rafkerfi  
Smáspenna 1.hæð  
Grunnmynd**

Hannað	Telmað	Yfirfarð	Kvart	Síða
RVK/HJ	RVK/HJ	RVK	1:50	/ A1
Dags.	Verkefni	Talning	Útgáfa	
06.10.08	06811	A R311	B	

V:\2006\0811\0811-KaplaKriki\FH\Sheeta\FH1\Sheeta\FH1-FCS-1.hæð-A.dwg