
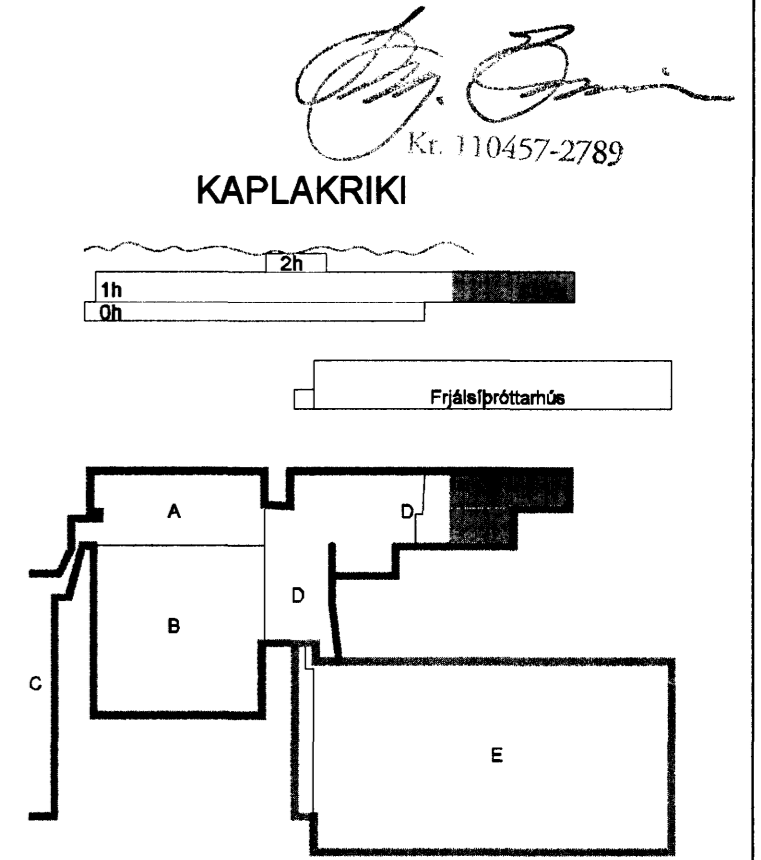
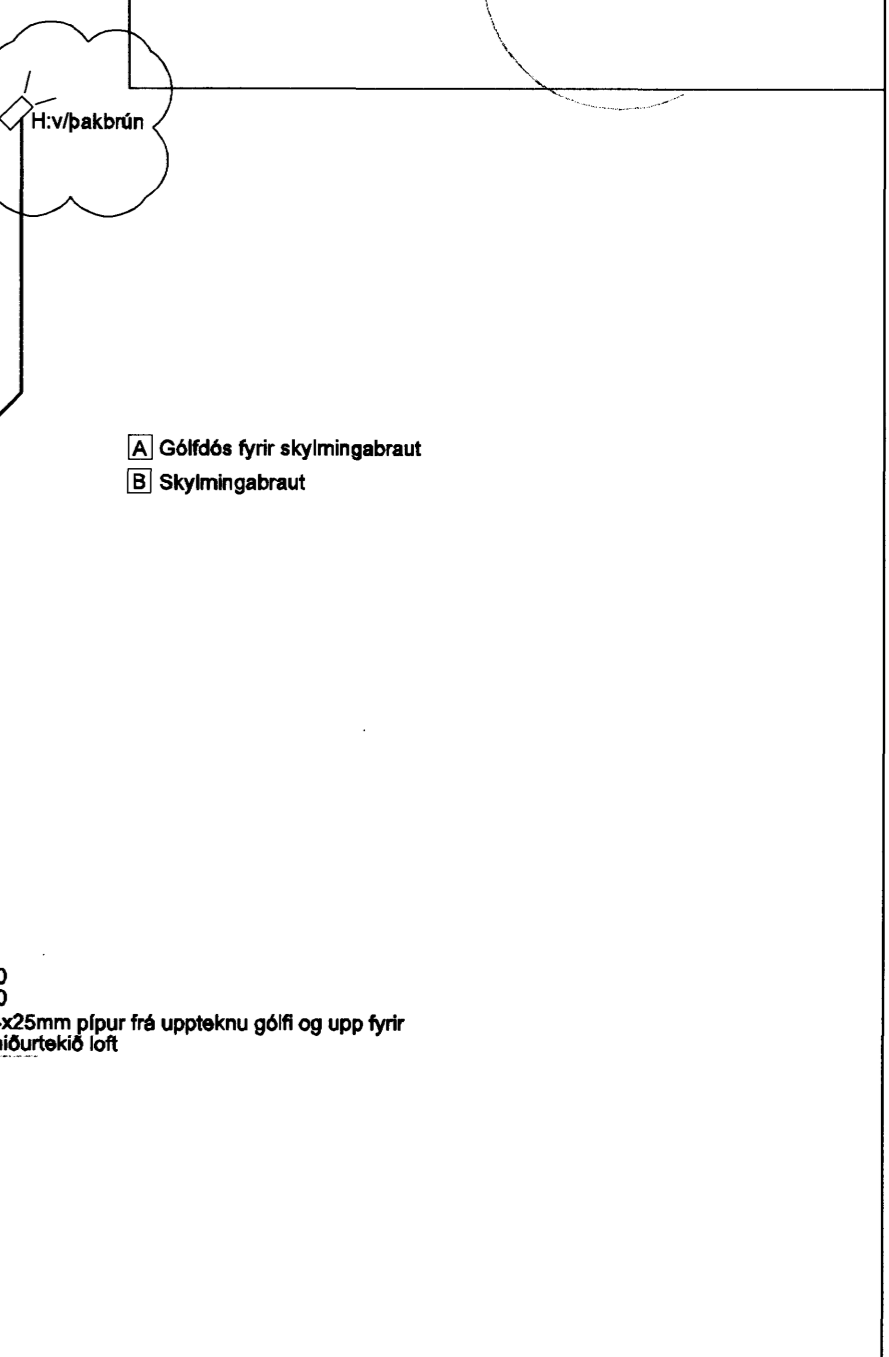


16/6 '10 H

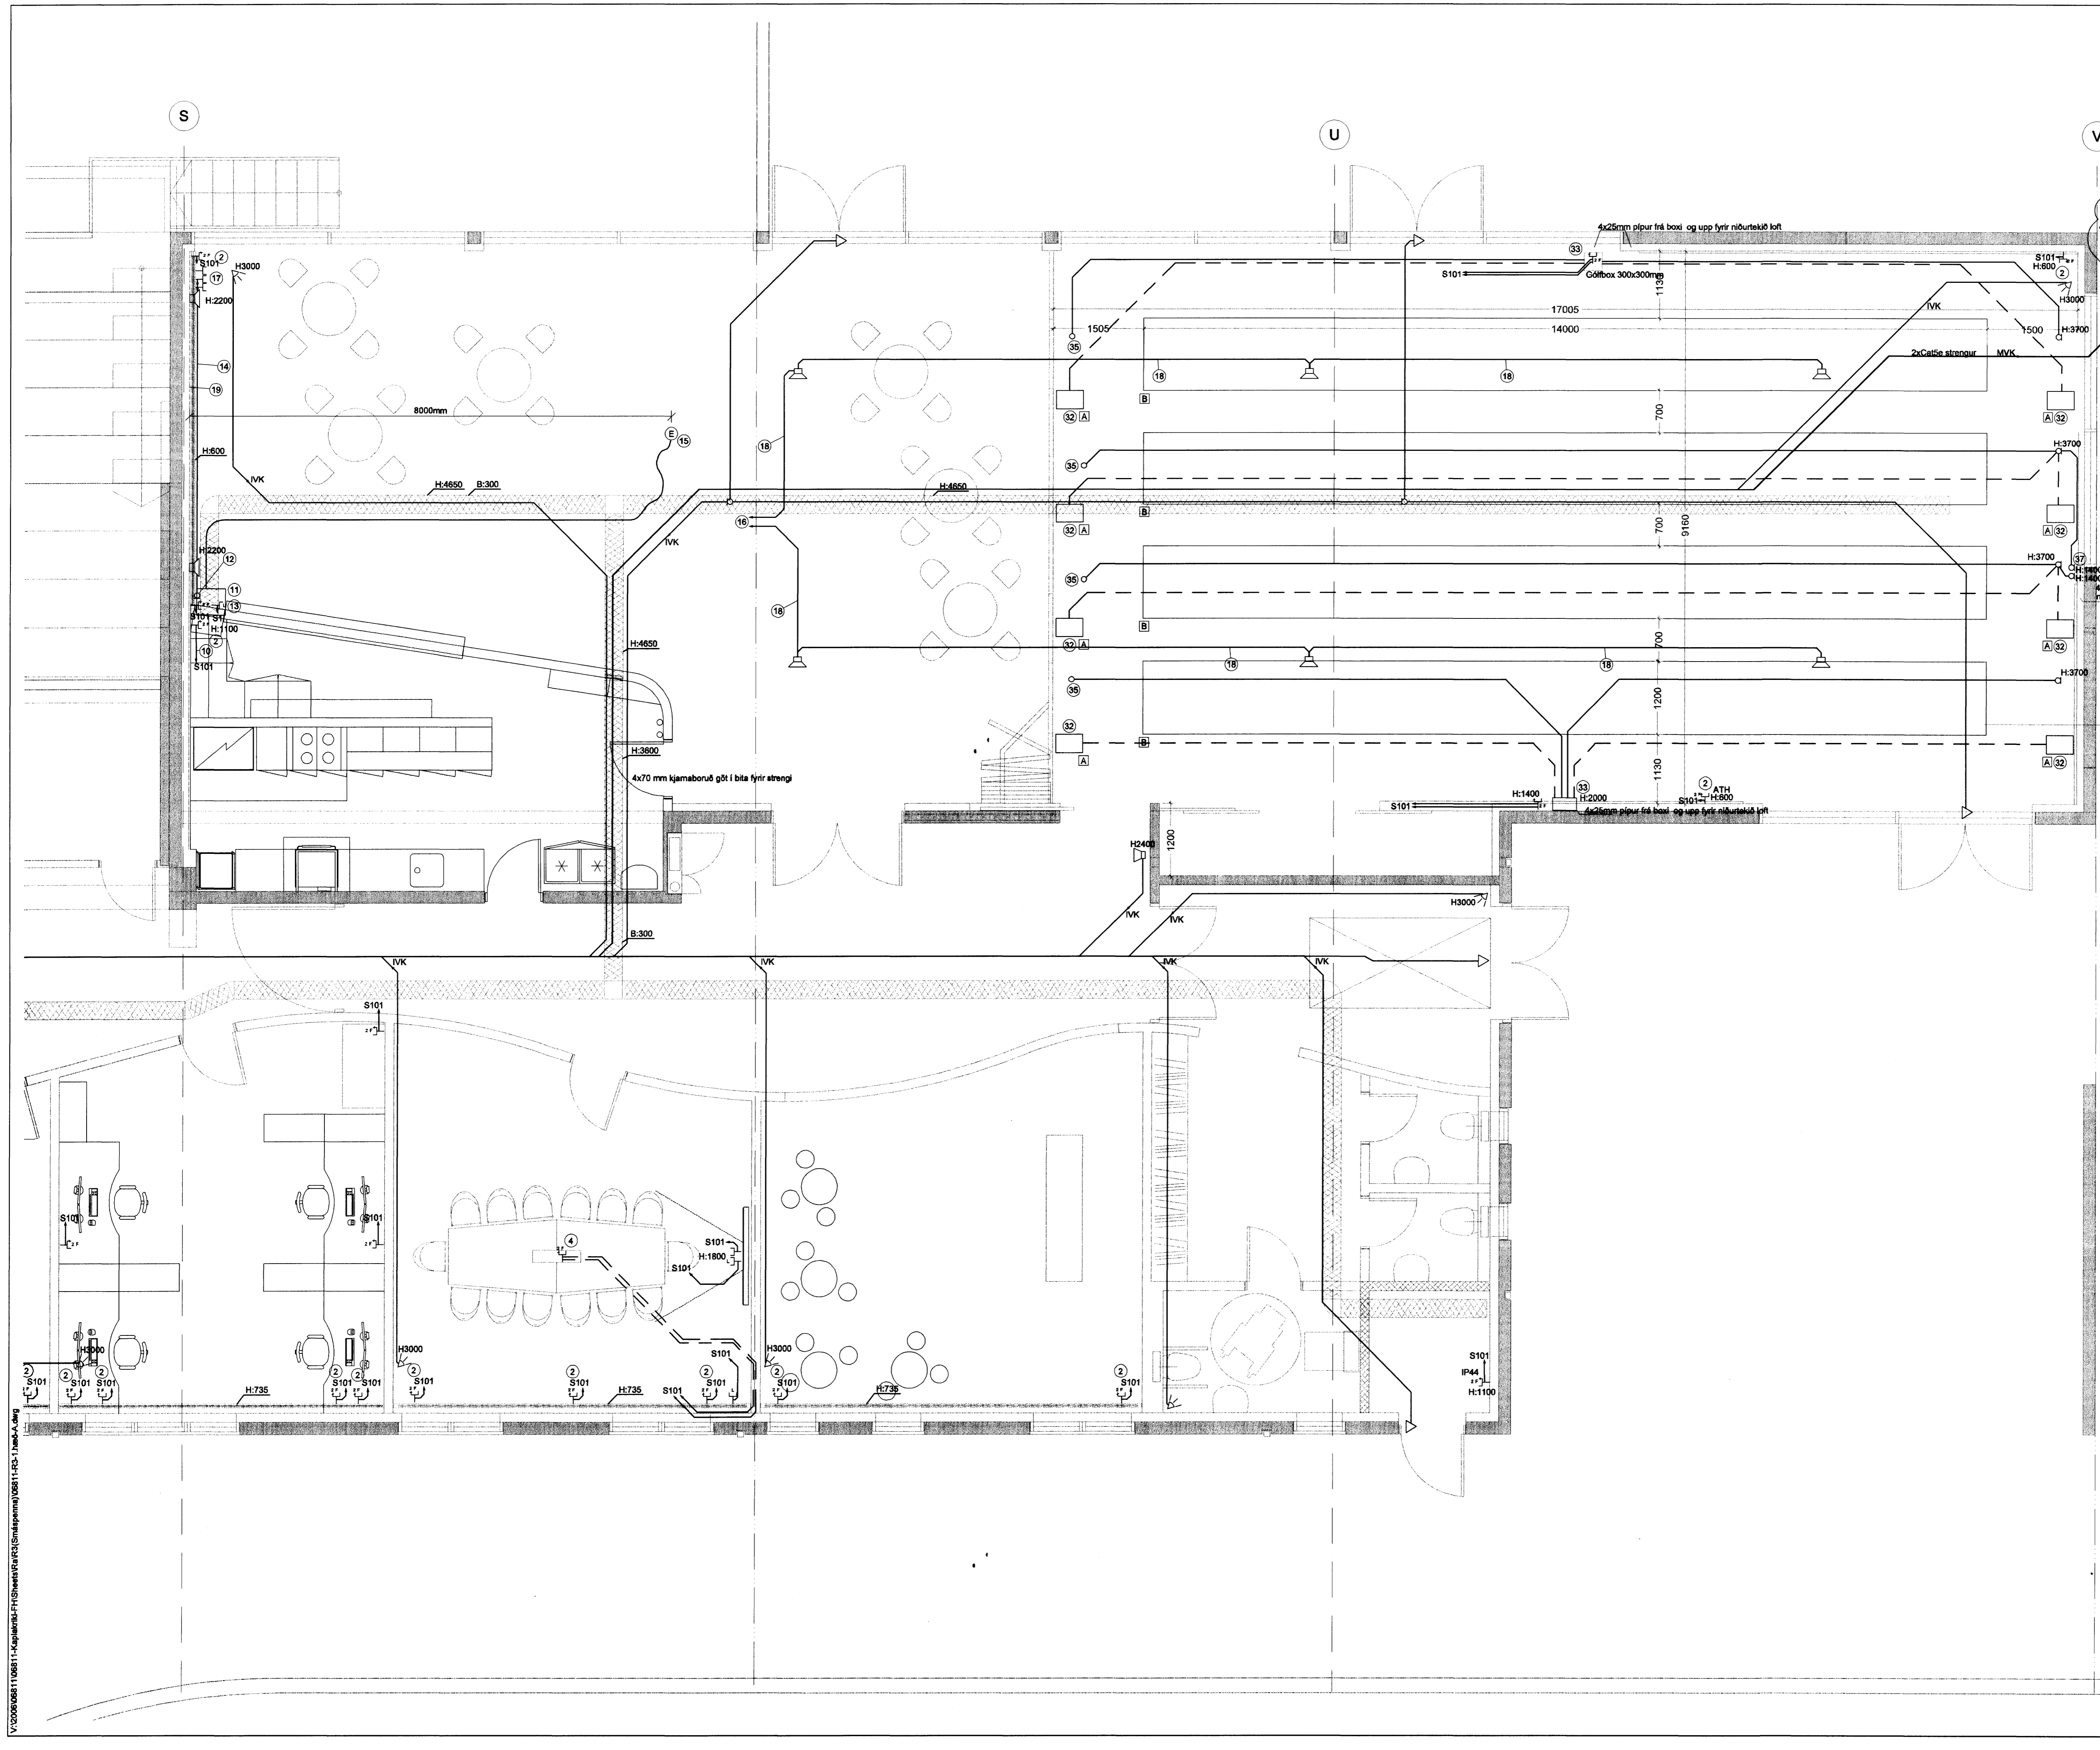

F	15.06.10	Myndavélaútlit	BSG/ÖG
E	14.01.10	Innbrotavéðrunarkerfi	BSG/ÖG
D	05.11.09	Skyfmingasalur	BSG/ÖG
C	12.06.09	Breyting á herbergjum	SF/BSG
B	12.01.09	Vegna skyfmingabrautar	SF/ÖG
A	27.11.07	Verkefning	RVK/HJ
Útg.	Dags.	Skyring	Hanna5/Yrfraró

VSB

VERKFRÆÐISTOFA

BEIARHRAUN 20 · 220 HAFNARFJÖRÐUR · KENNIT. 710796-2999
vab@vab.is · Sími 585 8600 · Fax 585 8610 · www.vab.is

Aftun sérhönnuð Örn Guðmundsson Kt: 220961-2739					
Verkefni KAPLAKRIKI HAFNARFIRÐI					
Verkið Rafkerfi Smáspenna 1.hæð Grunnmynd					
Hanna5	Tekna5	Yrfraró	Kvarði	Síða	
RVK/HJ	RVK/HJ	RVK	1:50	/ A1	-
Dags.	Verkefni	Teikning	Útgáfa		
30.04.2007	06811	A R314	F		

V:\2006\06811\06811-KaplaKriki-FH\Sheets\Kriki3(Smáspenna)\06811-R3-1.hæk-A.dwg