

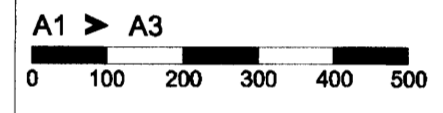


SKÝRINGAR:


- Gífsveggir:
 Veggjagerð A, 147 mm.
- Útveggir:
 Stálklæddur útveggur tækniklefa.

HK = Hrákóti á steipt gólf
 FK = Frágenginn kóti gólfs
 NB = Kóti í neðri brún ops
 EB = Kóti í efri brún ops
 NF = Niðurfall
 BSL= Brunaslanga

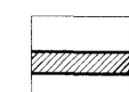

C:
 B:
 A: Sérhlutamerkingar tæknirýmis, E-201. 25.05.2010

BREYTINGAR: DAGS:

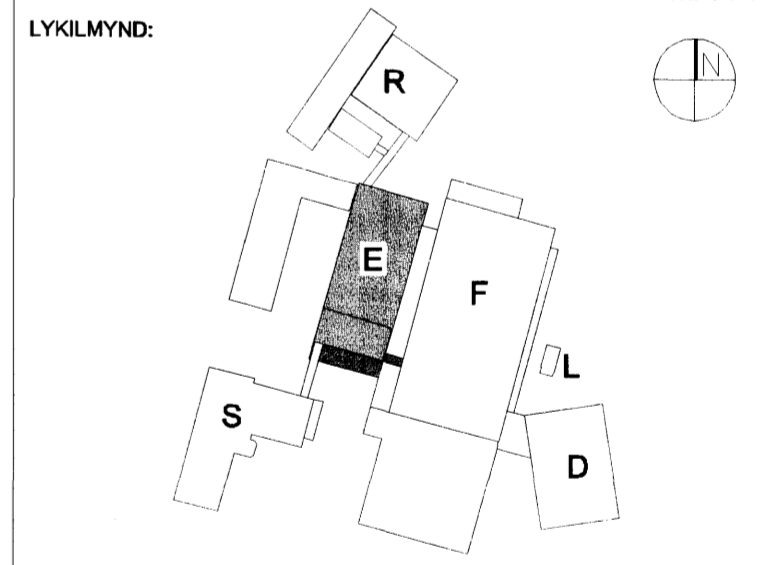

VERKKAUPI:

 REYKJAVÍKURVEGUR 78.
 BYGGINGARHLUTI: E-BYGGING

VERKTEIKNING
 GRUNNMYND 2. HÆÐAR
 BLAÐ 1 AF 2

VERK: ACTA 0933 DAGS: 02.05.2010
 KVARDI: 1:50 TEIKNAD: ÖB
 SKRÁ: 0633-E-204-205.dwg

ÚTI INNI


ARKITEKTAR

ÞINGHOLTSSTRÆTI 27 101 REYKJAVÍK
 Símar 552 7660 & 562 7660 FAX 552 7661
 NETFANG: u@ui.is
 VEFANG: http://www.ui.is

BALDUR Ó. SVAVARSSON ARKITEKTAR FAÍ
 120357-5149

JÓN ÞÓR ÞORVALDSSON ARKITEKTAR FAÍ
 021256-7579

TEIKNINGARNR: **A-E-204** BREYTING: A

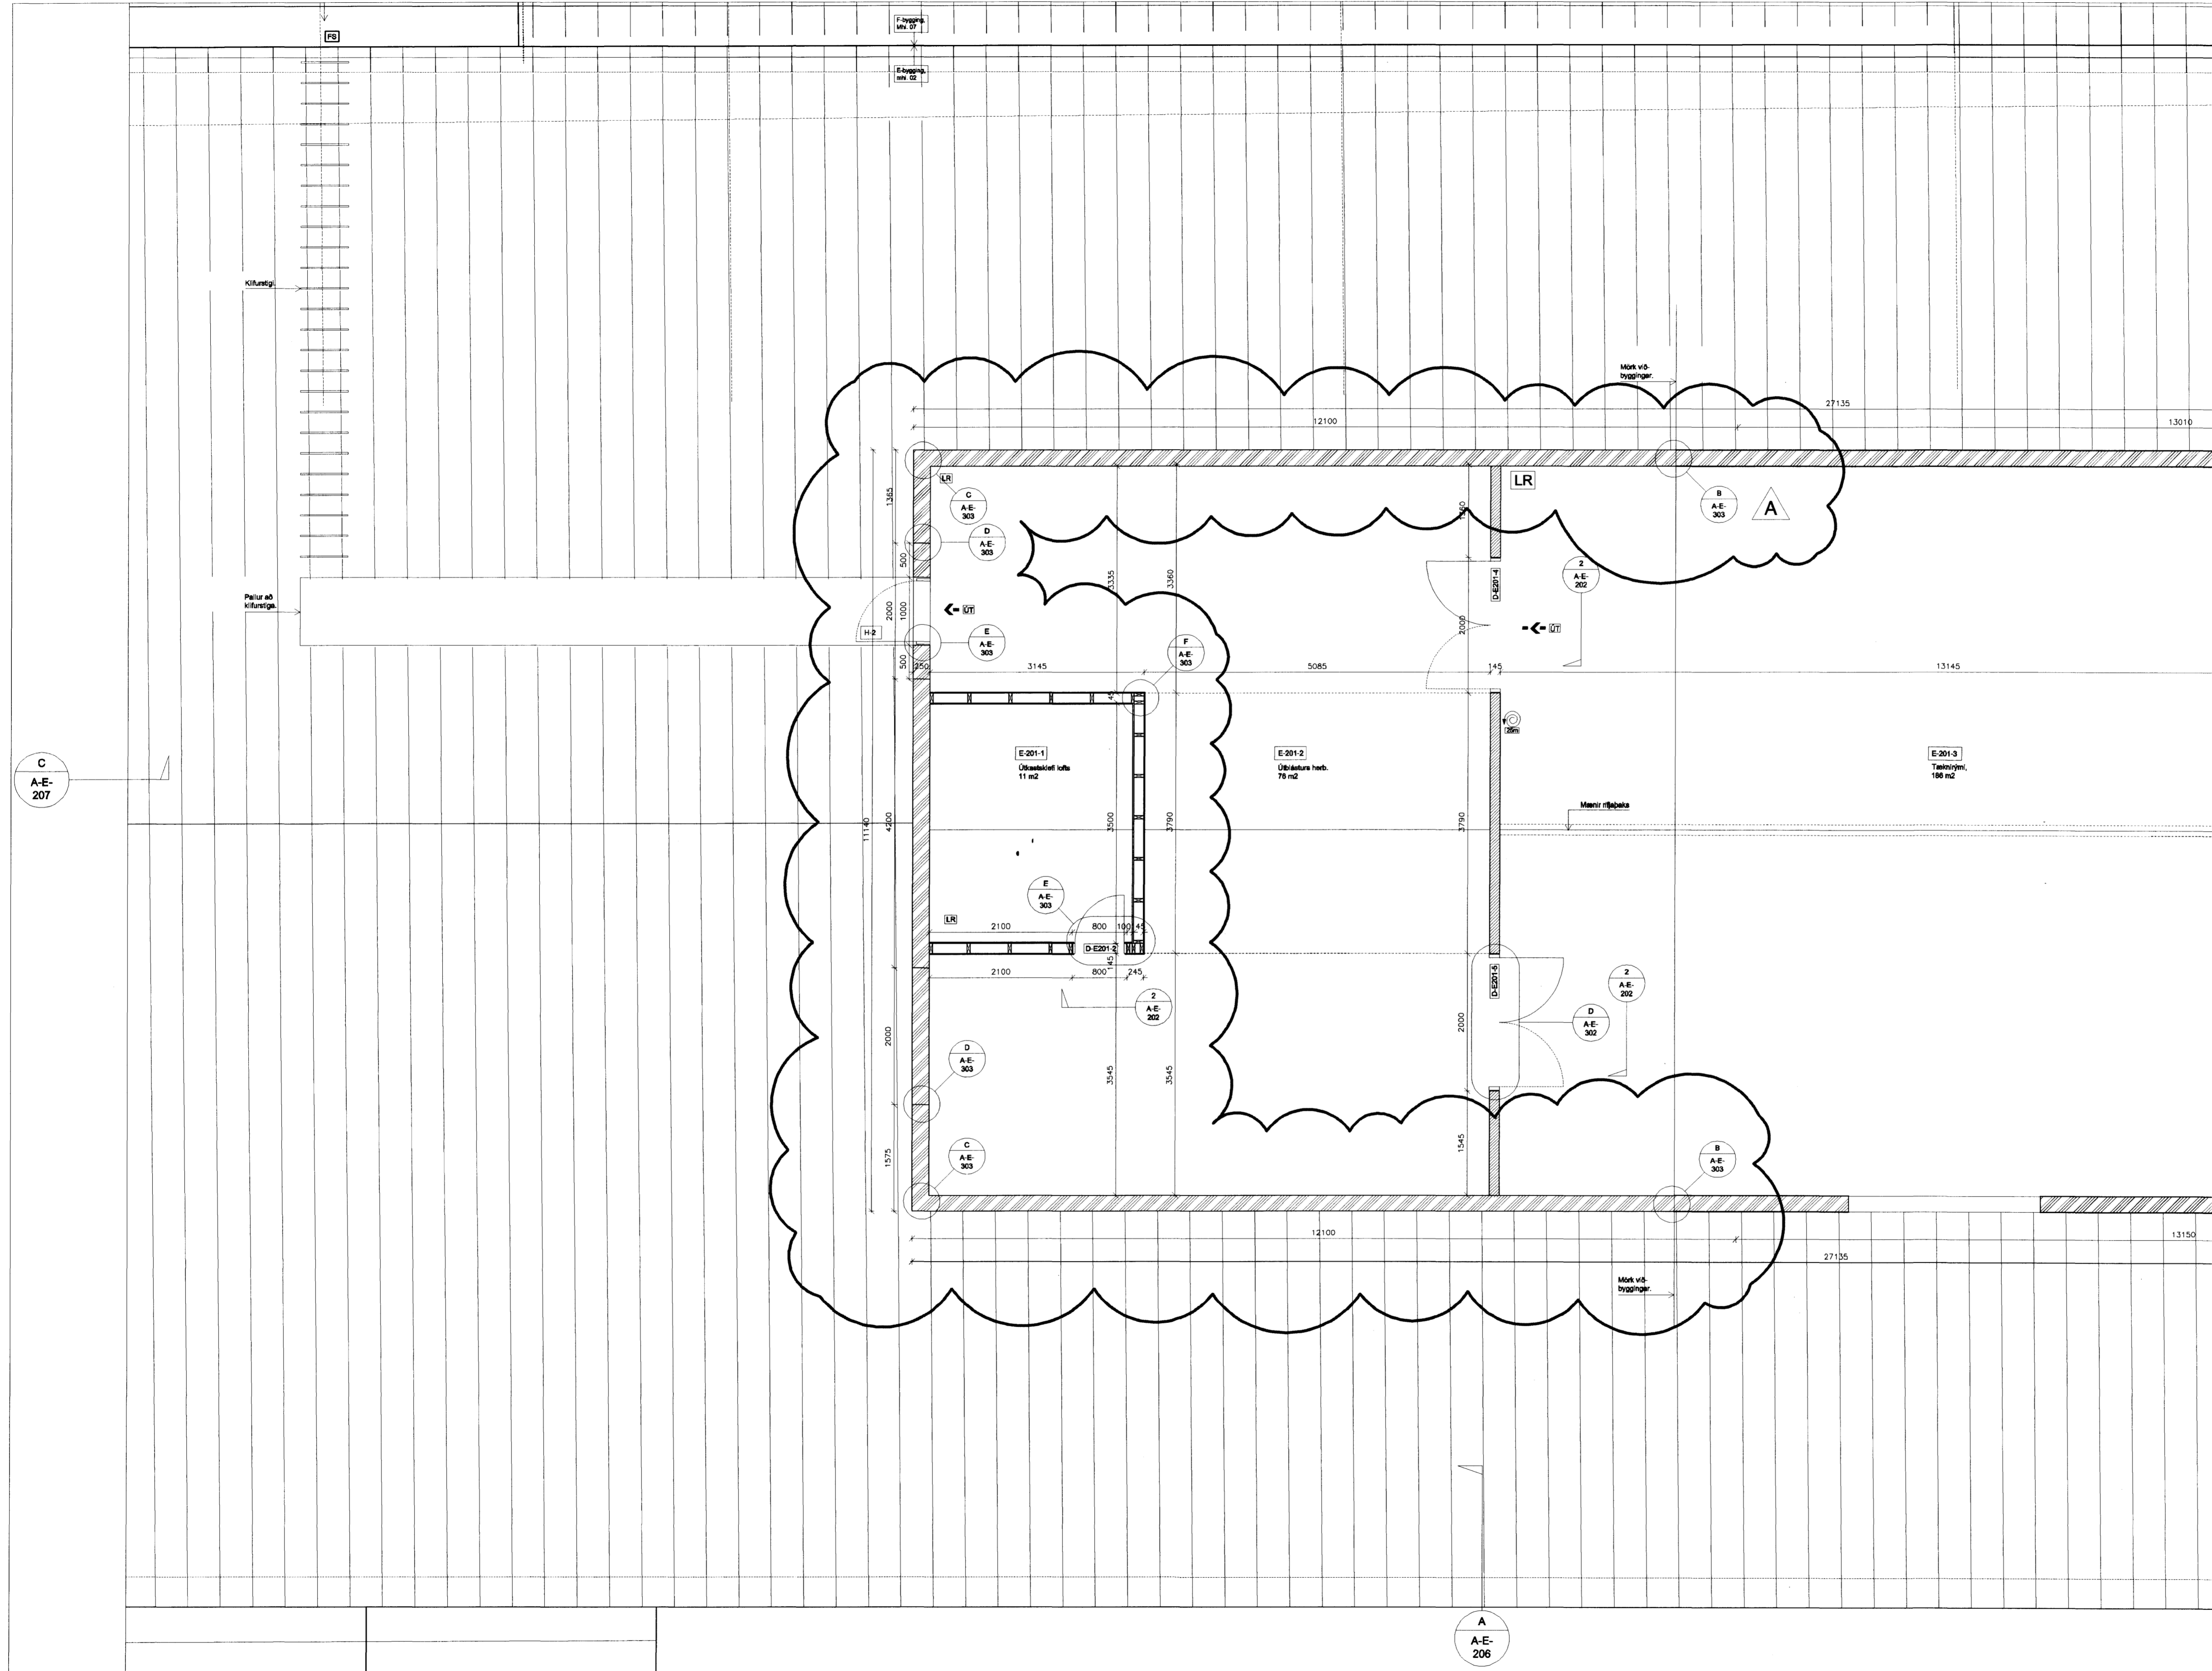

GRUNNMYND 2.HÆÐAR, 1:50