



Níli Indriásson
181144-3949


PLAN 1:50

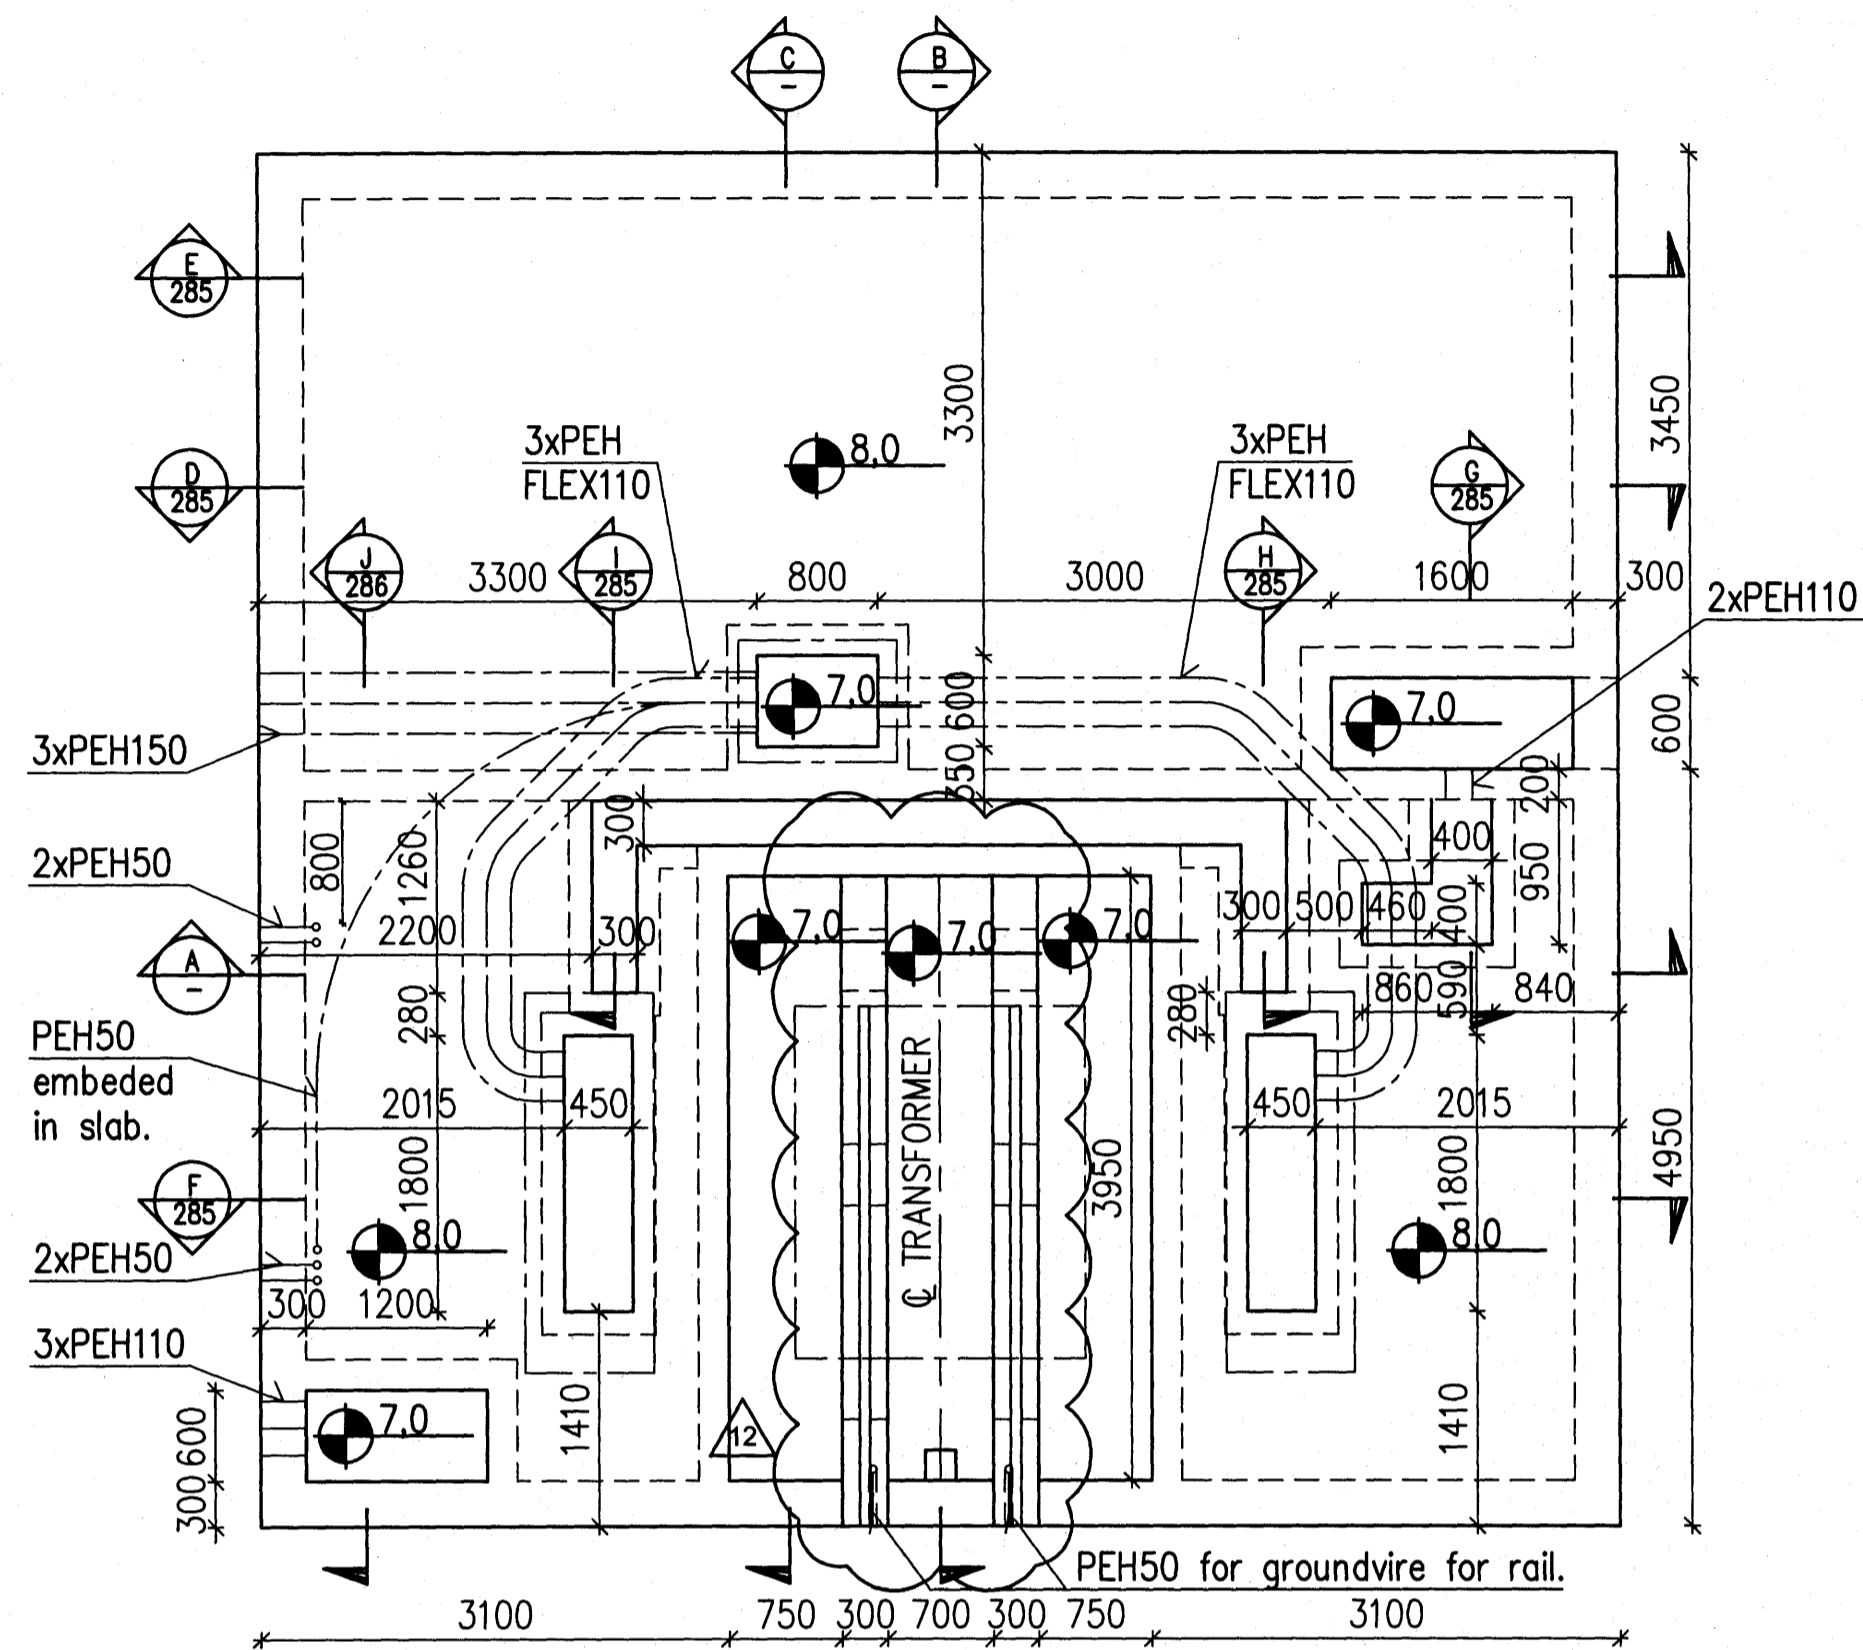



A SECTION 1:20

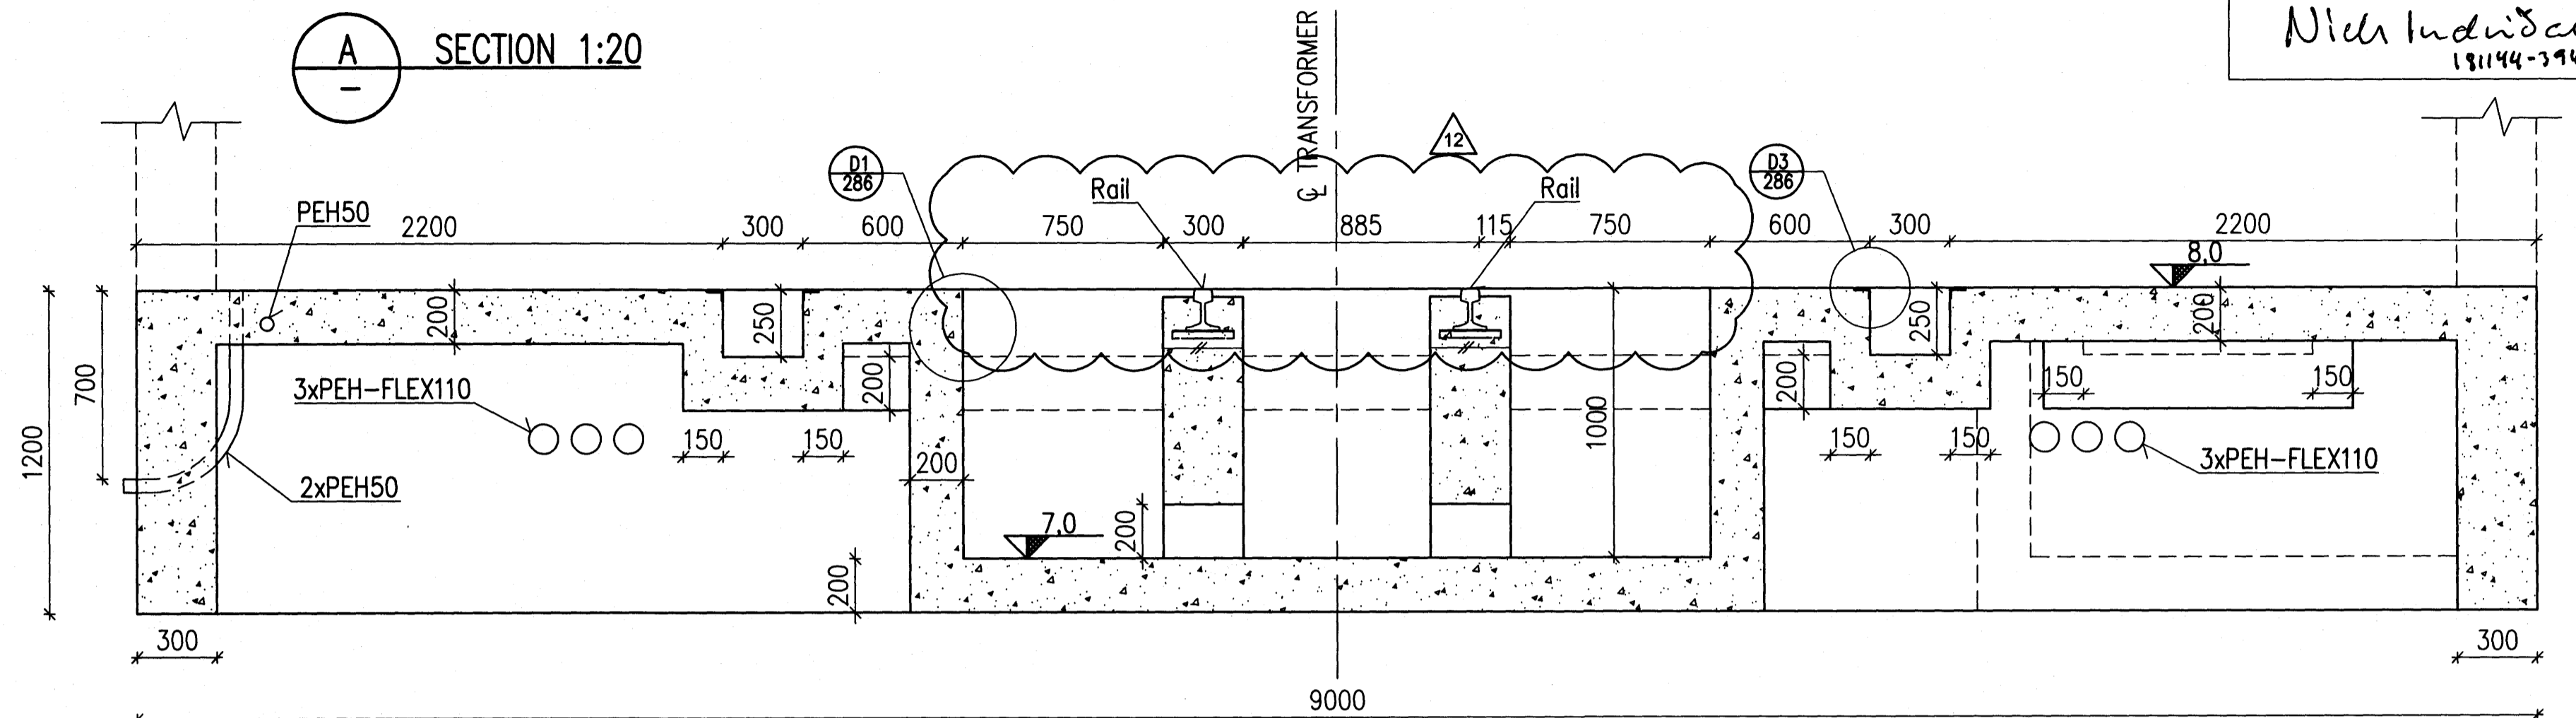

B SECTION 1:20

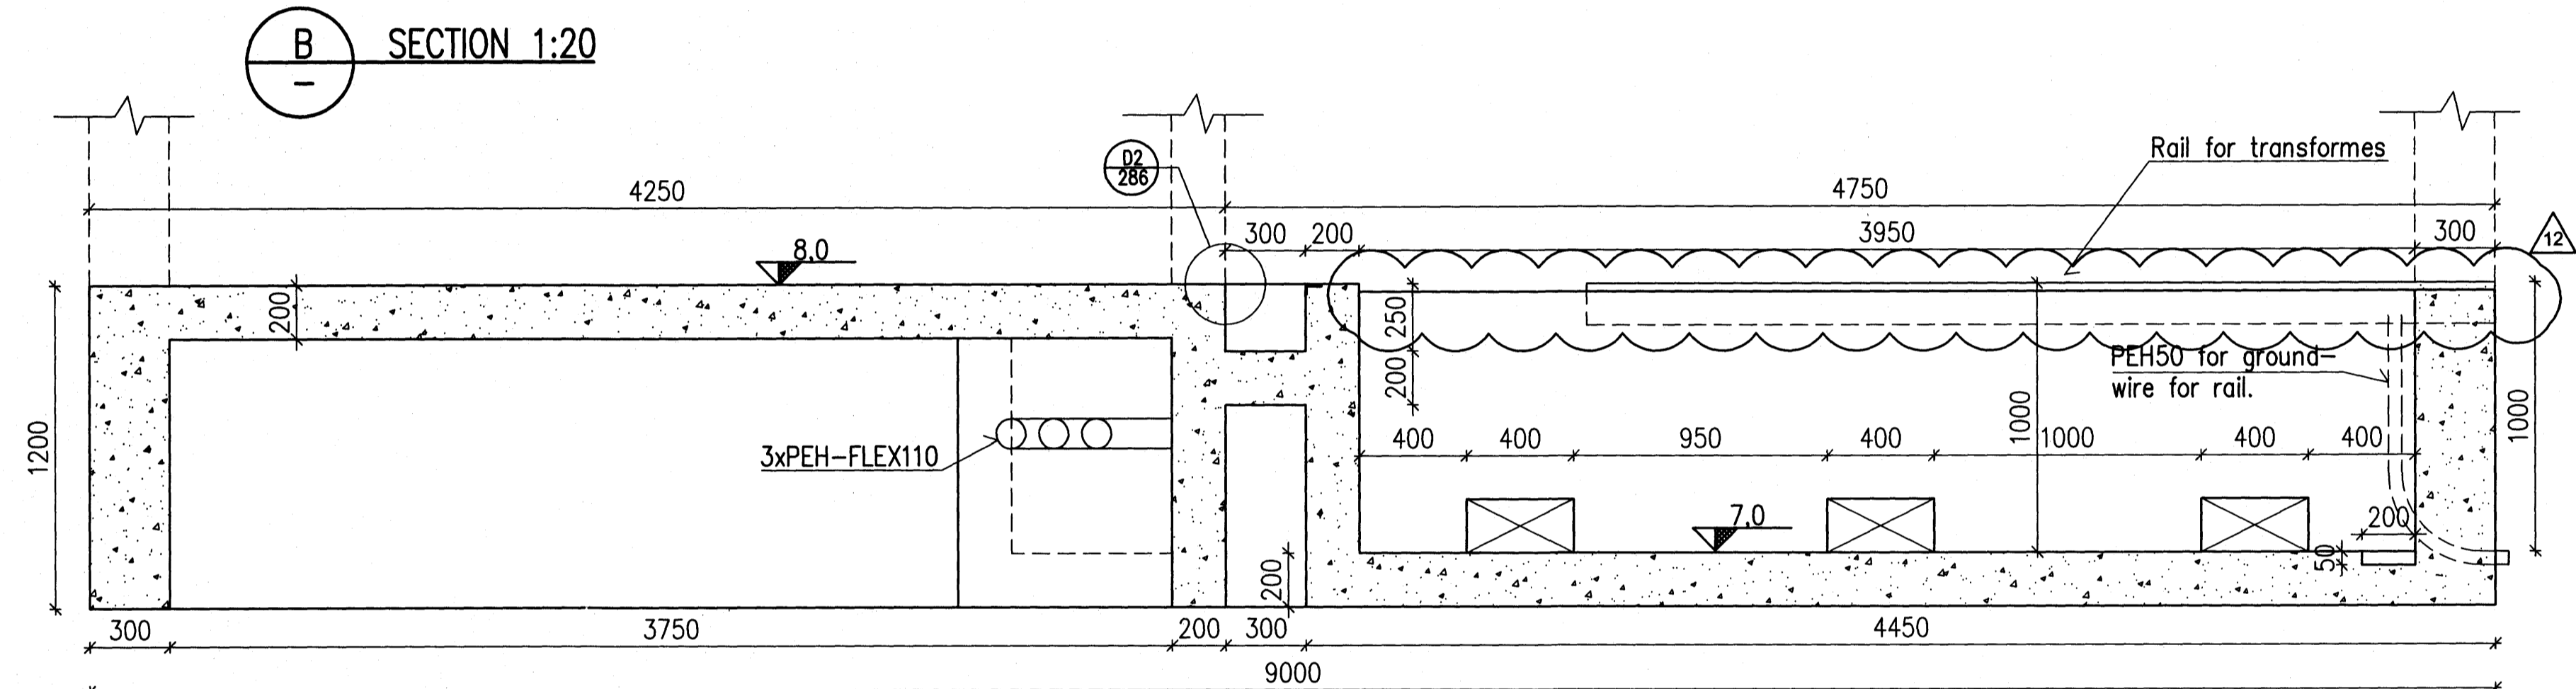

C SECTION 1:20

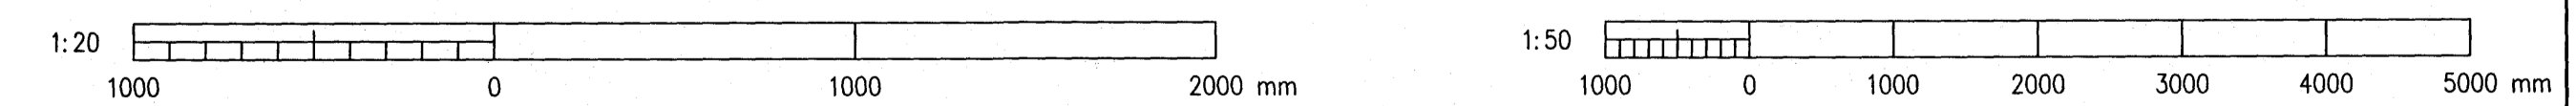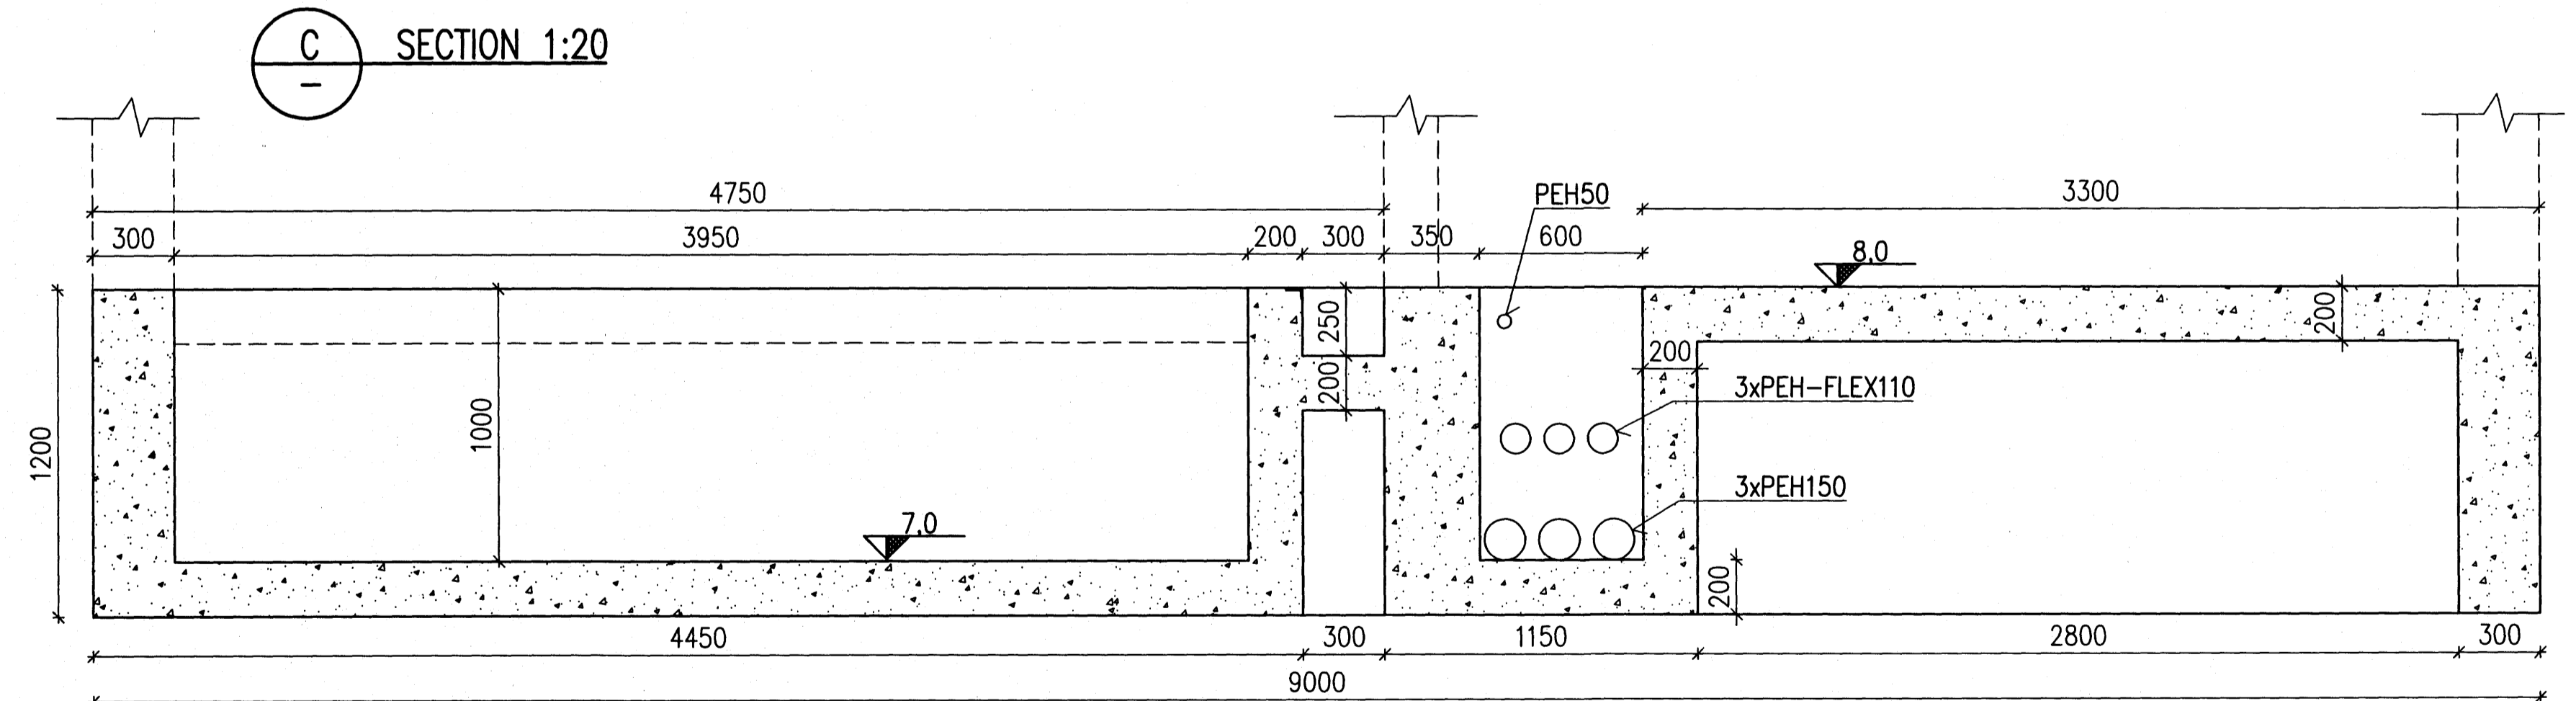

Skýringar:
Explanations: Concrete: C30/37: XF3
Formed surfaces: F2
Reinforcement steel: B500C
Structural steel: S235JR
Insulation: Rockwool

Also see IDP-410-CA-000-030 for concrete and IDP-410-ZA-000-060 for steel.



Breytl. Rev.	Breyting Revision	Dags. Date	Samp. Approved	Nokk. heiml. Released
12	Transformer rail elevation	10.06.28	NI	
11	Issue for construction	10.05.06	HFB	

Samsettn. teikningar nr. ISAL
Ref. drawing no. of ISAL

This drawing is the property of the Rio Tinto Alcan Iceland Ltd. and handed out for personal use only. It may neither be copied nor made available to others without permission of the Rio Tinto Alcan Iceland Ltd. The receiver is liable for any misuse.		Fjöldi stykja Number of pieces	Hlutur Object	Atriði Item	Efni Material	eo.stk Weight	totalt í heild (kg) Þyngd	Athugasemdir Remarks
IV	III	II	I	IDP 410 - SUBSTATION PL3 - BOOSTER BUILDING FOUNDATIONS & FLOOR SLAB	HRV			Stærð Scale A1 Kostn.nr.-búnr. / C0no.-Eq.no. 4011 AKS no.
Verktali / Supplier		HVR		IDP-nr. verks / Dra.no of suppl. IDP-410-C0-073-284		C		
Tilknað Drawn		HFB/AFV 2009.01.08		Virtuall. / Checked NI		Sambýktur / Approved Níli Indriásson		
Stærð Scale		ISAL		Rio Tinto Alcan		Stærð Scale A1 Kostn.nr.-búnr. / C0no.-Eq.no. 4011 AKS no.		
Tilknað Drawn		Virkir og ákaf Checked and filed		Nokk. heiml. Released				