


VINNUTEIKNING

DAGSETNING	BREYTING	SAMÞYRK
22.11.2004	A GLUGGI G3	
13.5.2005	B BRUNAOP F/ERÐ	ÖB
	C	
	D	

STADUR: AKURHOLT 1 HAFNARFJÖRÐUR		
VERK: HVALEYRARRSKÓLI 4.ÁFANGI		
TEIKNING: ÚTLIT		
VERKNR: 324c	MÆLIKVARÐI: 1:50 TEIKNAD: 15.11.2004 SSP ÖH	TEIKN.NR: 222
ARKITEKTASTOFAN ehf. Ormar Þór Guðmundsson og Ómóður Hall Borgartún 17 IS-105 Reykjavík Sími 562 6833 Fax 562 6835 arkitektastofan@arkitektastofan.is www.arkitektastofan.is		

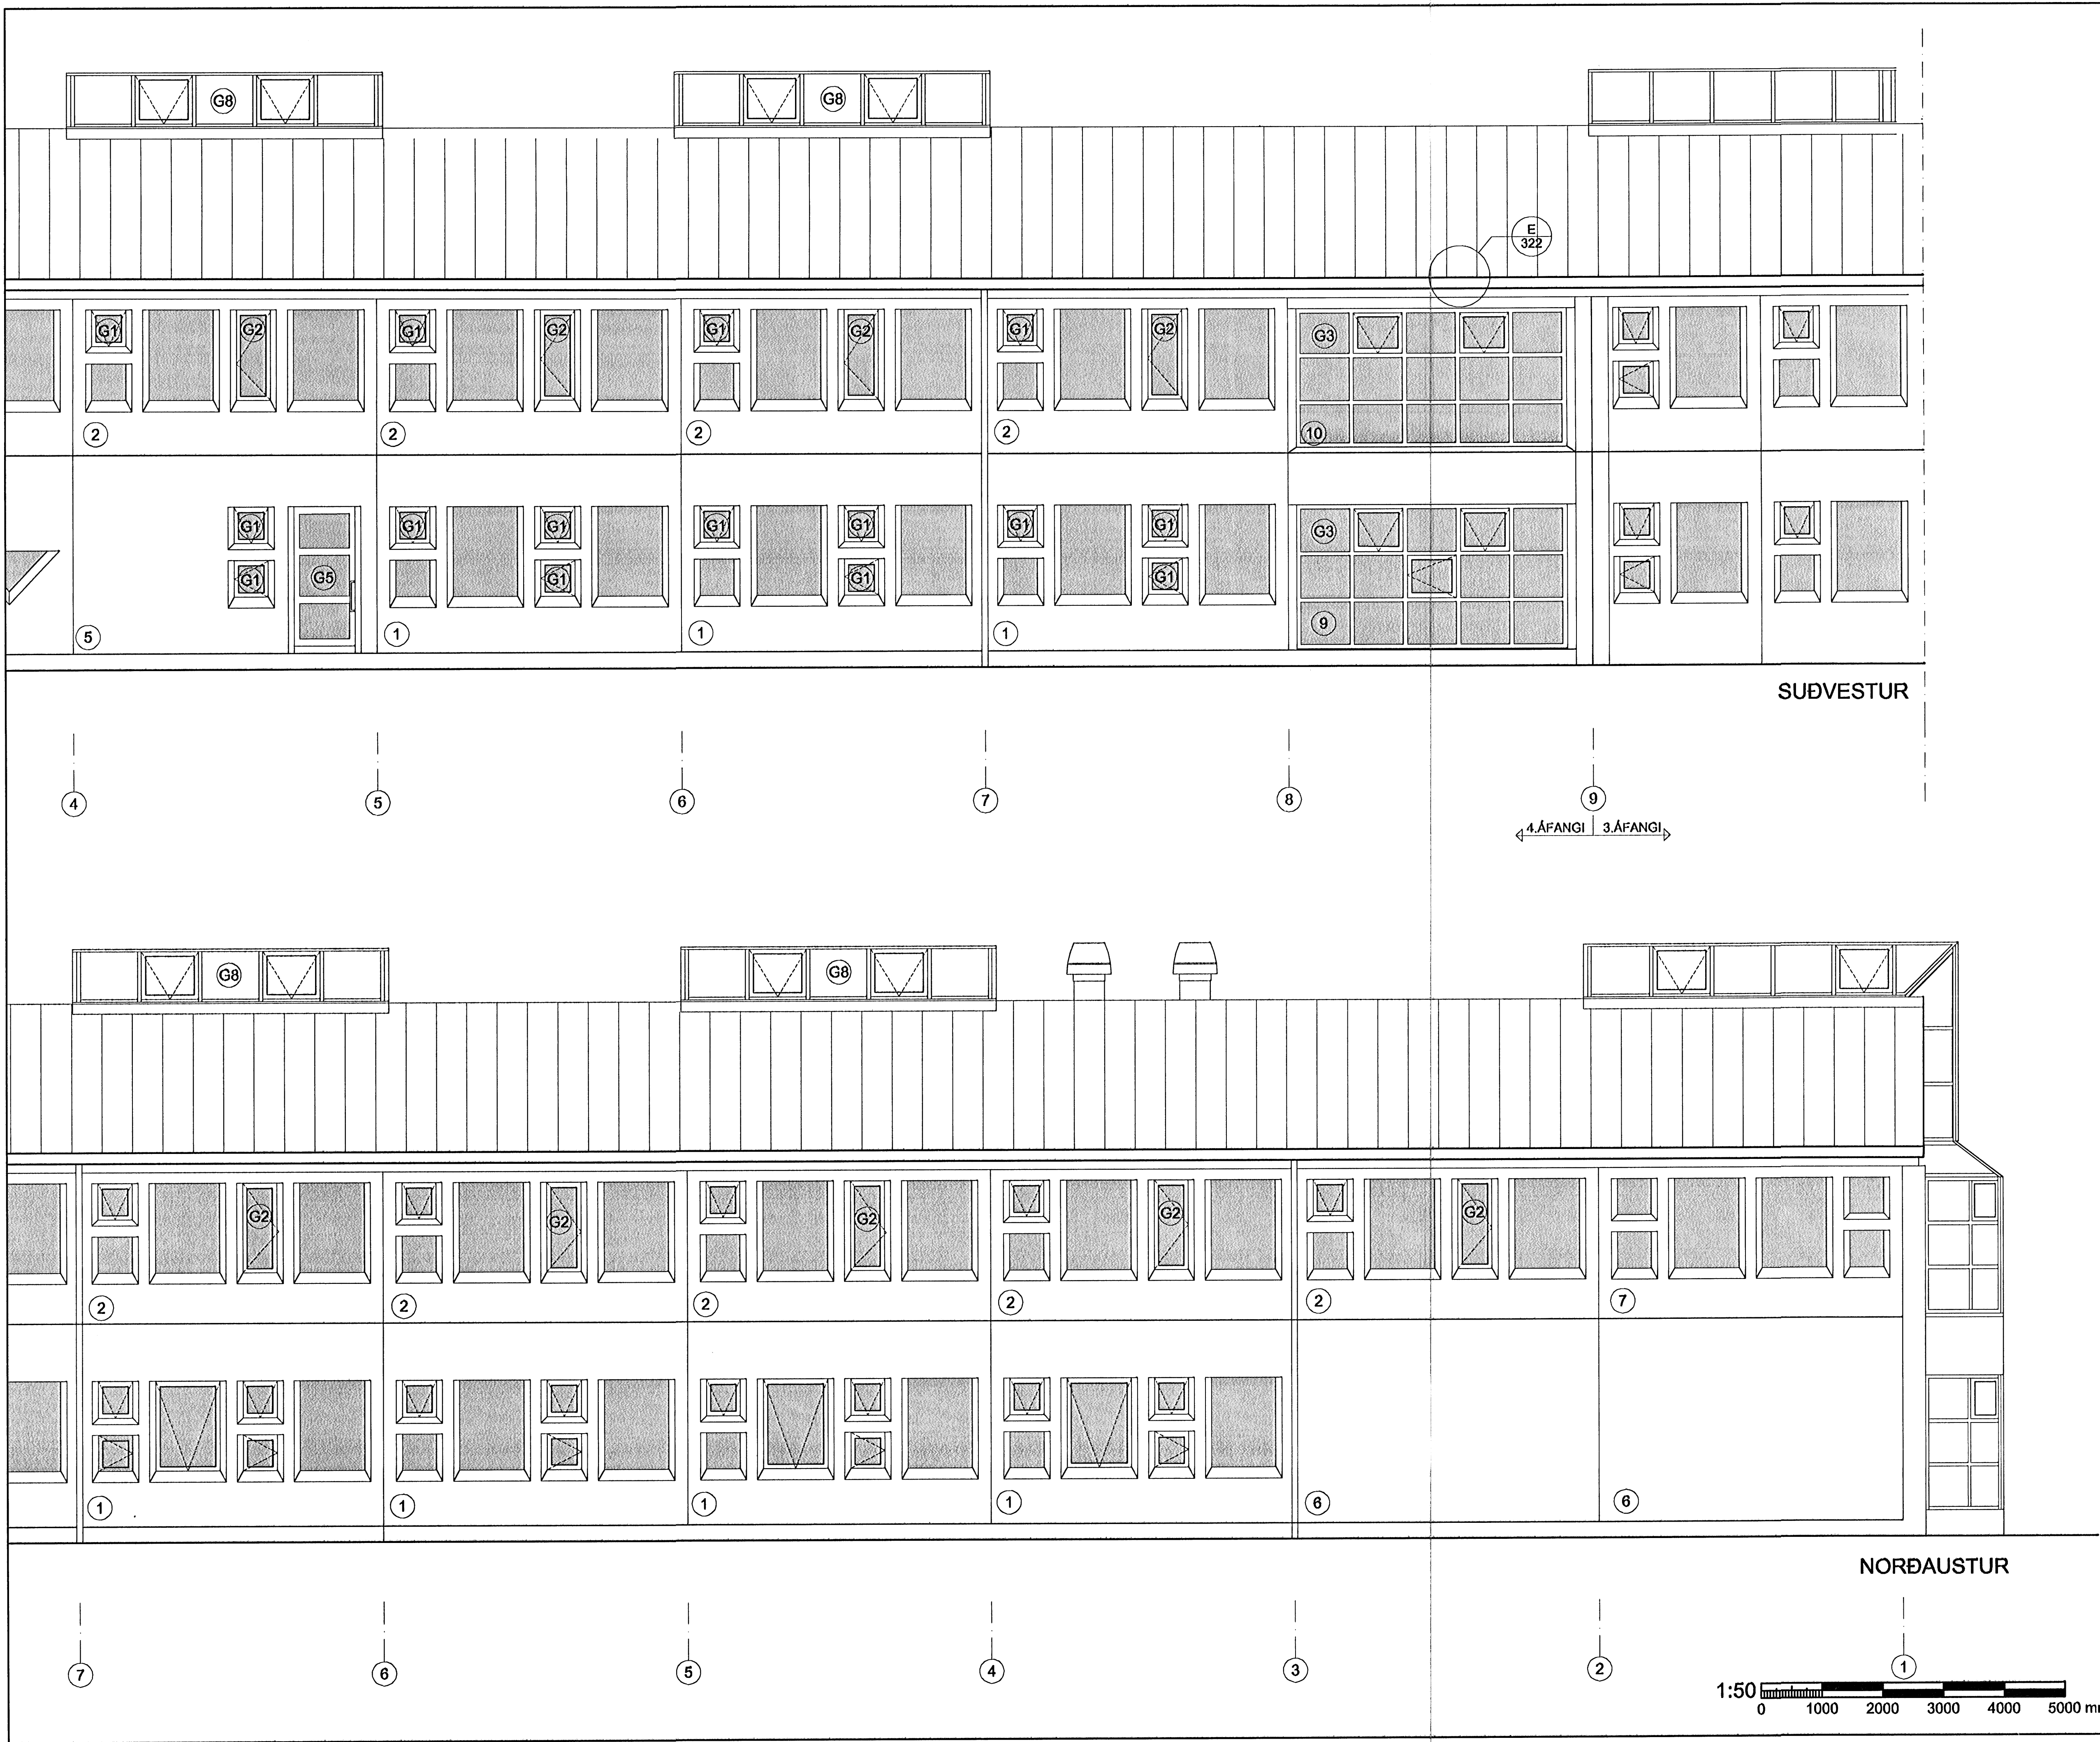