
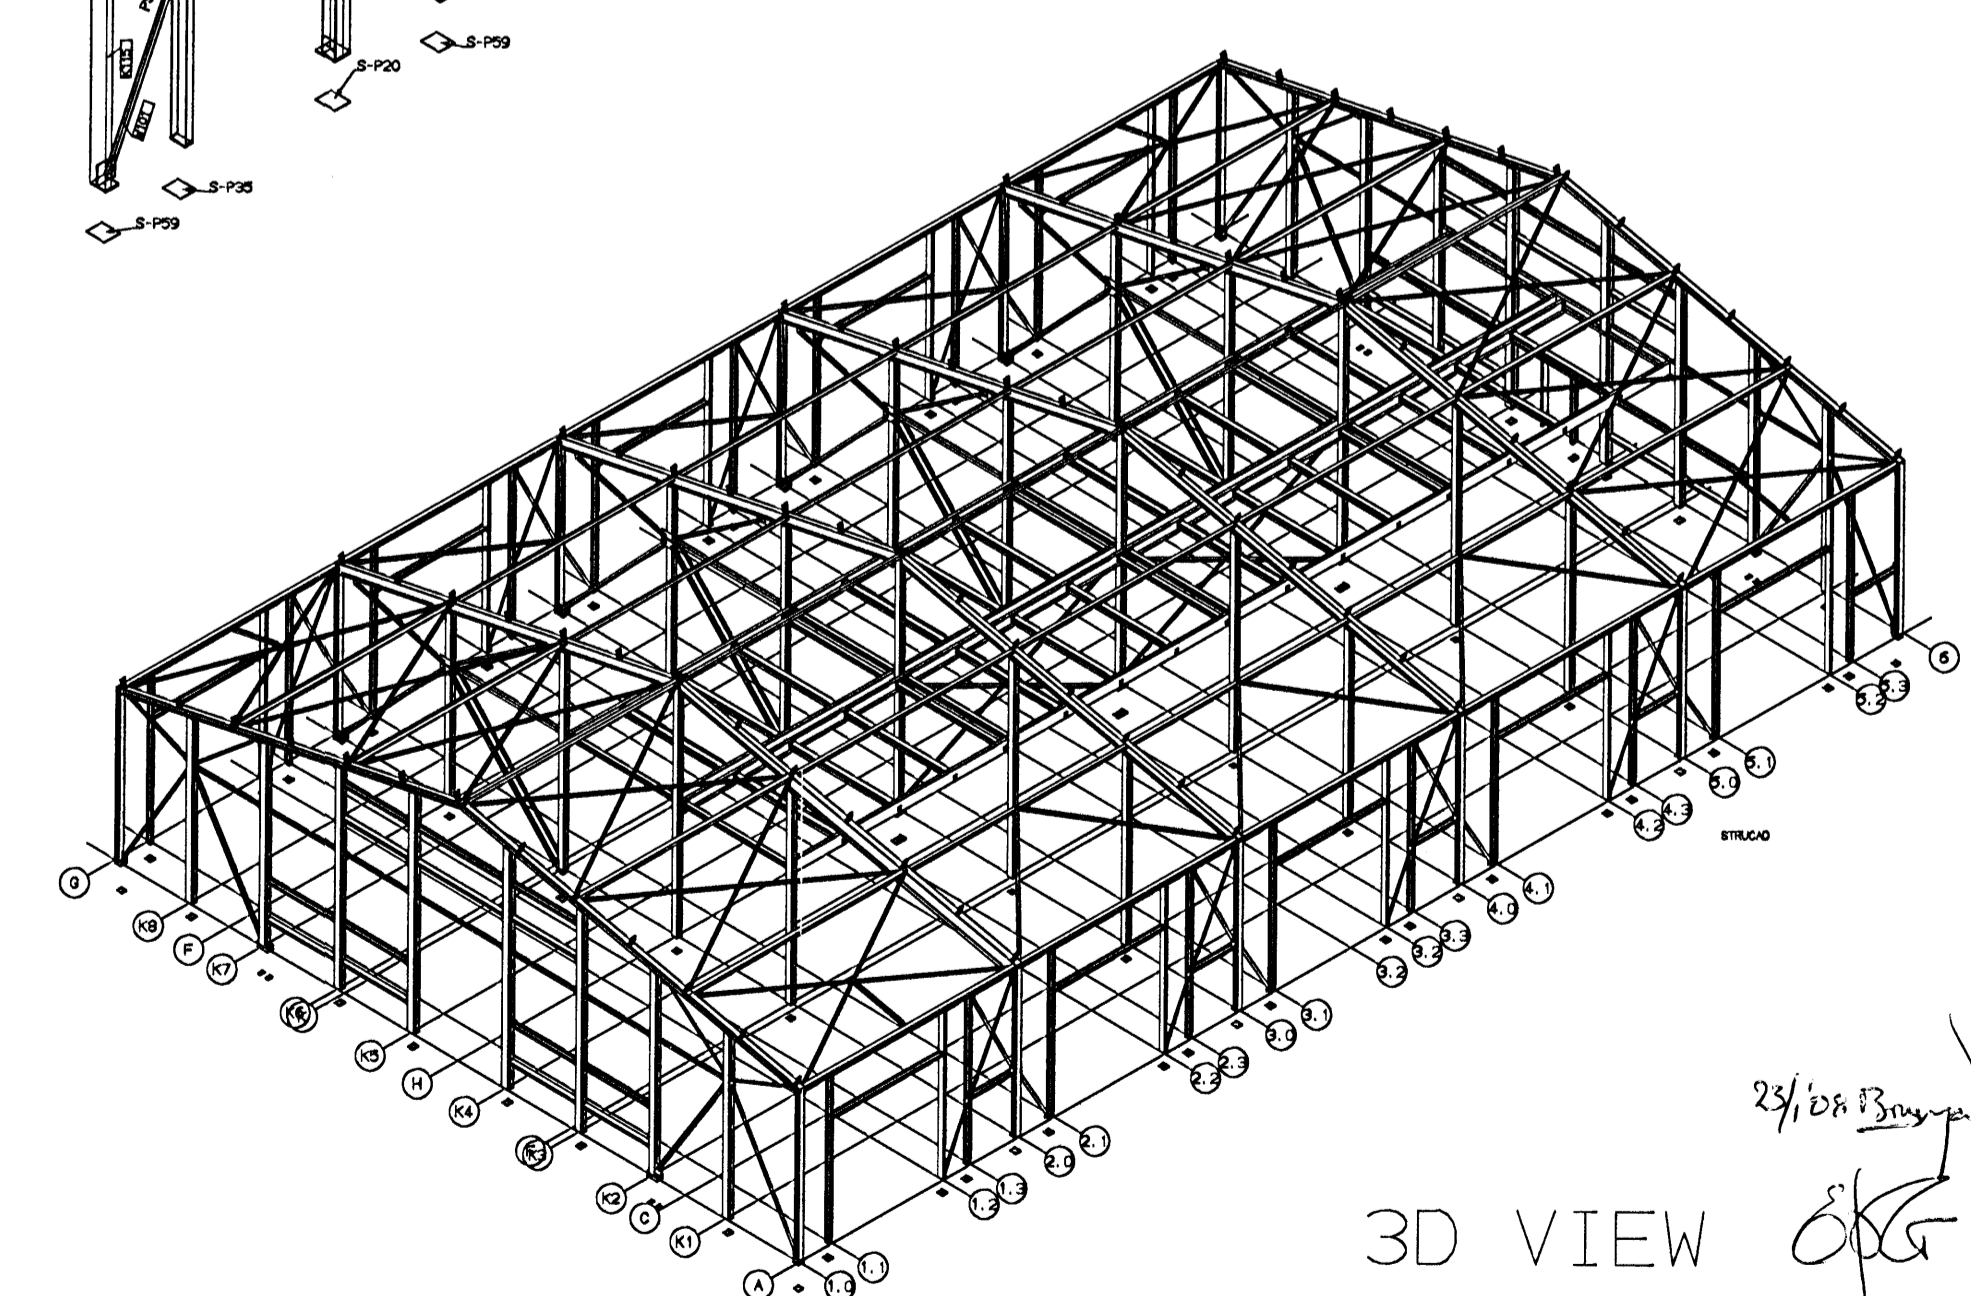


13 FEB 2008
 NIS

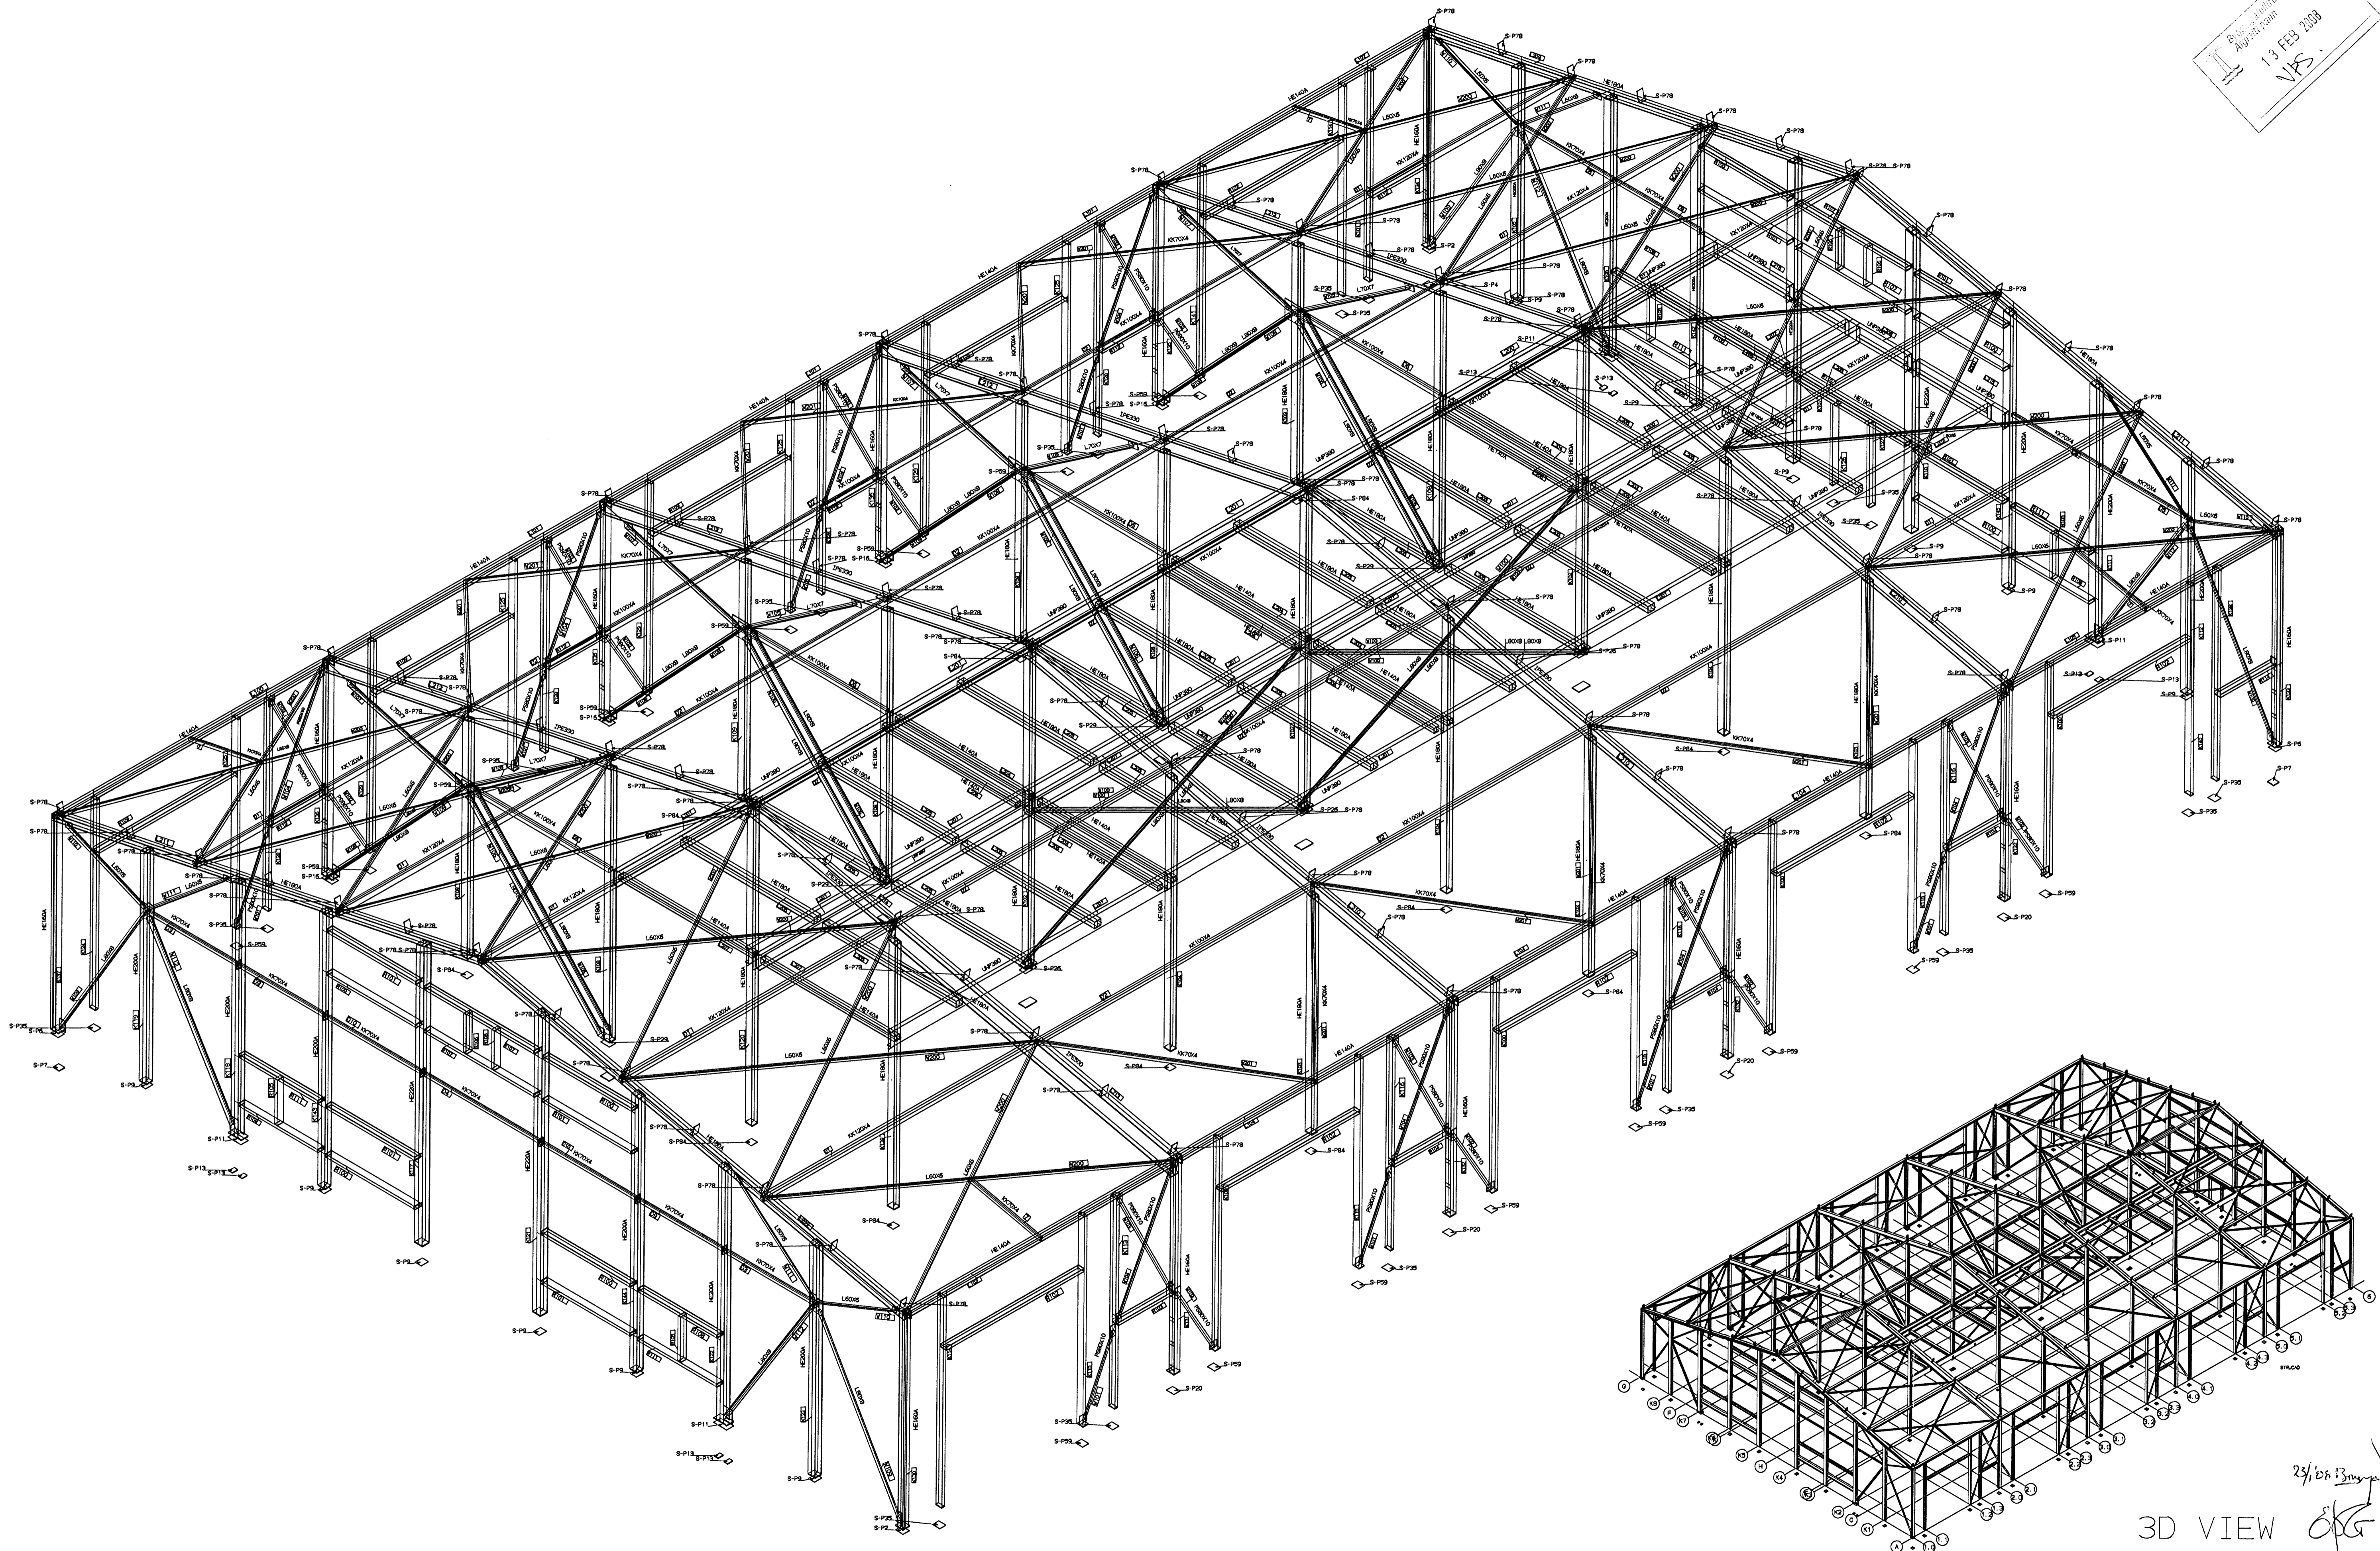

23/08/07

3D VIEW
 FOR APPROVAL

NOTES HOLES + BOLTS ◊ STUDS X

VAN DE BOVENKAMP STEELCONSTRUCTORS		PROJ. NAME Stalgrindarhuss CLIENT Stalfeлагid EHF LOCATION Gjahella 11 ICELAND
P.O. BOX 119 Tel.: 0031 (0)342-491783 E-mail: info@bovenkamp.nl	3770 AC Barneveld Fax: 0031 (0)342-416834 www.vdbovekamp.nl	ENGINEER DOLF Z REVISION TIME 17.05 REVISION DATE 29/11/07
ISSUED REVISION A	PROJECT No. 070801 DRAWING No. 03	A1