



Bygginguáttir Hafnarfirði
Mjöglet þann
12 FEB 2008
VPS

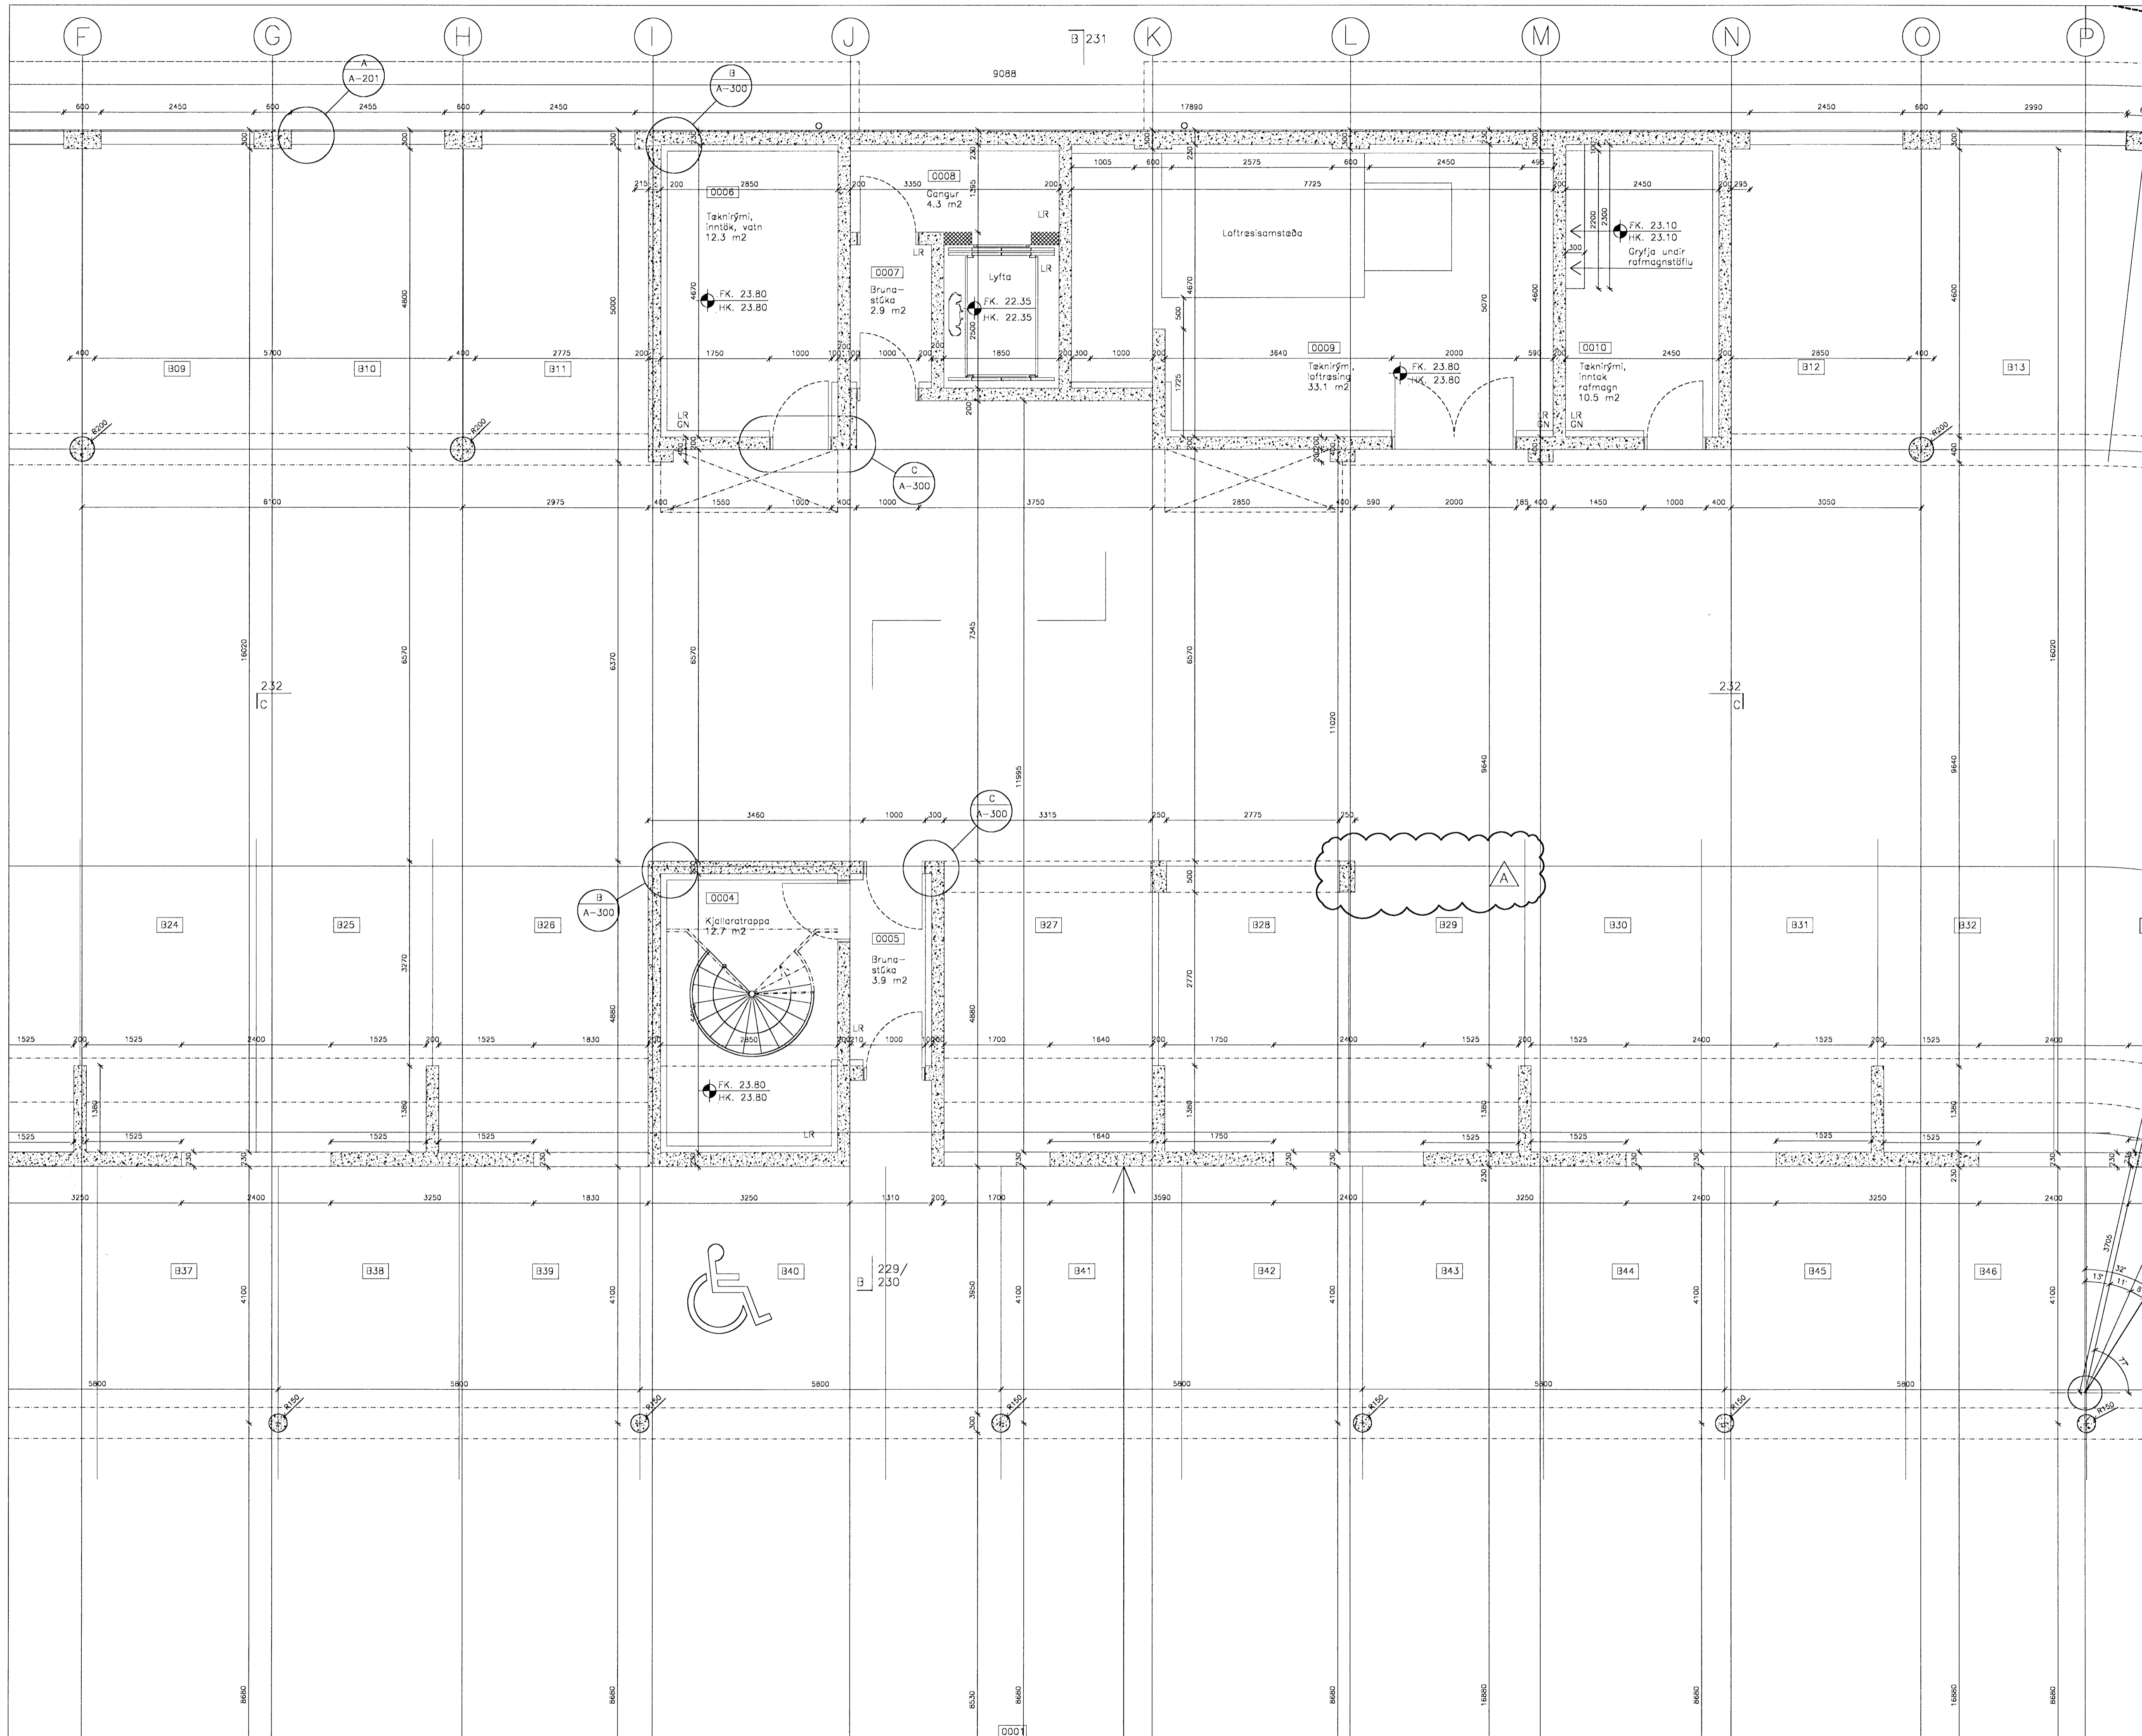

D:
C:
B:
A: Söla 1 ínum M/2 til L/2. 06.02.2008
BREYTINGAR: DAGS:

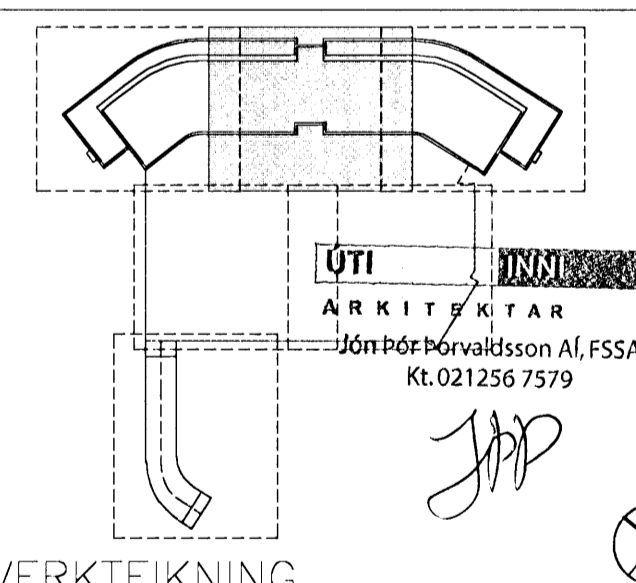

Dalshraun 3, Hafnarfirði
Ris ehf
VERK: DALS 0608
KVARDI: 1:50
DAGS: 14.01.2008
GRUNNWYND KJALLARA
BLAD 2 AF 6
TEIKN: GDB
SKRÁ0608-Grunnur.dwg

ÚTI INNI
ARKITEKTAR
HINGHOLTSSTRÆTI 27 101 REYKJAVÍK
SÍMAR 5527660 & 5627660 FAX 5527661
NETFANG u@u.is
VEFFANG http://www.u.is
BALDUR Ó. SVAVARSSON ARKITEKTAR FAI
1203557-5149
JÓN ÞÓR ÞÓRVALDSSON ARKITEKTAR FAI
021256-7579