



Byggingarfráttir HAFNARFIRÐI
 6. FEB 2008
 VBS.

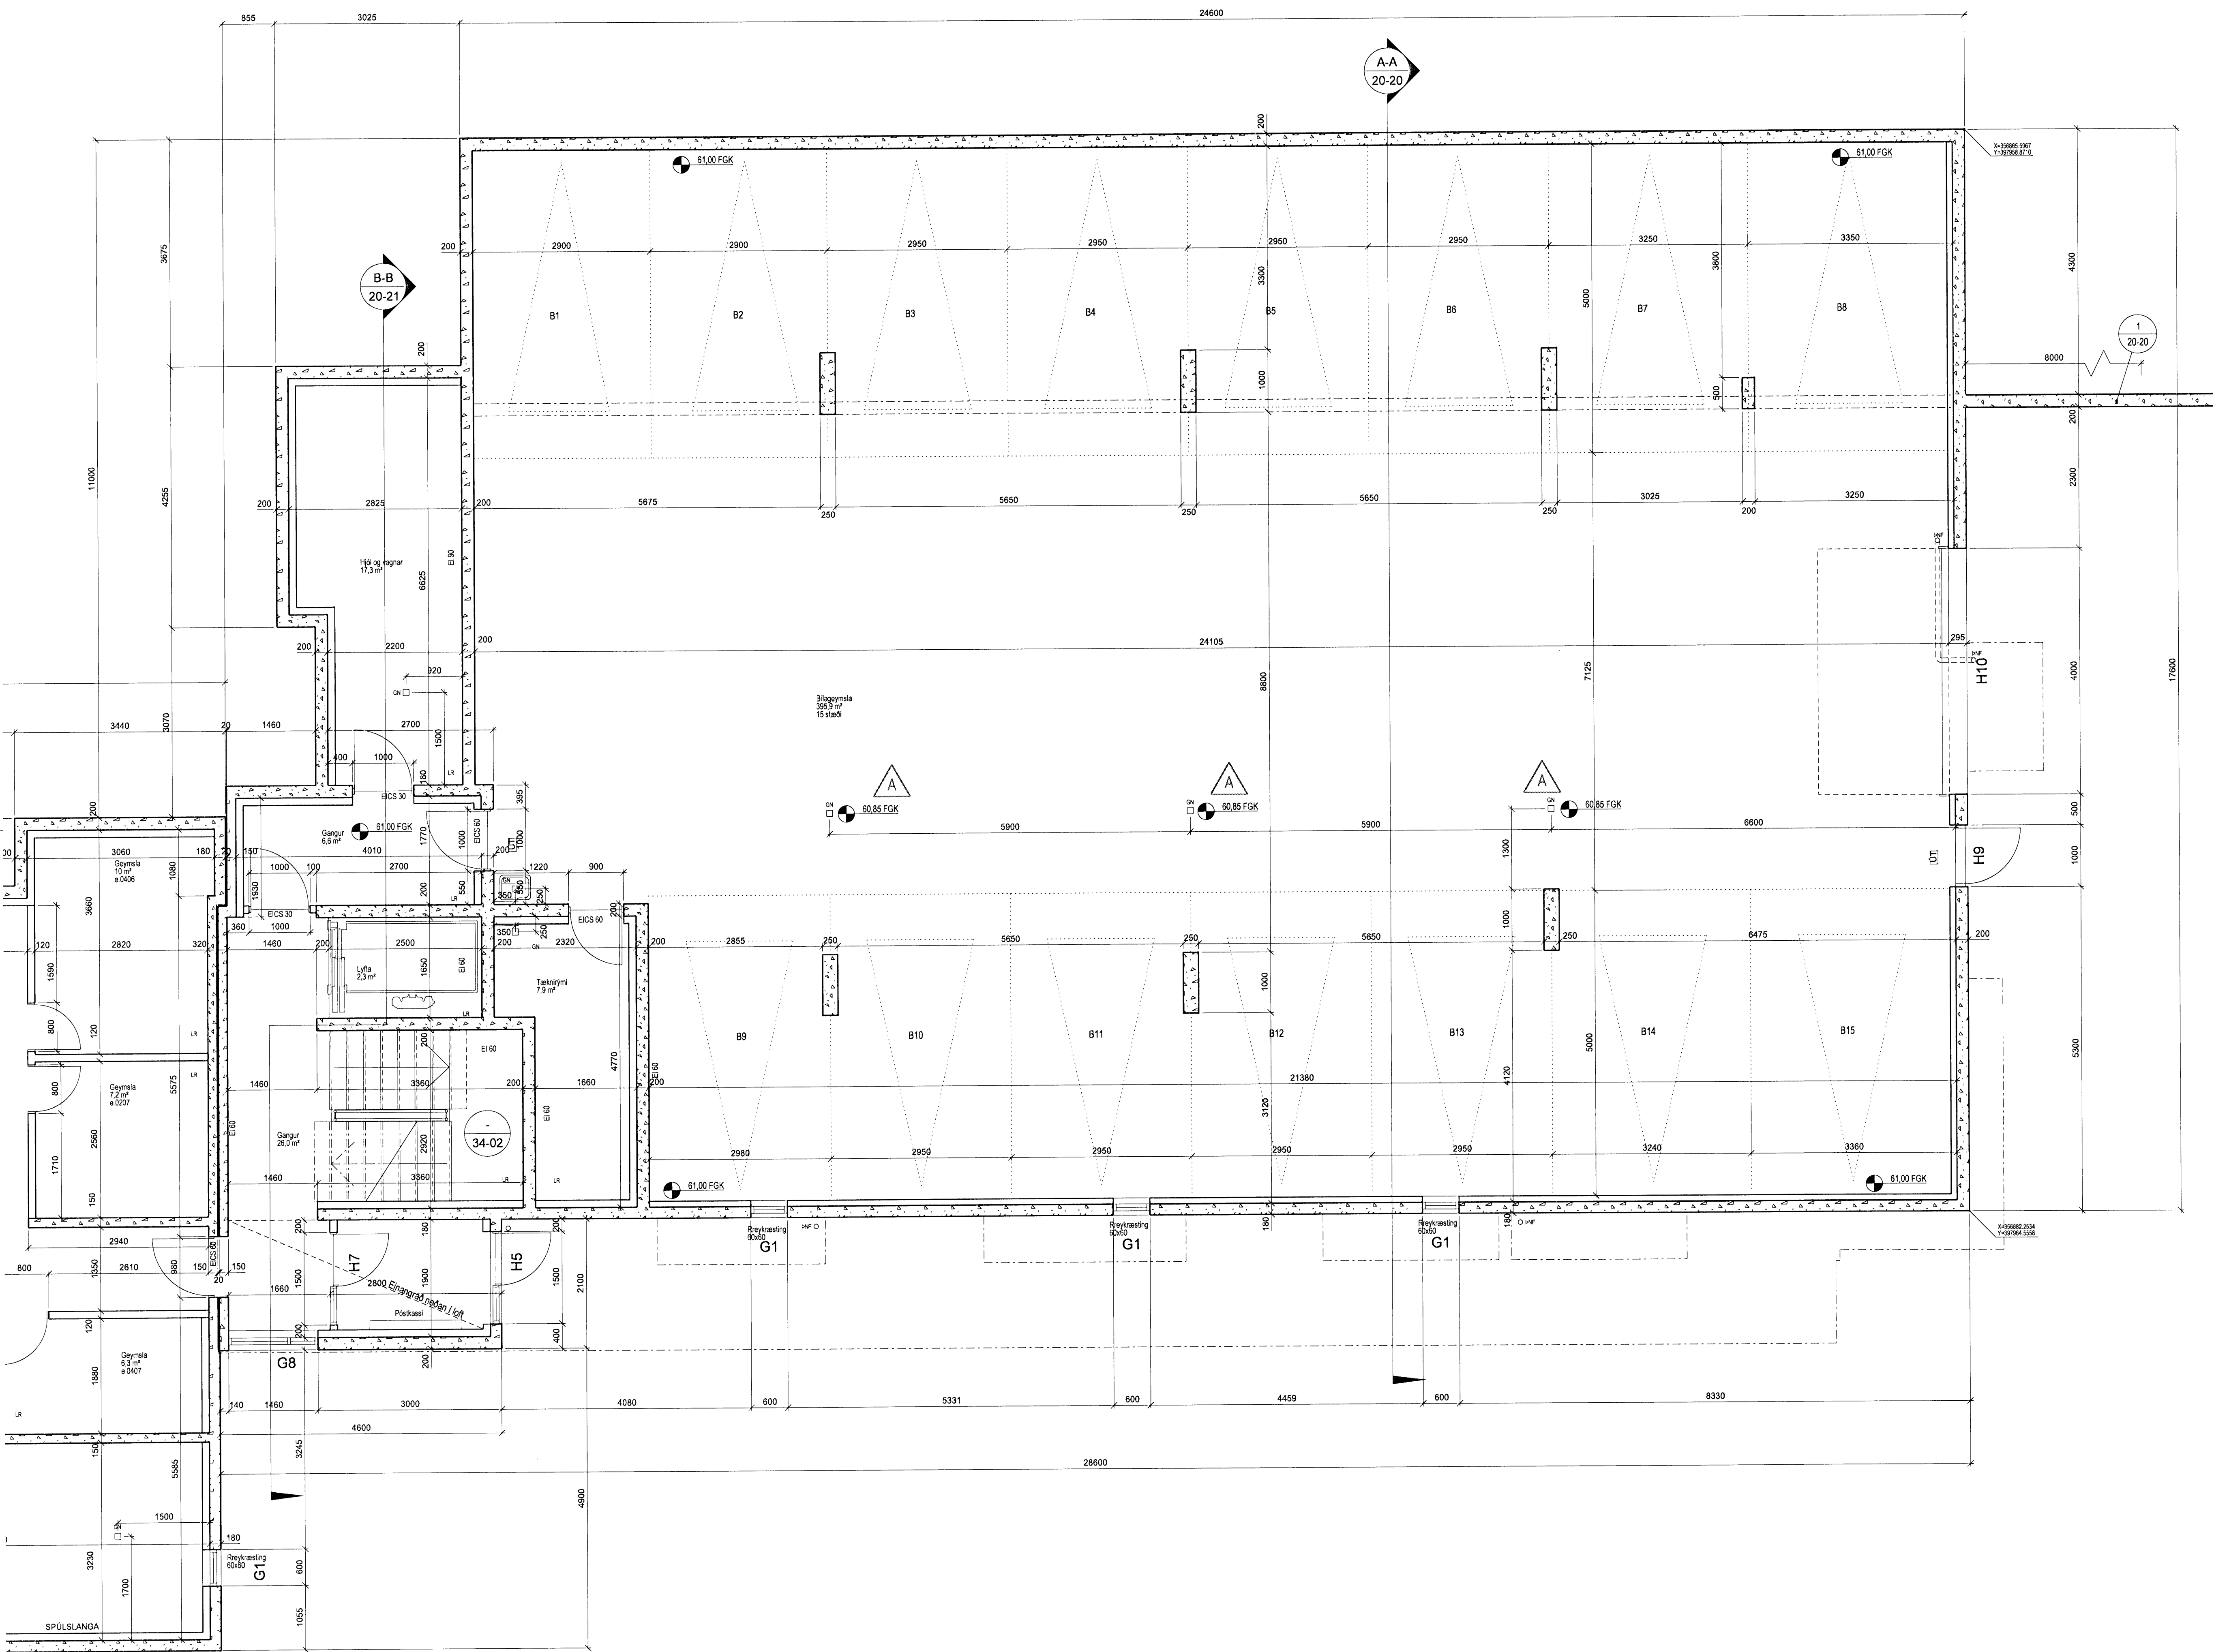

A	HMH	HMH	12.01.08
Kötum b'lageymstugólfis breytt.			
ÚTGÁFA	TEIKNAD	ISAMÞYKKT	DAGS
BREYTINGAR			

ASK Arkitektar
 Gæringsúti 9
 101 Reykjavík
 Sími 515 0300
 Fax 515 0319
 www.ask.is



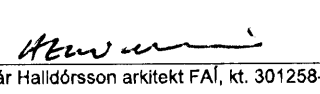Áritun aðalhönnuðar:

 Helgi Már Halldórsson arkitekt FAI, kt. 301258-7049

**BREKKUÁS 1-3
 HAFNARFIRÐI**
 VERKTEIKNING
 GRUNNMÝND 1.HÆÐAR
 BREKKUÁS 3

VERK NÚM	0668	NUMER TEIKNINGAR	20-02	ÚTGÁFA	A
----------	------	------------------	-------	--------	---

MRK. I A1	1:50
TEIKNAD	HTH/HT
DAGS	15.03.07