



Byggingarmáttillátning  
 Afg. 07/2008  
 21. JAN 2008  
 VSB

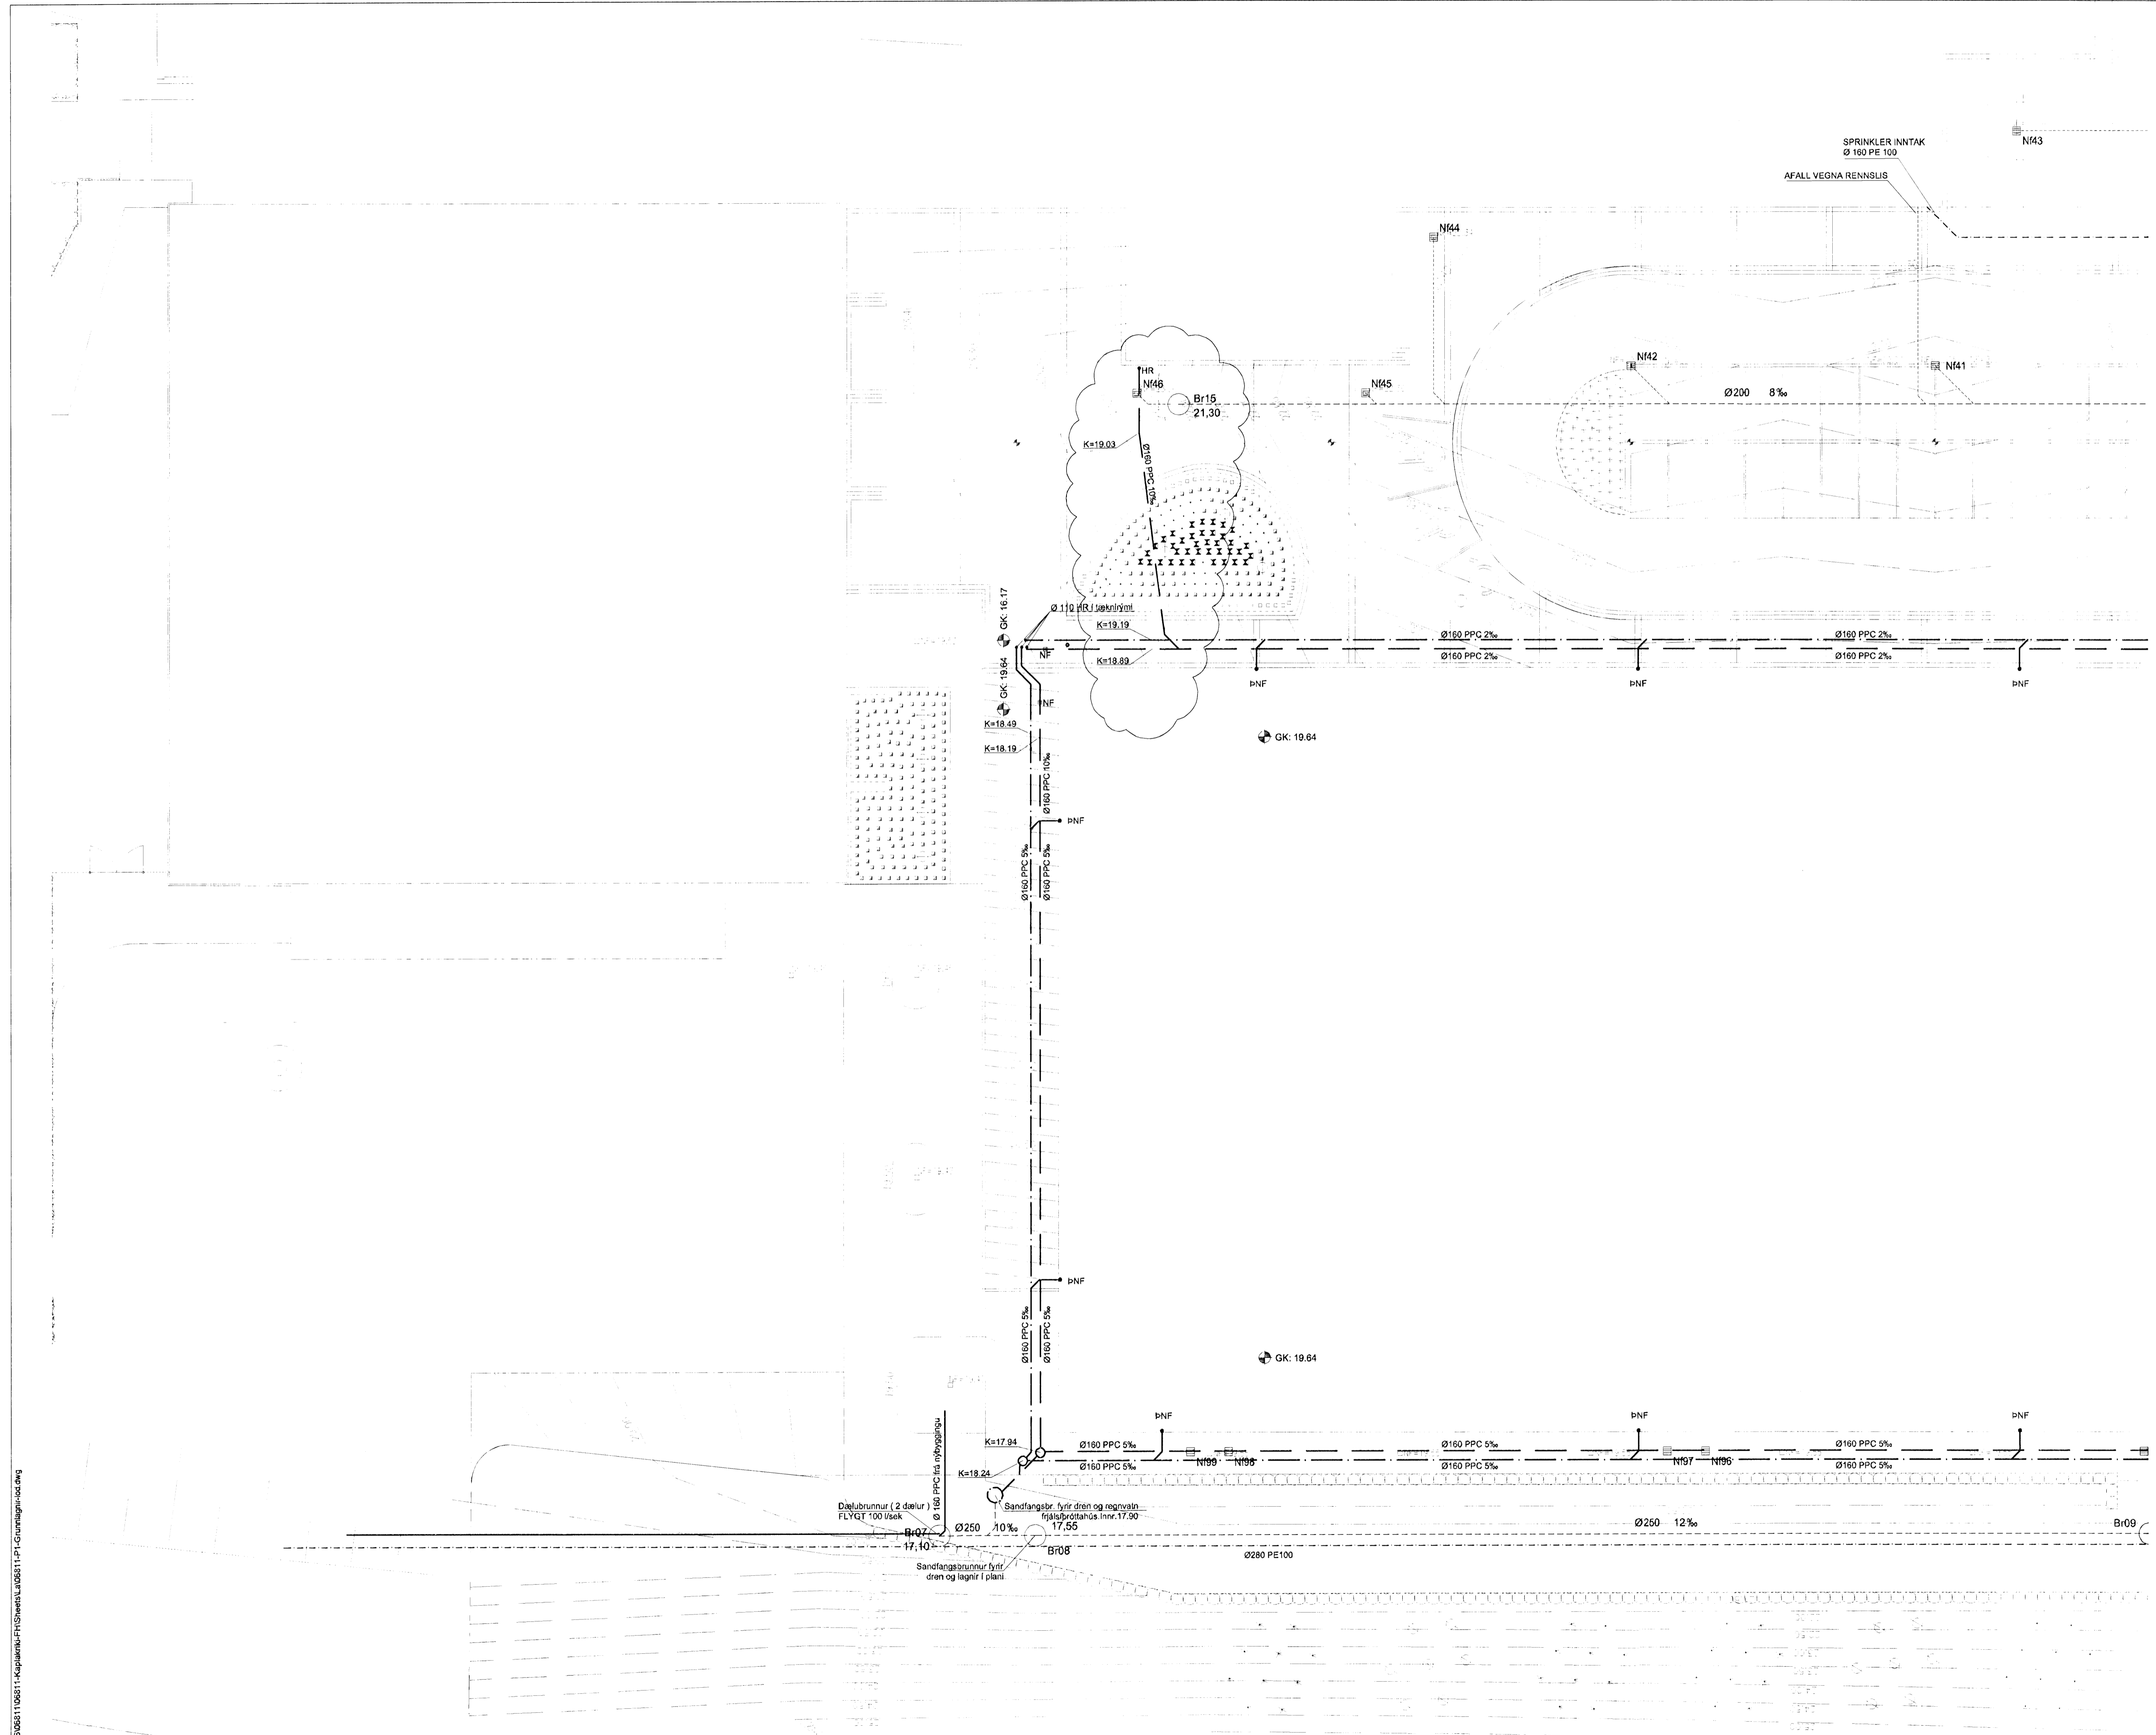

24.1.08  
 H. Jónsson

KAPLAKRIKI

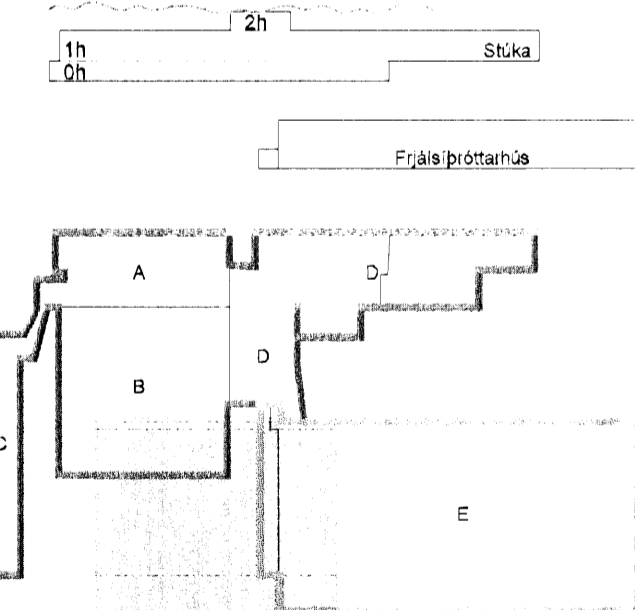

D	22.01.07	Bætt við dren	KM.J/SÁS
C	14.12.07	Tilfærslur á lögnum	KM.J/SÁS
B	07.12.07	Innsettur sandfangsbrunnur	KM.J/SÁS
A	23.11.07	Verkefningar	KM.J/SÁS
Útg.	Dags.	Skýring	Hannas/Yfirfarnd



VERKFRÆÐISTOFA

BÆJARHRAUN 20 · 220 HAFNARFJÖRÐUR · KENNIT. 710796-2899  
 vsb@vsb.is · Sími 585 8600 · Fax 585 8610 · www.vsb.is

Áritun sérhönnuðar Sveinn Aki Sverrisson Kf. 230855 5609

KAPLAKRIKI  
 HAFNARFIRÐI

Verkhúti					
Lagnir					
Grunnlagnir í lóð					
Grunnmynd					
Hannas	Teiknað	Yfirfarnd	Kvarði	Síða	
KMJ	KMJ	SÁS	1:200	/A1	-
Dags.	Verkefni	Teikning		Útgáfa	
19.02.07	06811	P1-6		D	

