

8

7

6

5


4

3

2

1

F

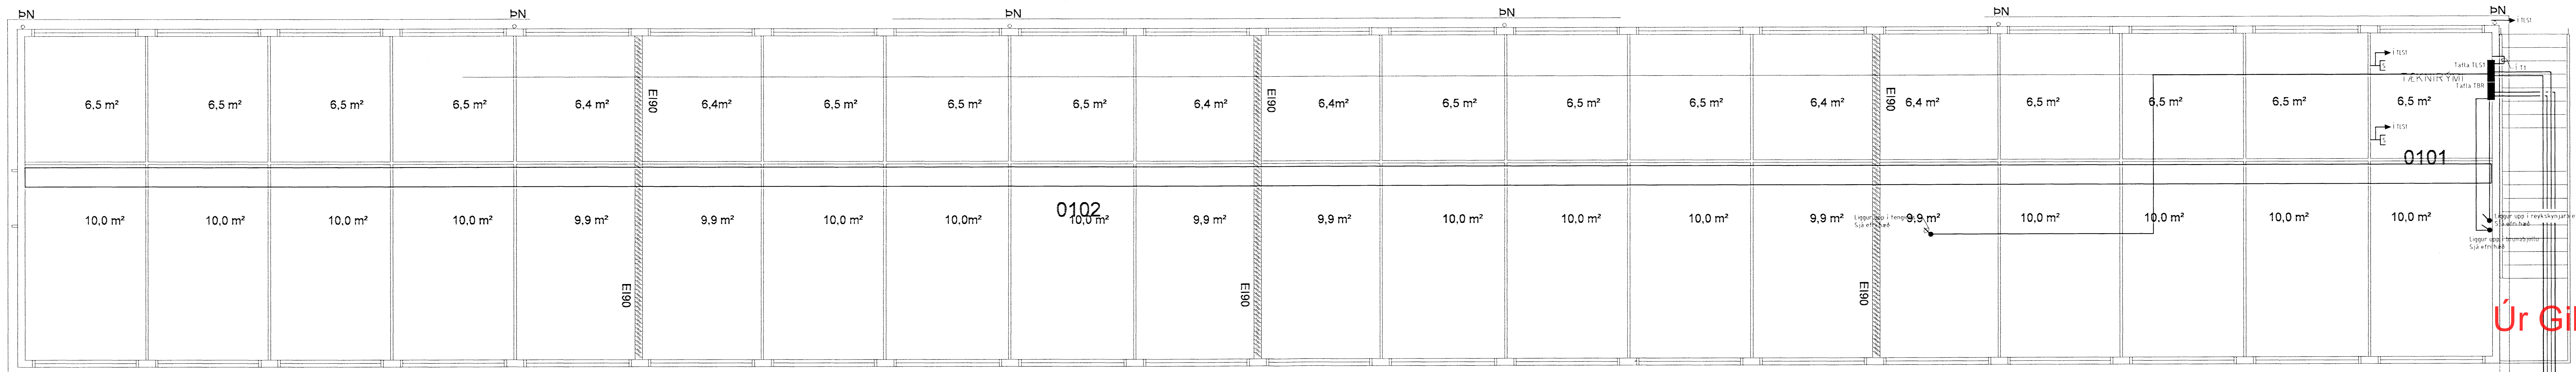


Úr Gildi

E


Byggingareitur fylgir ummáli húss.

D

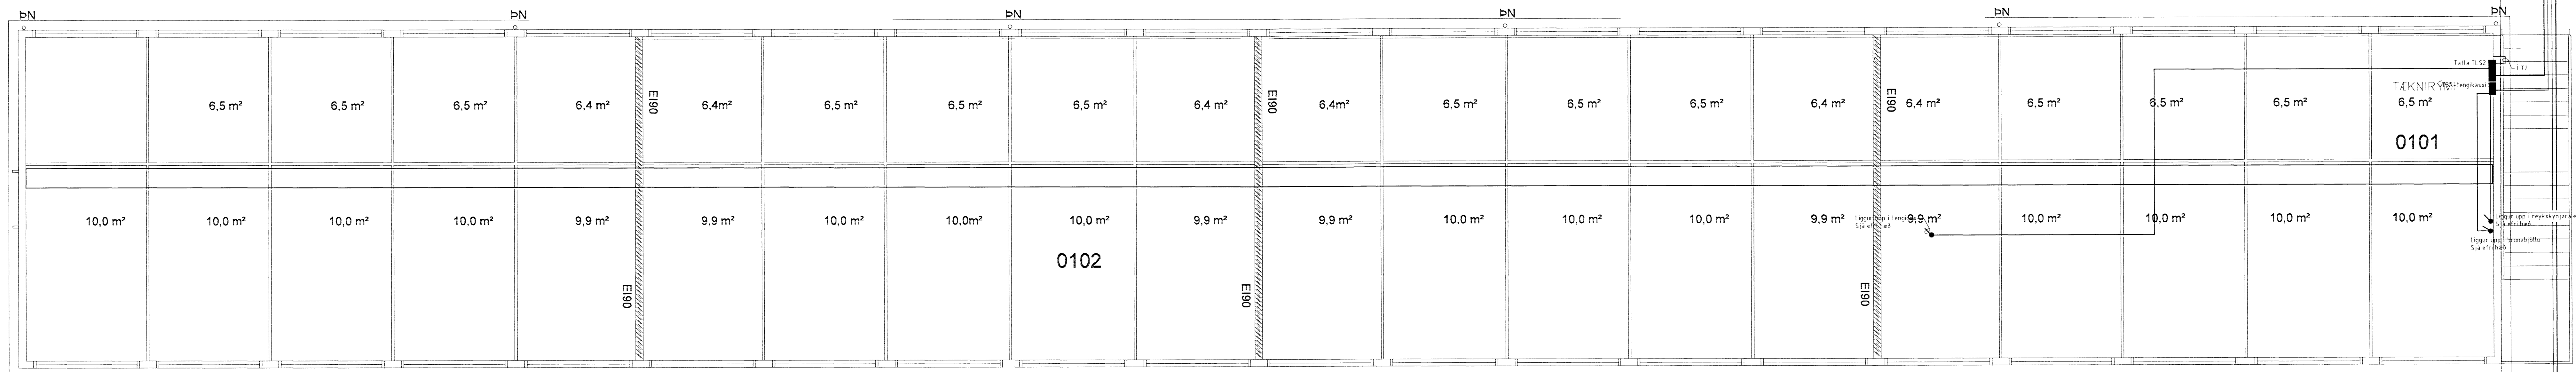

C

Byggingareitur fylgir ummáli húss.

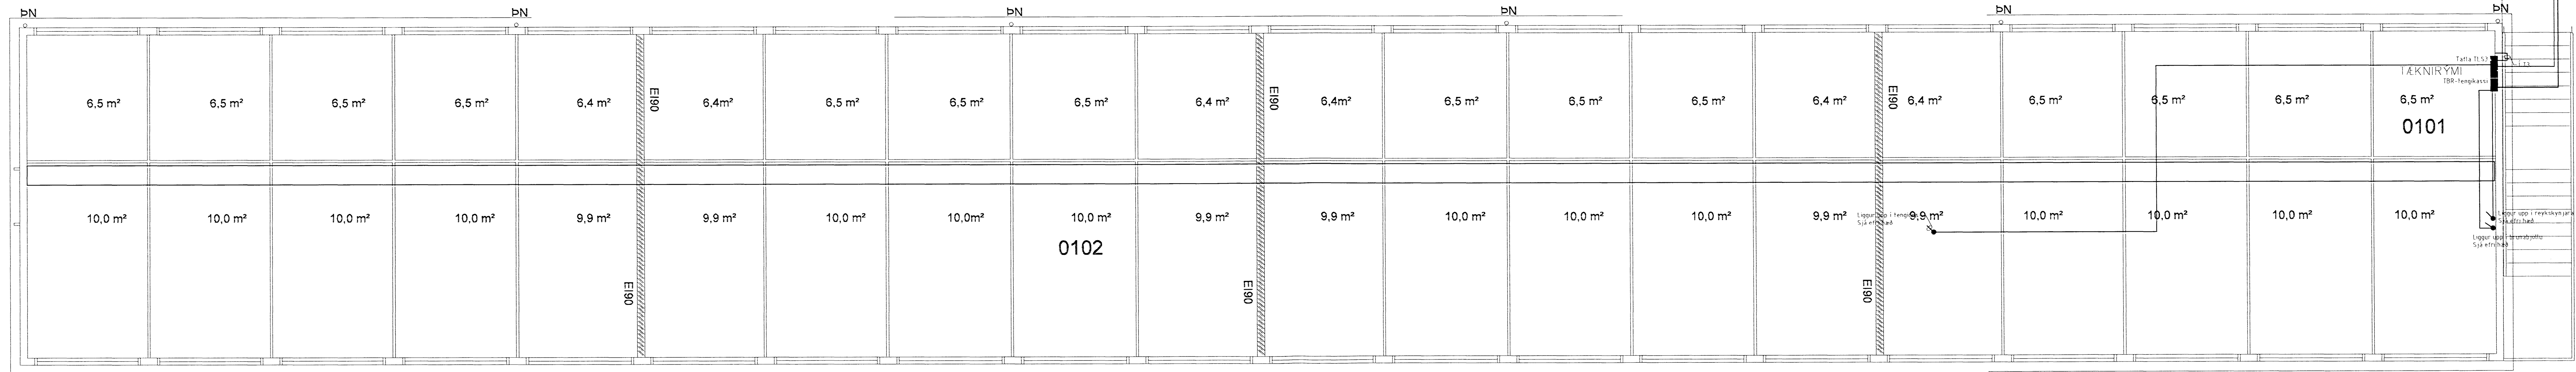

B

Byggingareitur fylgir ummáli húss.

A

Verkhelti		
Gjáhella 15 - Hafnarfjörð		
Verkhelti/Verkhúmer		
Smáspenna, bruna- og öryggiskerfi 1.hæð		
Blað.nr.	Dags.	Kvarði
3/5	19.mai'08	1:50
Yfirfarir		
Hönnuður		
SH/GMS		
Samræmingar hönnuður		
f.ótiss		
Breyting		

Útgefið 19.5.08


 Reykjavíkurvegi 60 220 Hafnarfjörð  
 kt. 700402-5090  
 Sími 565 1846, fax 565 0940 ogm 898 0970  
 http://www.munus.is, e-mail munus@munus.is  
 Hannadur Sigurjon Harðarson, kt. 0603612749

8

7

6

5

4

3

2

1