



VIEW ON GRID LINE D - PARTS
1:50

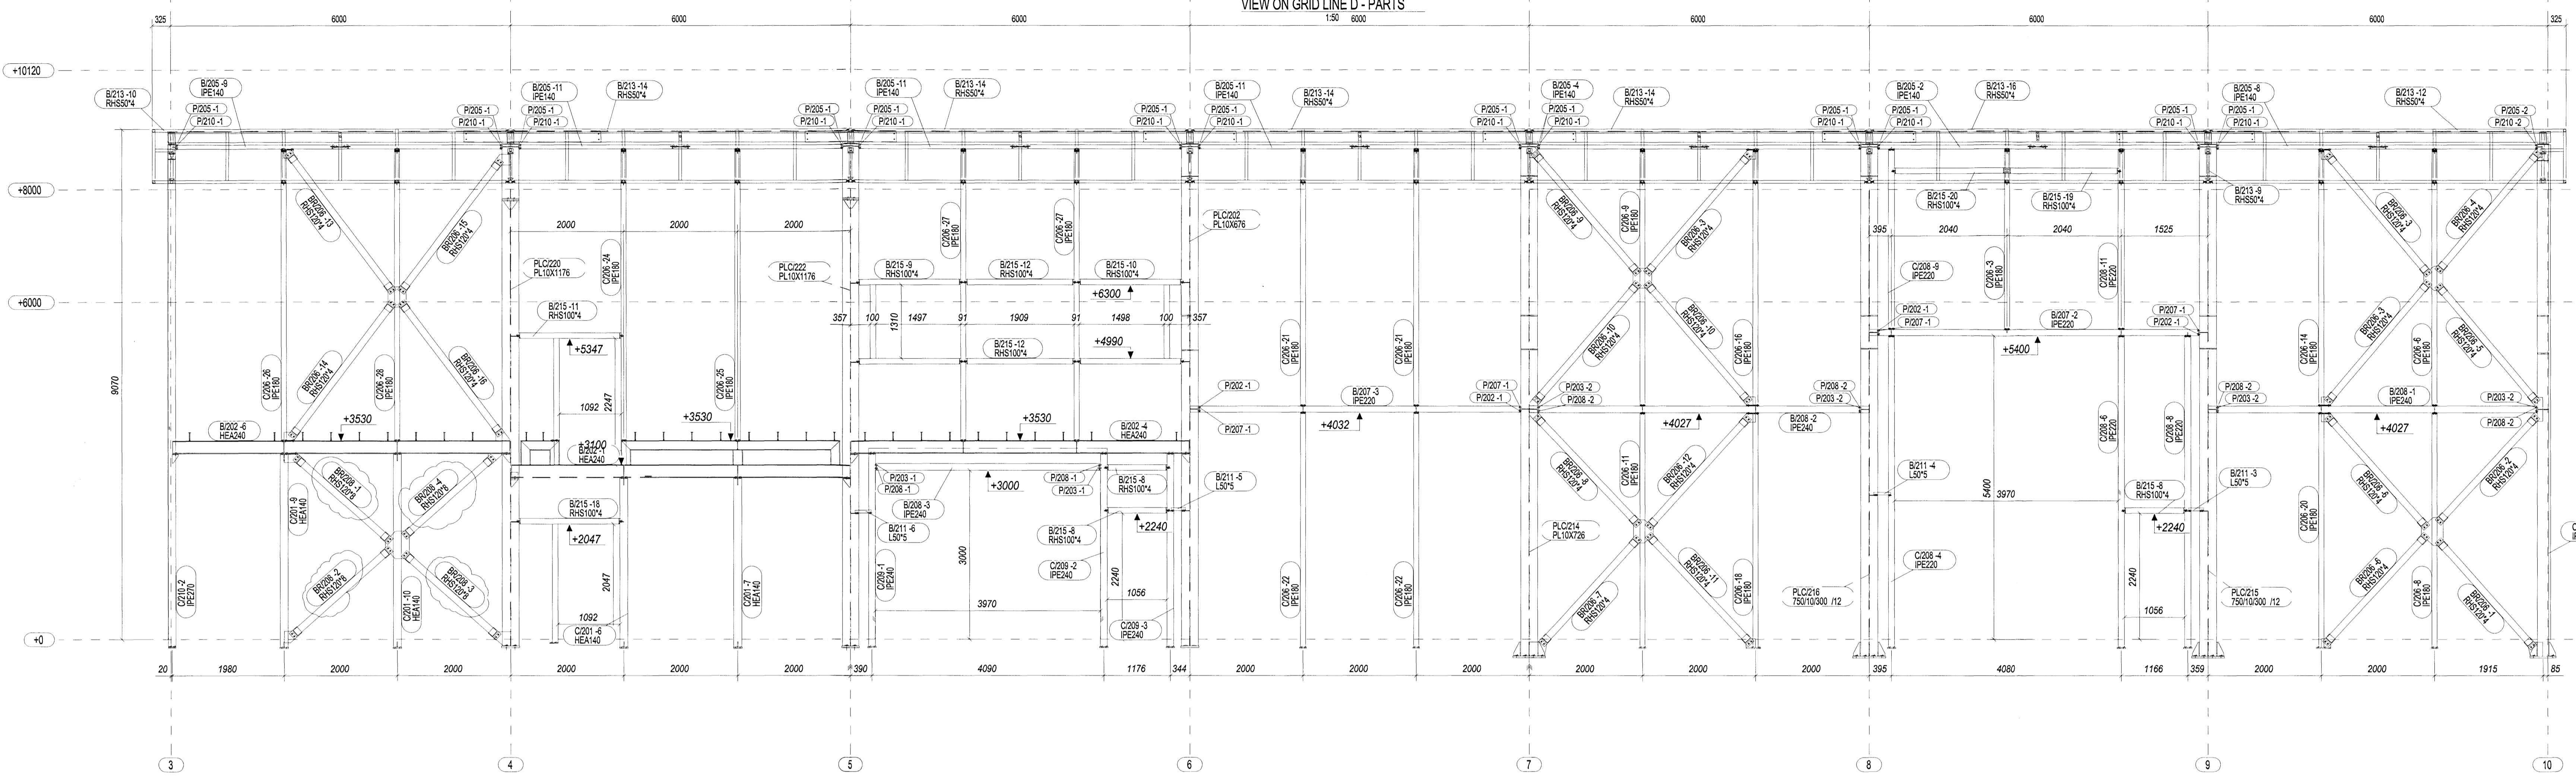

VIEW ON GRID LINE D - BOLTS
1:50

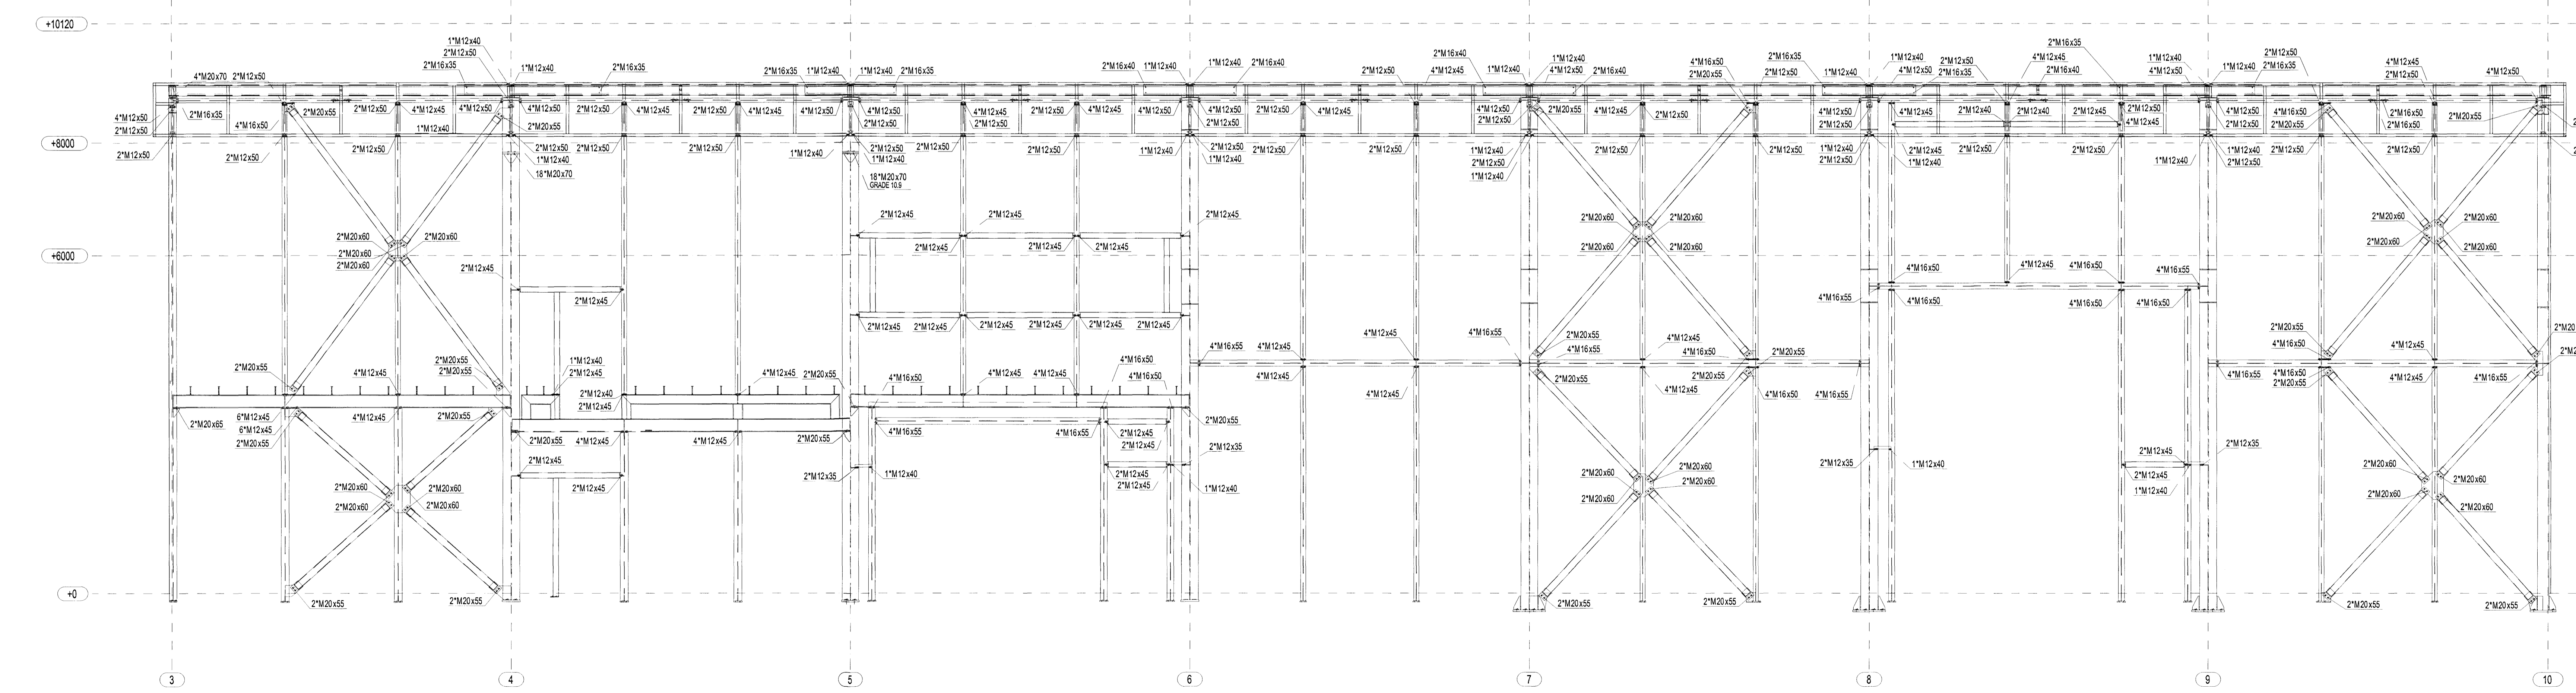

ALL BOLTS TO BE 8.8(8) GRADE, UNLESS NOTED OTHERWISE.

2008.05.06	ZMANY JAK ZAJNACZONO / REVISED AS NOTED	E.RYPHRSKI
2008.04.09	WYBANO DO ZATWIERDZENIA / ISSUED FOR APPROVAL	E.RYPHRSKI
2008.04.09	OPIS DZIAŁA / DESCRIPTION	NAZWSKO NAME
Etap / Documentation Stage: KONSTRUKCYJA / CONSTRUCTION		Data / Date: 2008/04/09
Opis: Nazwa i Adres: RSTNET - BUCYNEK WARSZTATOWY Object, Name and Address: RSTNET - WORKSHOP BUILDING Athens 6, Hafnarvegur, Island		Nazwa rysunku / Drawing name: WIDOK W OSI D VIEW ON GRID LINE D
Zaprojektował / Designed by: PIOTR WALOSKI WKP0040.P00005	Opisany przez / Described by: PIOTR WALOSKI WKP0040.P00005	Nr projektu / Project No.: 02.1000

Handwritten signature and date: 02.10.08