



Bygginguvarnir Hamarhagar  
 08 FEB 2008  
 VPS

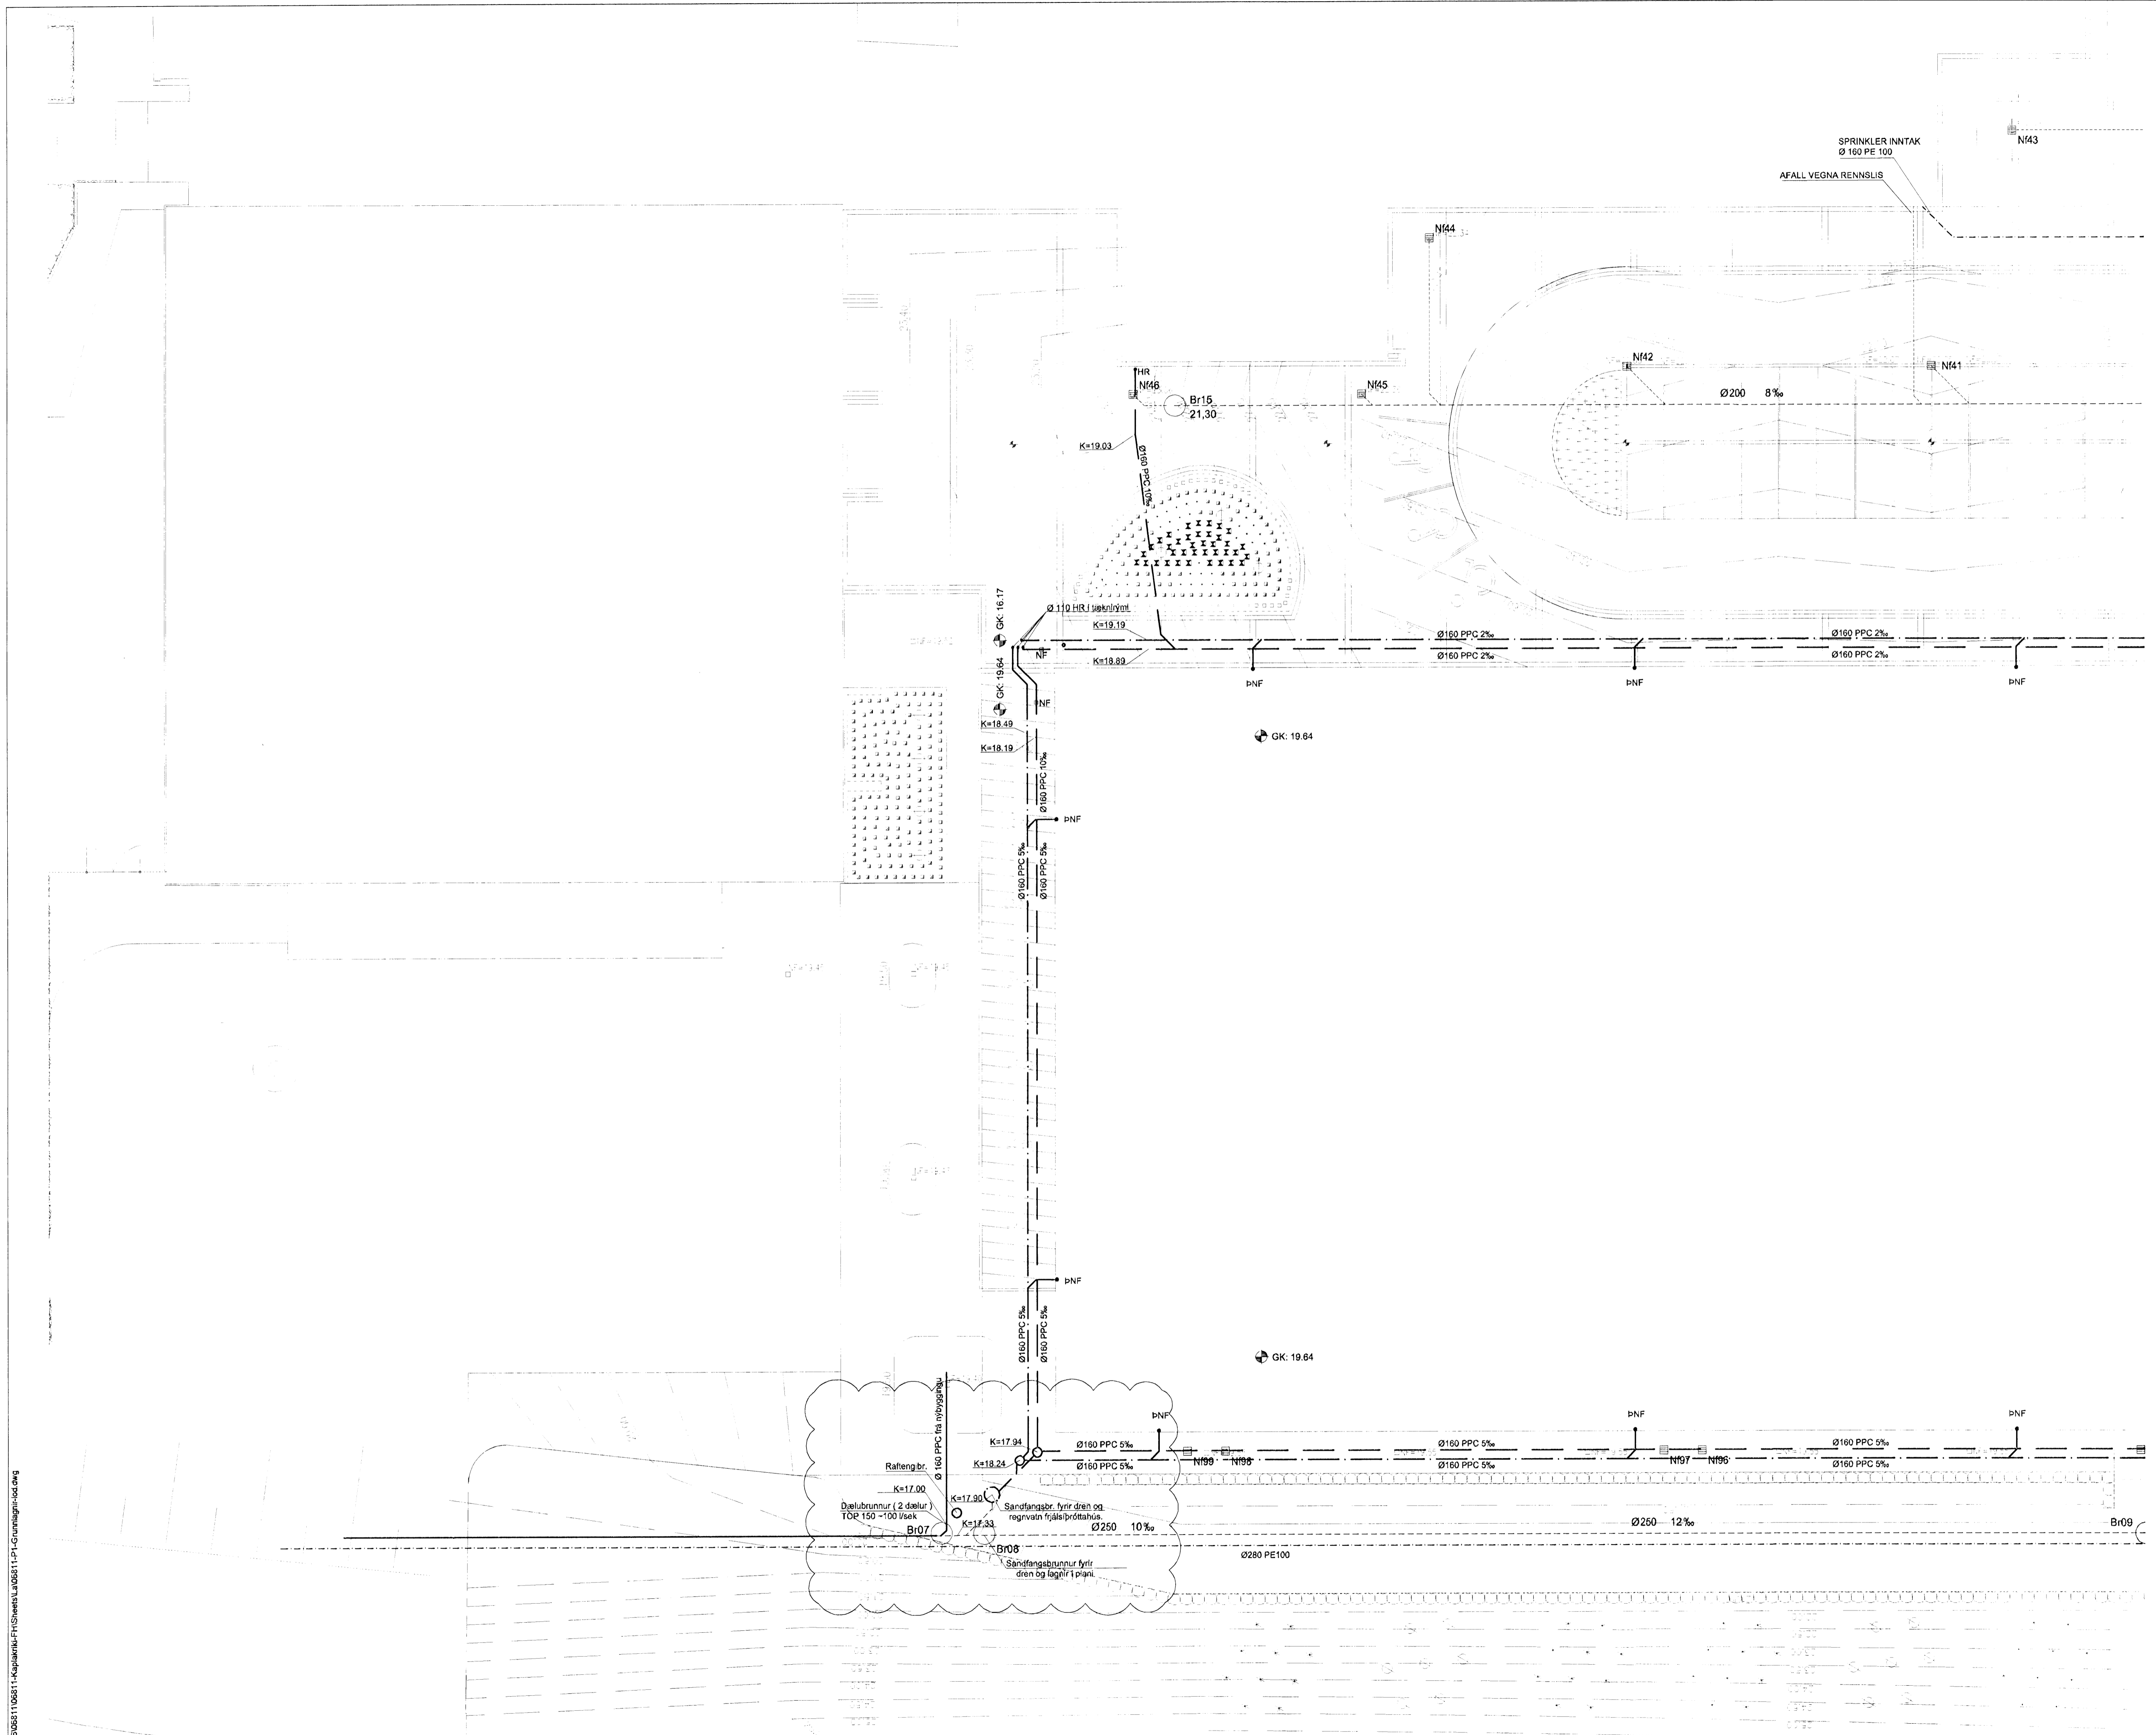

SPRINKLER INNTAK  
 Ø160 PE 100  
 AFALL VEGNA RENNSLIS

DATE: 30.06.08  
*[Handwritten signature]*

KAPLAKRIKI

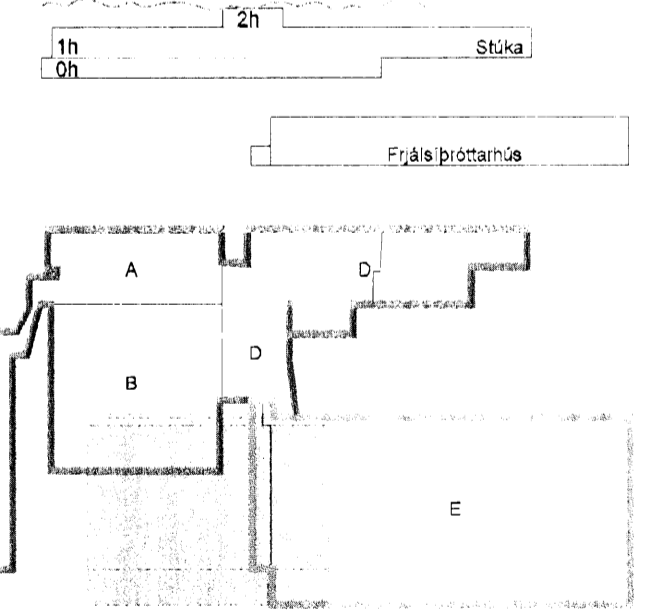

E	29.01.08	Breyting á kótum	KMJSÁS
D	22.01.07	Bætt við dreni	KMJSÁS
C	14.12.07	Tírfærslur á lögnum	KMJSÁS
B	07.12.07	Innsettur sandfangsbunnur	KMJSÁS
A	23.11.07	Verkefningar	KMJSÁS
Útg.	Dags.	Skýring	Hannað/Yrfríð



VERKFRÆDISTOFA

BÆJARHRAUN 20 • 220 HAFNARFJÖRÐUR • KENNIT. 110196-2899  
 vsb@vsb.is • Sími 585 6600 • Fax 585 3410 • www.vsb.is

Artun sérhönnuðar  
 Sveinn Áki Sverrisson Kt. 230855 6609

Verkefni  
**KAPLAKRIKI**  
**HAFNARFIRÐI**

Verkhliði  
 Lagnir  
 Grunnlagir í lóð  
 Grunnmynd

Hannað	Teiknað	Yrfríð	Kvarði	Síða
KMJ	KMJ	SÁS	1:200	/ A1
Dags.	Verkefni	Teikning	Útgáfa	
19.02.07	06811	P1-6	E	

V:\2008\0831106811-Kaplakriki\FH\Sheets\A06811-P1-Grunnlagir.dwg