




11 SNID 1:10

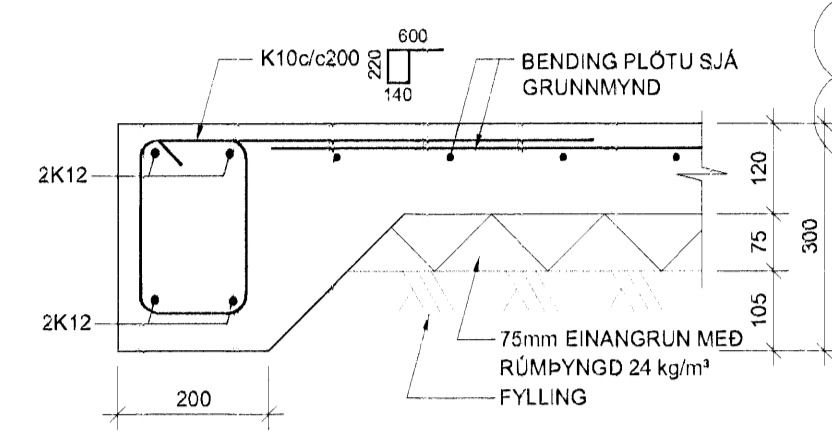


12 SNID 1:10

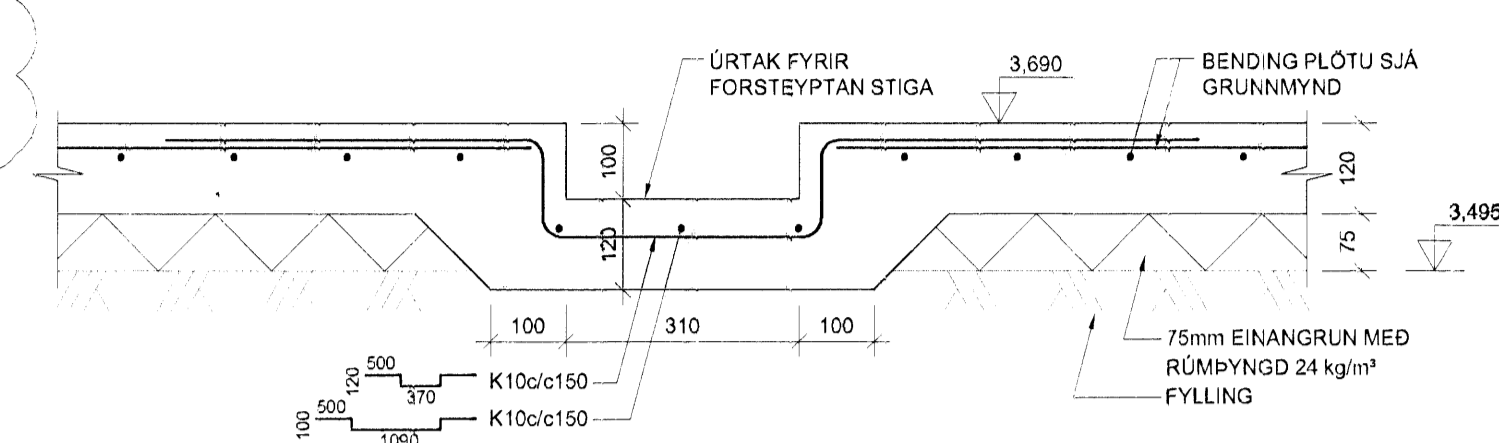

13 SNID 1:10

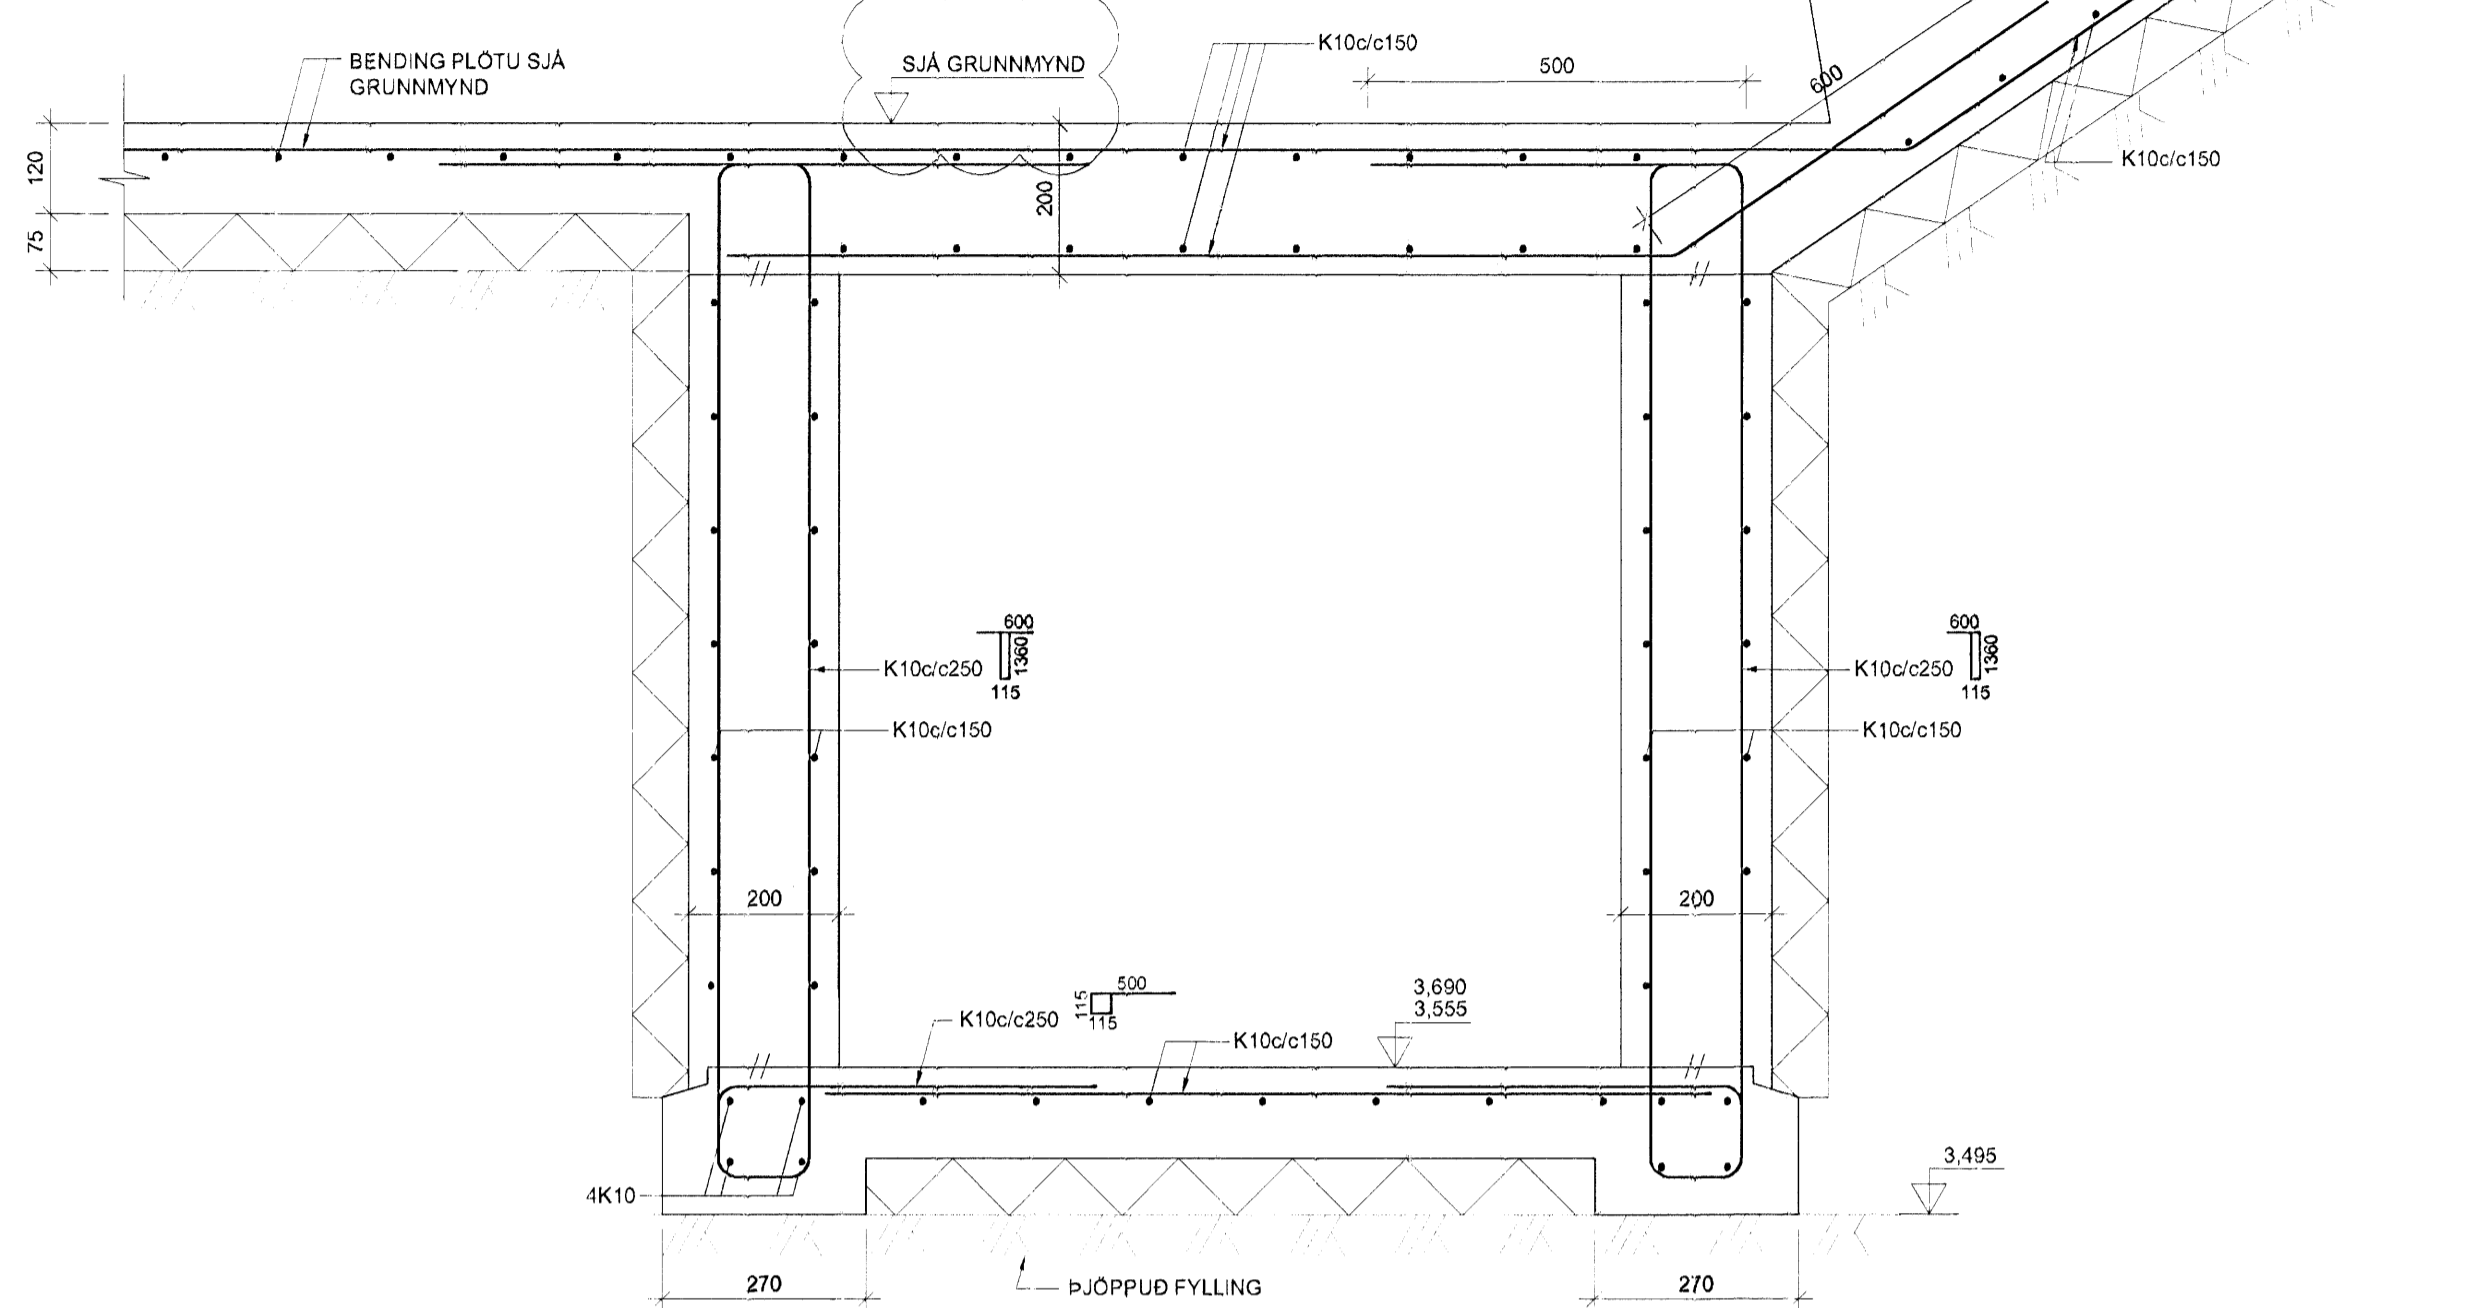

14 SNID 1:10

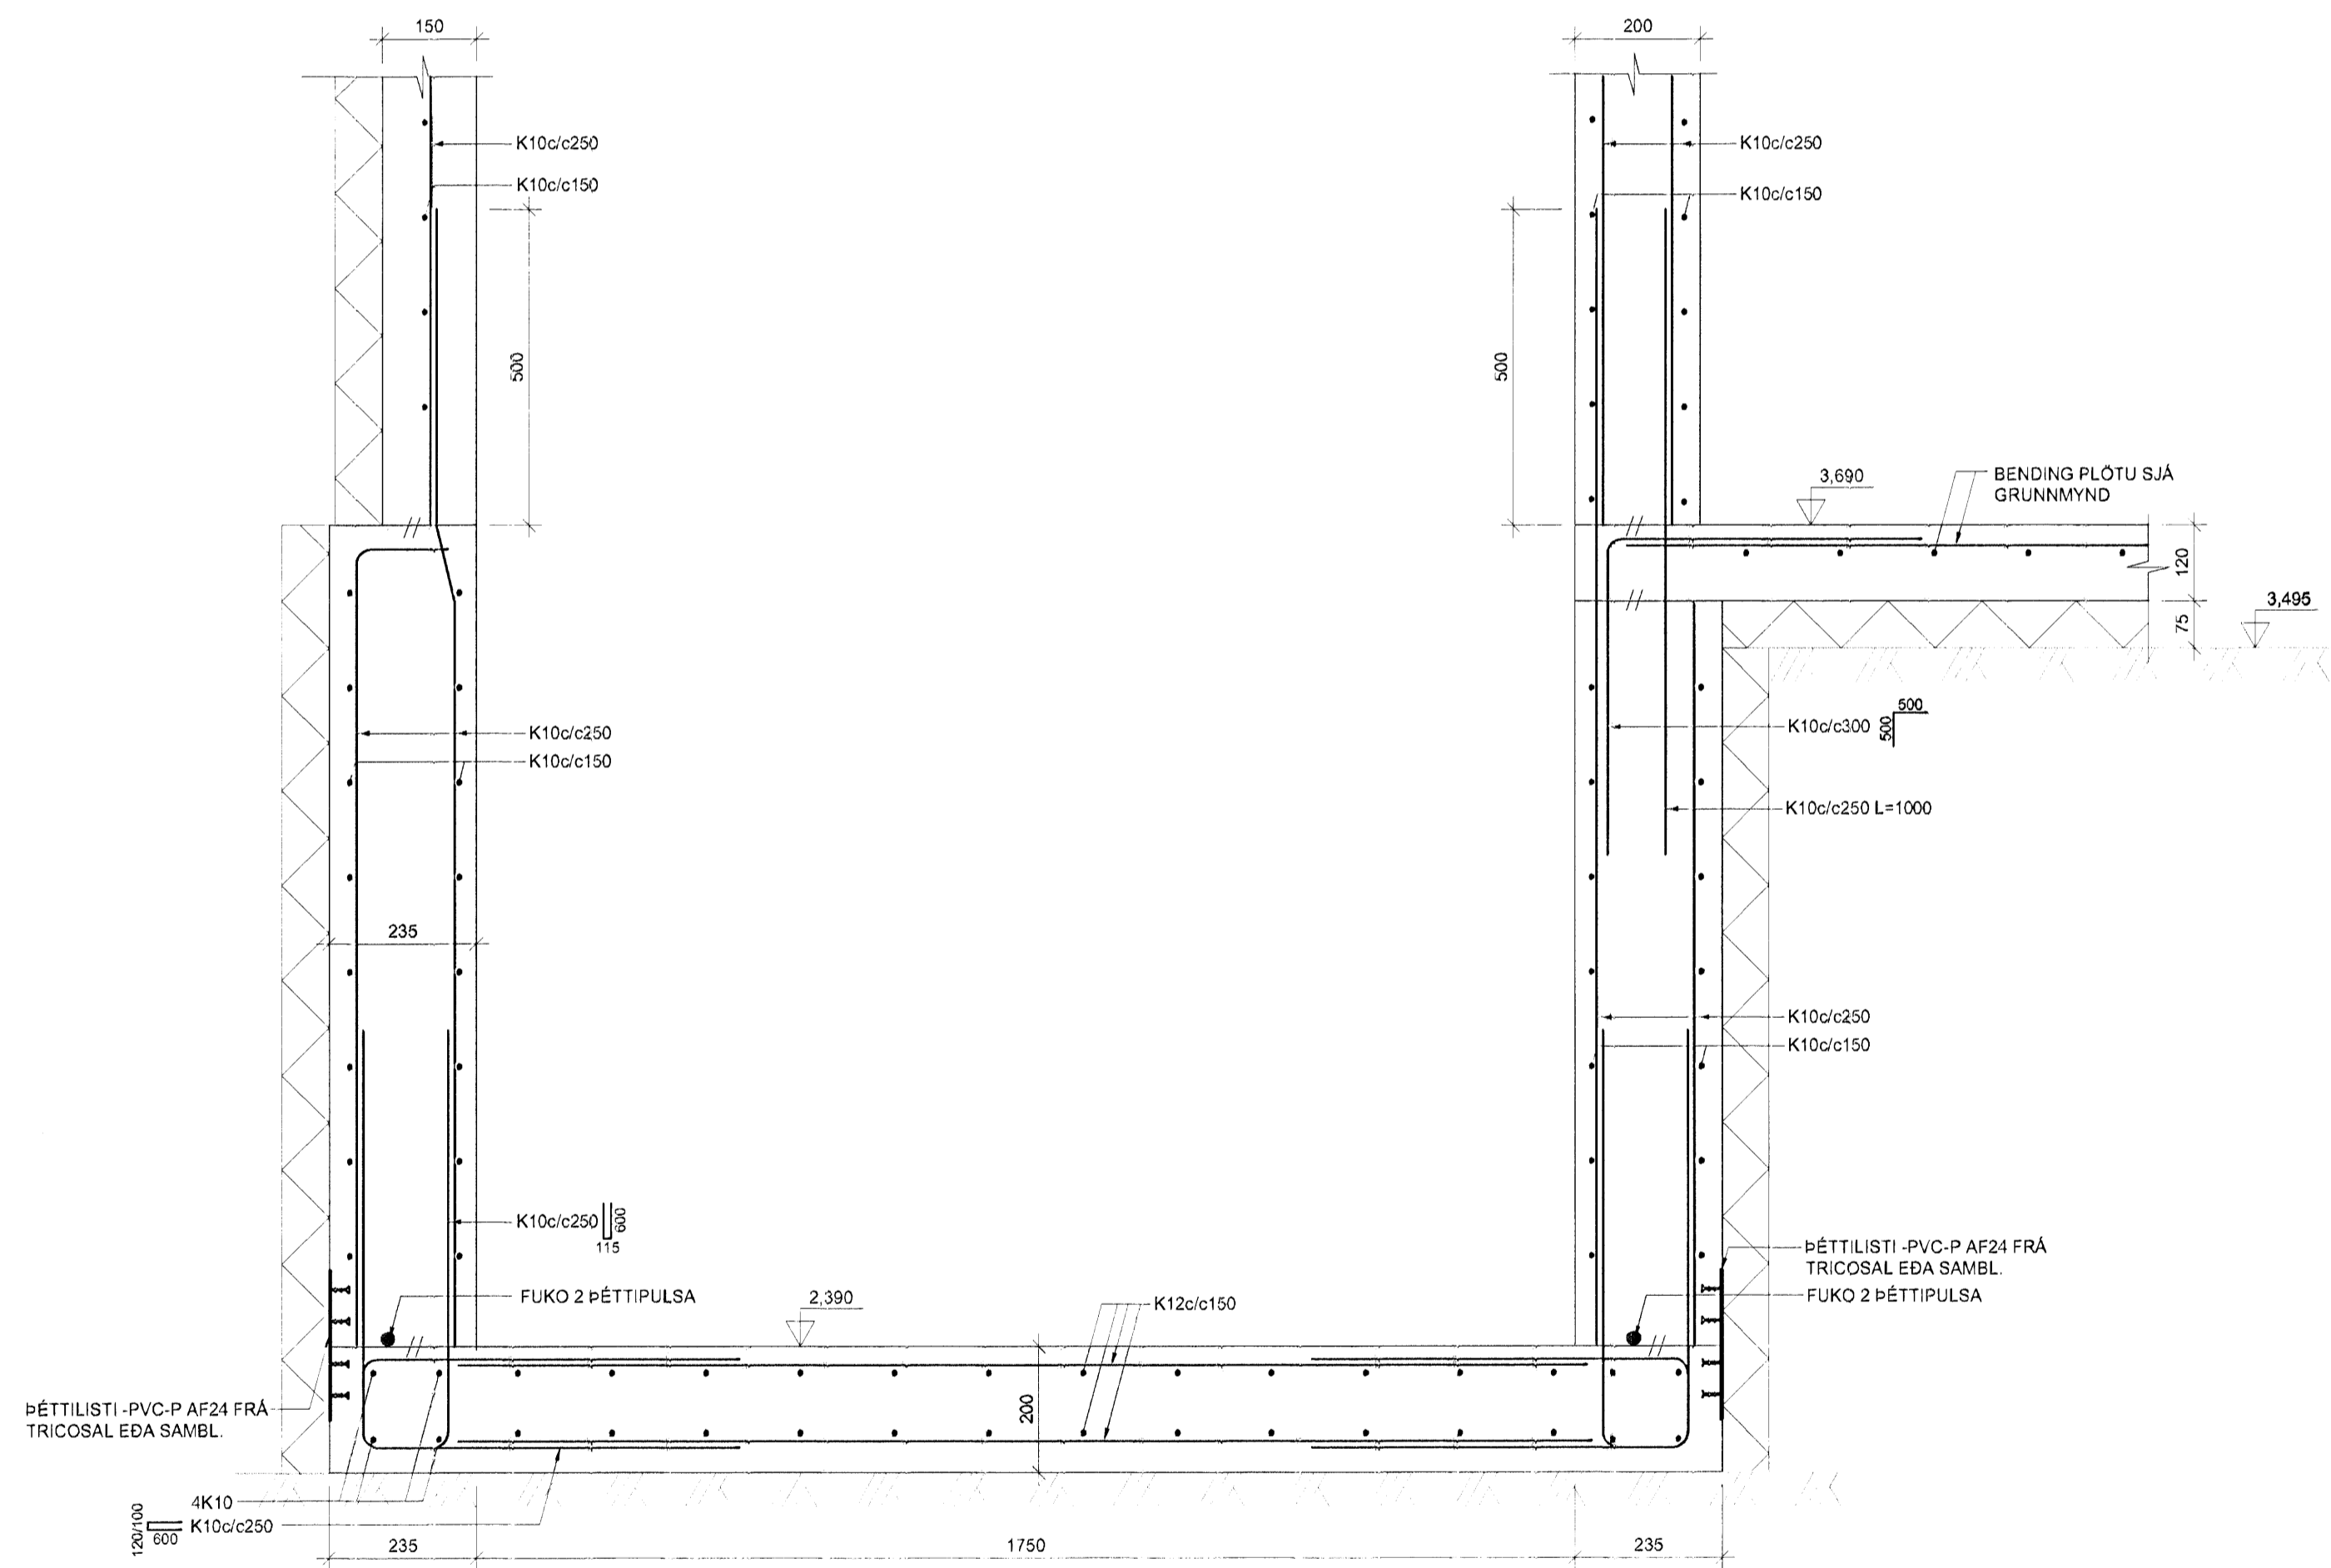


Bygginguáttal
Algreitt ísam
08 FEB 2008
VKS

ARITUN SAMRÆMINGARÁHJÚÐAR
Palmistev

TILVÍSANIR:
ALMENNAR SKÝRINGAR SJÁ BL. NR. B(7-9)_001

A	11.01.2008	KÓSTAR	ÞO	ÞO
BR.	DAGS	BREYTING	REKNI	TEKNI
NORDURBAKKI 7-9				
BURÐARVIRKI				
UNDIRSTÖÐUR				
SNID OG SÉRMYNDIR				
MKV:	1:10			
DAGS:	05.12.2007			
HANNAÐ/TEKNI:	HEGG			
VERKNR.:	05112			

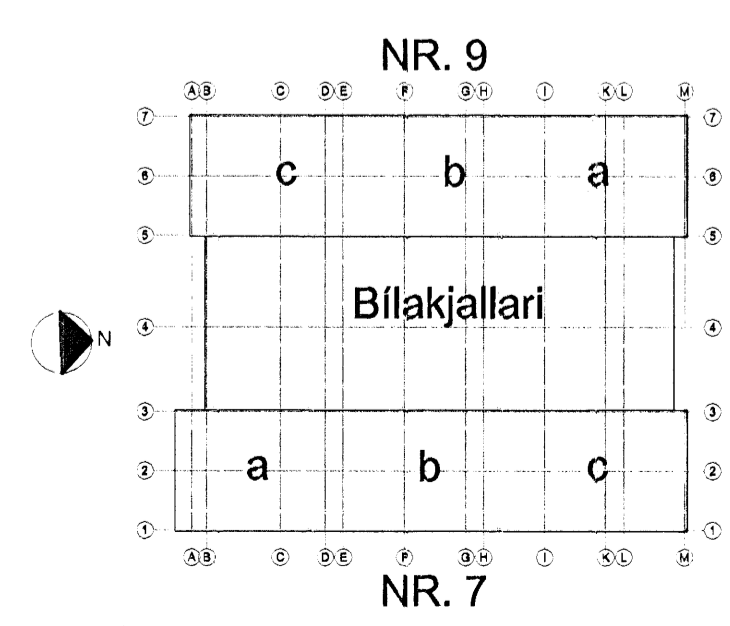

YFIRFARID: *hó*

SAMMYKKT: *Palmev*

KENNITALA: 13067-4439

TEKNI NR: B(7-9)_011

SR: A

EVKT

Conís
VERKFRÁDRAGSJÓF

Kennitala: 600106-1400
Höfundur: 11.2011 Kóstar
Sími: 871.2000
Vefb. www.conis.is