


13 FEB 2008
 VSB

BATERI
 VSK
 SÁM
 SKYRNING

KAPLAKRIKI

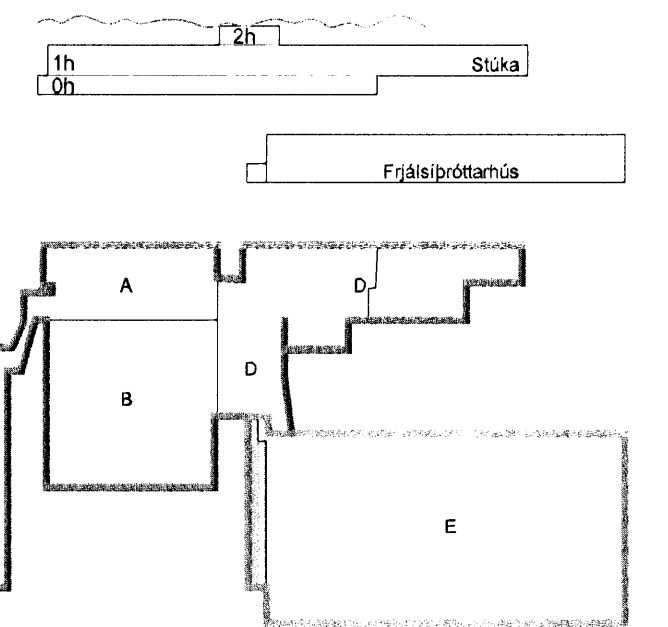

C	14.12.07	Tilfarstur á lögnum	KMJ/SAS
B	23.11.07	Breyting á lögnum og kótum	KMJ/SAS
A	12.11.07	Breyting á dreni og dælugryfju	KMJ/SAS
Dg.	Daga	Skýning	Hanna Órlyfsdóttir



VERKFRÆÐISTOFA

BÆJARHRAUN 20 · 220 HAFNARFJÖRDUR · KENNIT. 710796-2899
 vsb@vsb.is · Sími 585 8600 · Fax 585 8610 · www.vsb.is

Áritun sérhönnuðar Sveinn Aki Sverrisson Kt: 23065556009

Verkefni
KAPLAKRIKI
HAFNARFIRDI

Verkið
 Lagning
 Grunnlagning
 Grunnmynd

Hanna Órlyfsdóttir	KMJ	Teiknað	KMJ	Yfirfarið	SAS	Kvarði	1:100	/ A1	Síða	-
Daga	19.02.07	Verkefni	06811	Teikning	P1-3	Útgáfa				C

V:\2006\06811\06811-Kaplaun-FASheet\LA06811-F1-Grunnlagning.dwg