


Þessi skýring er gildig til 1.3. FEB 2008
 VSB

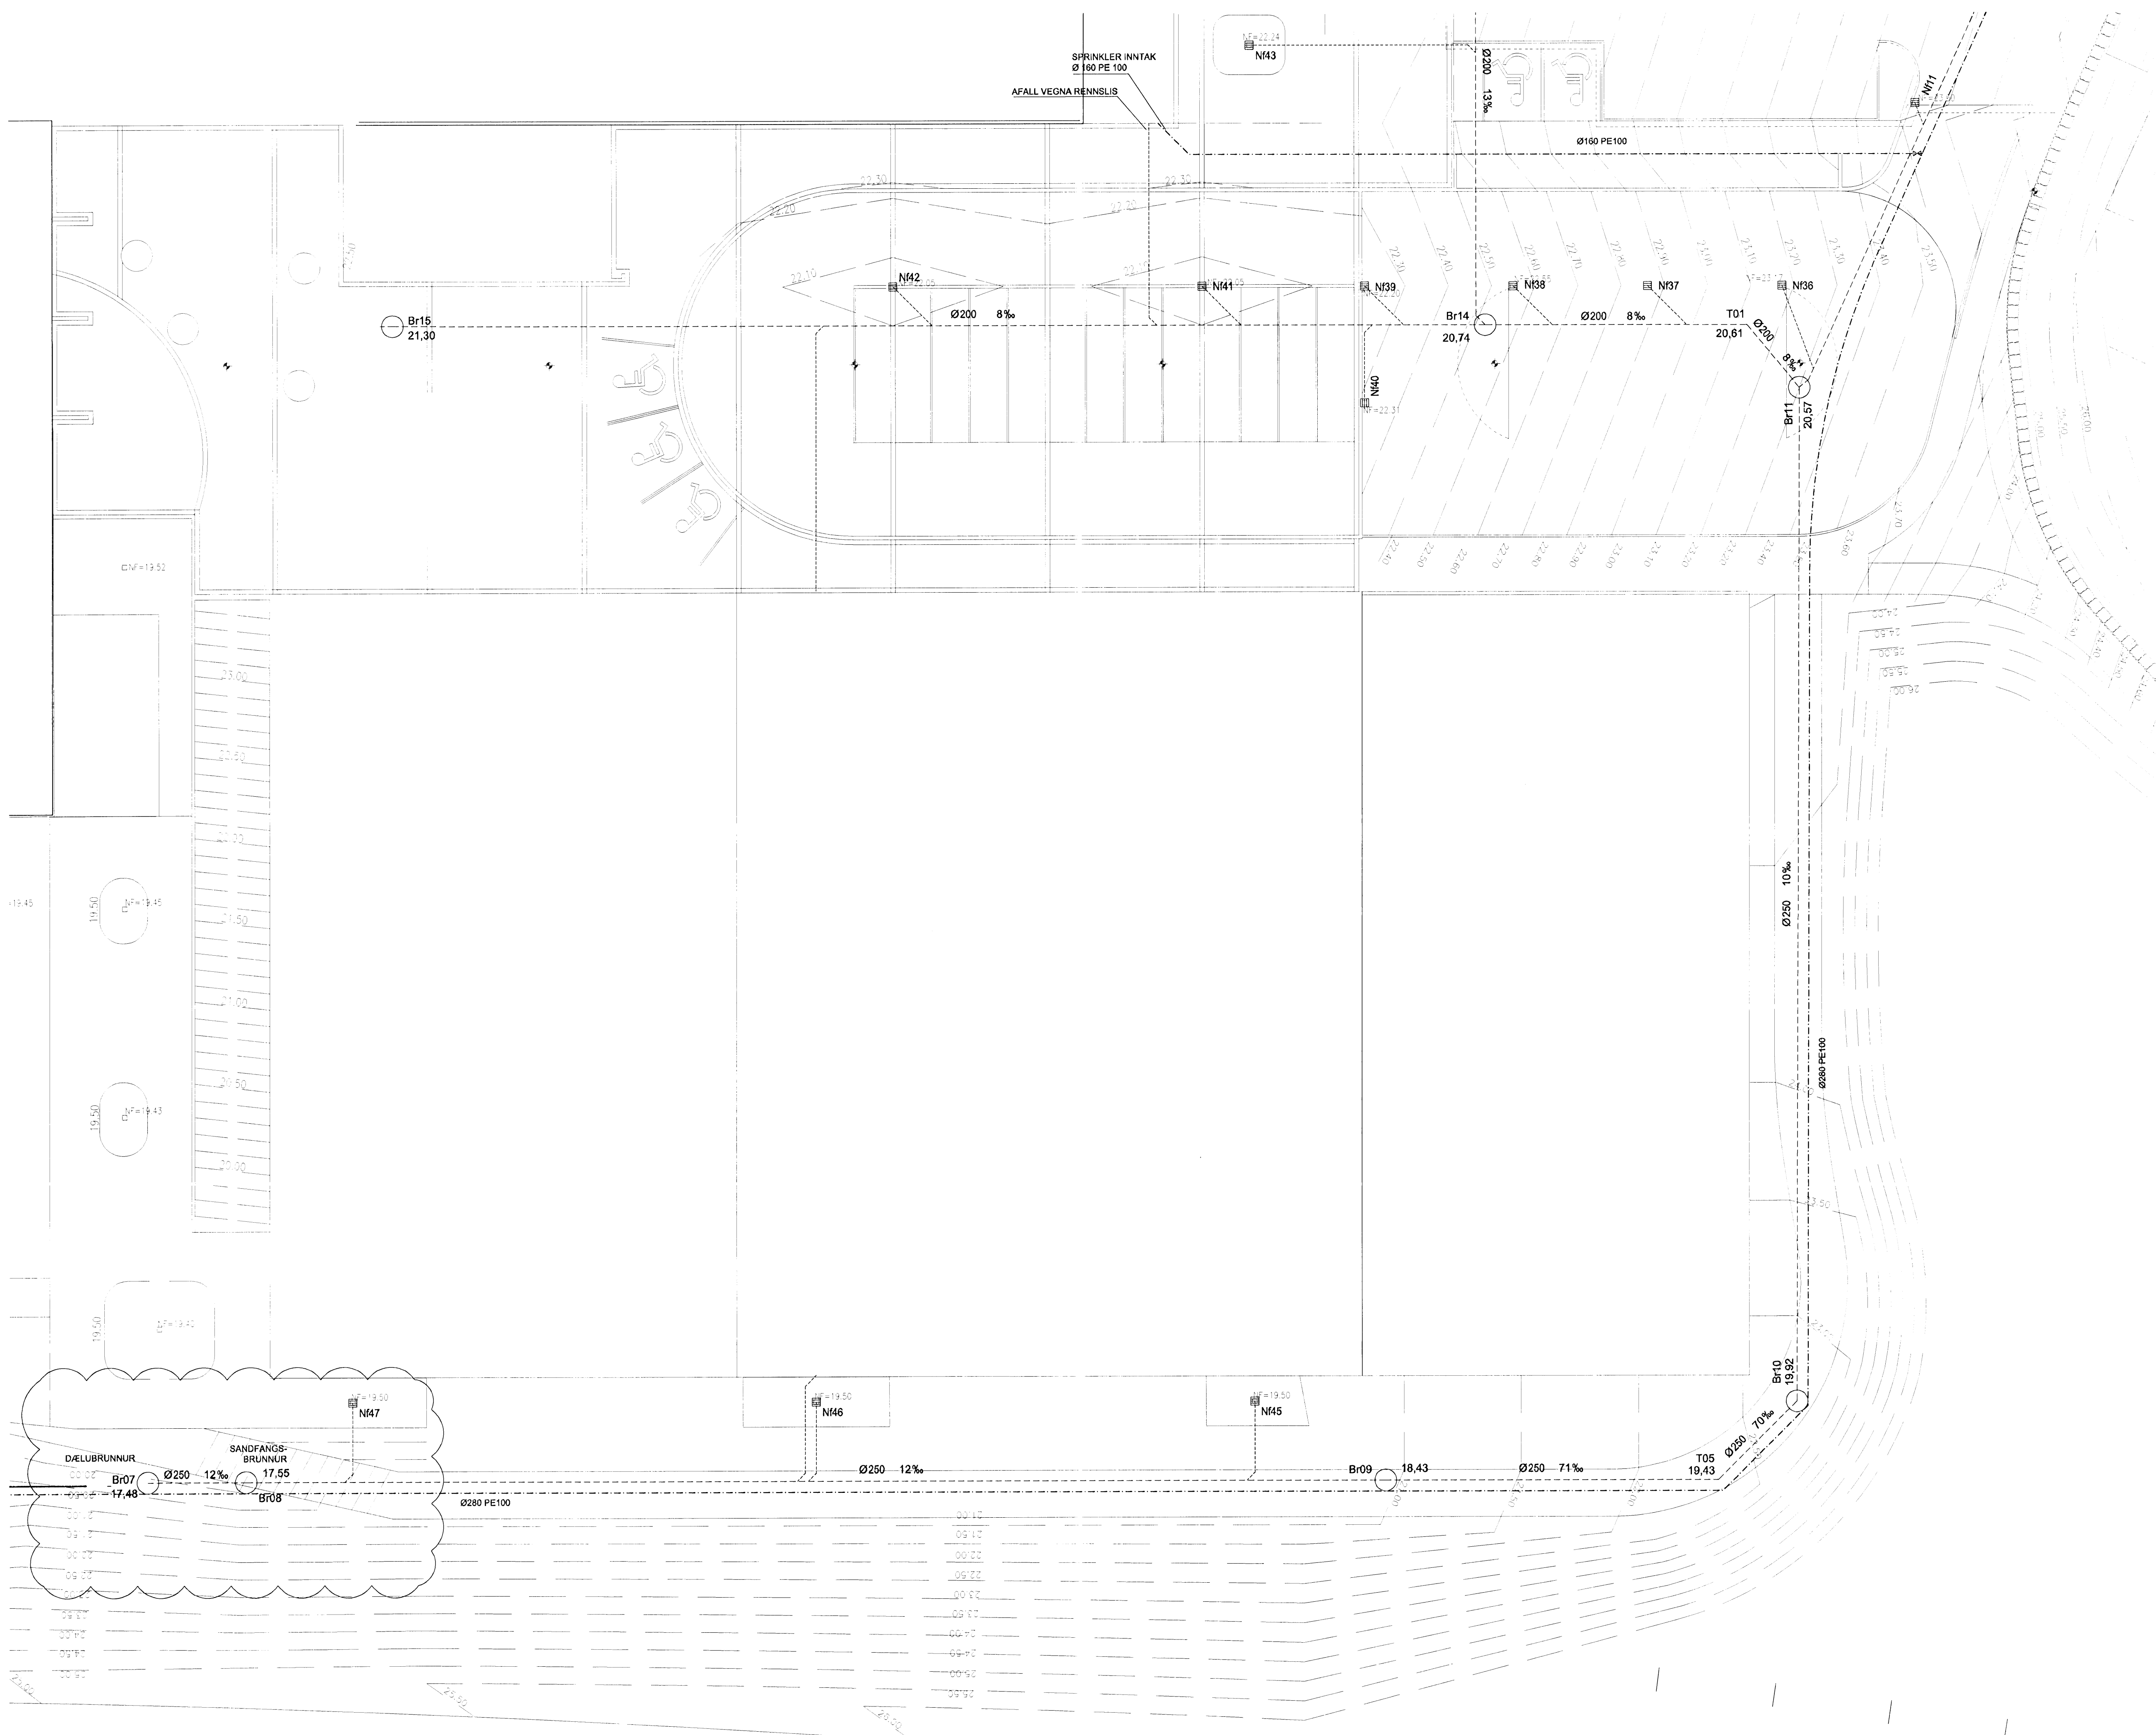


HNITASKRÁ:

Nr	Austur	Norður	Hæð
Nf11	356786,818	400295,317	
Nf36	356784,028	400281,132	
Nf37	356776,250	400277,498	
Nf38	356768,472	400273,843	
Nf39	356759,870	400269,813	
Nf40	356763,052	400283,021	
Nf41	356750,443	400265,396	
Nf42	356732,514	400256,994	
Nf45	356783,722	400202,340	
Nf46	356758,250	400190,407	
Nf47	356731,355	400177,807	
T01	356783,069	400277,917	20,61
T05	356812,734	400210,346	19,43
Br07	356718,642	400166,255	17,85
Br08	356727,314	400170,319	17,92
Br09	356793,457	400201,313	18,43
Br10	356815,150	400217,000	19,92
Br11	356787,817	400275,672	20,57
Br14	356767,918	400270,819	20,74
Br15	356704,529	400241,123	21,3

BATTERIÐ
 0604
 SÁMÁR
 J. V. R.

KAPLAKRIKI

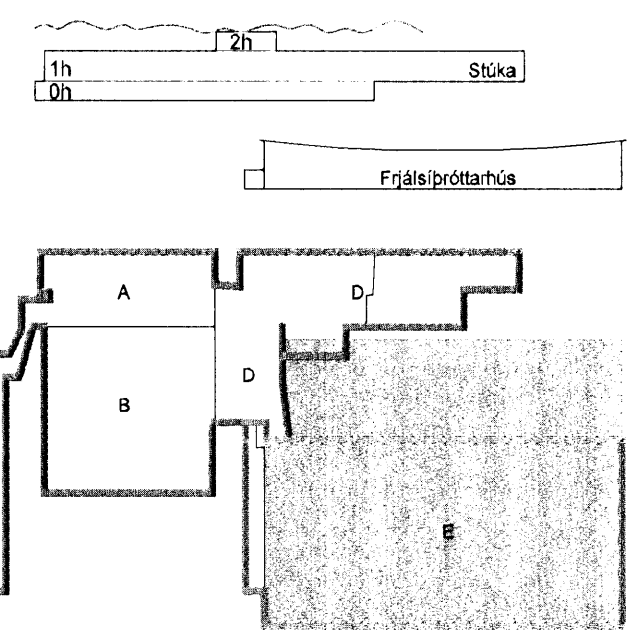

B	07.12.07	Innsettur sandfangsbrunnur	KMJ/SÁS
A	23.11.07	Verkefningar	KMJ/SÁS
Útg.	Dags.	Skýring	Hannað/Yfirfand

VSB

VERKFRÆDISTOFA

BÆJARHAUN 20 · 220 HAFNARFJÖRÐUR · KENNIT. 710796-2899
 vsb@vsb.is · Sími 585 8600 · Fax 585 8610 · www.vsb.is

Aritun sérhjúðar
 Sveinn Áki Sverrisson KT: 230855 5609

Verkefni
KAPLAKRIKI
HAFNARFIRÐI

Hannað	Teiknað	Yfirfand	Kvarði	Síða
KMJ	KMJ	SÁS	1:200	/ A1
Dags.	Verkefni	Teikning	Útgáfa	
19.02.07	06811	P1-5	B	

V:\2006\06811\06811_Kaplakriki-FH\Sheets\L06811-F1_Grunnlagir.dwg