



Undirritun samræmingarhönnuðar:

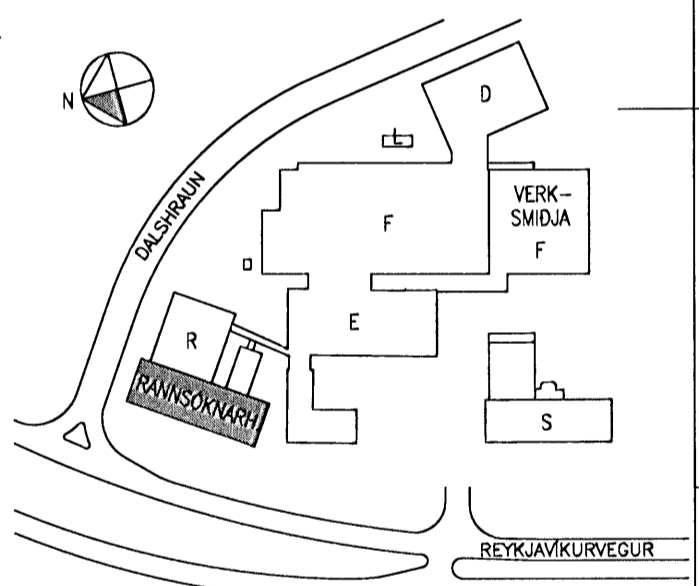

AFSTÖDUMYND

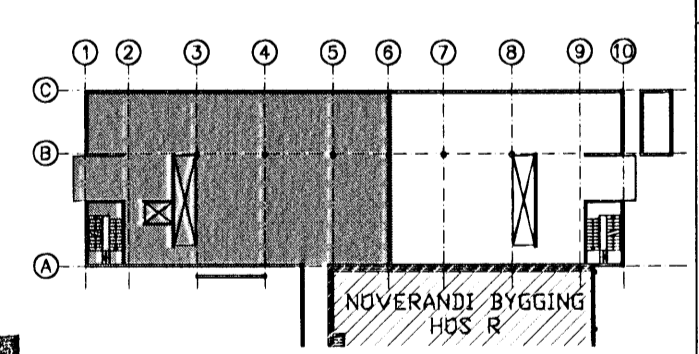

LYKILMYND


ÚTI
 ARKITEKTAR
 Jón Þór Þorvaldsson Aí, FSSA
 Kt. 02/256 7579

MESTA FJARLEGGD MILLI PÍPUFESTINGA (STÁLPIPUR)

PIPUSTÆÐ	LÆRSTAR PÍPUR	LÖÐRÉTAR PÍPUR
DN 10-DN 15	1,5 METRAR	1,8 METRAR
DN 20-DN 32	2,5 METRAR	3,0 METRAR
DN 40-DN 50	3,0 METRAR	3,5 METRAR
DN 65-DN 80	3,5 METRAR	4,0 METRAR

RAUNTEIKNING

18.09.2007 Dags. **FSK** Samp.

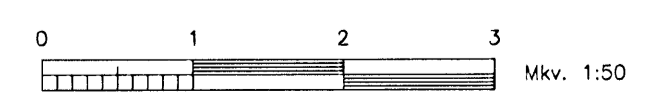

A	Pípustærðir og brunaslöngum og ó keltkerfi	21.11.2005
Nr.	Lýsing & breytingu	Daga
actavis		
R-Rannsóknarhús - Nýbygging		
Pípukerfi		
Ráðmynd - 3.Hæð - Hluti I		
Tekning nr. IS1R-M40/41/50-03-217A		
Daga: 28.09.2005	Mkv: 1:50	A1
Skjalnúmer: 375-Pípukerfi.dwg		375
LAGNATÆKNI		Höfundur: FSK/HBG
Hönnun- og iðbjólfarstofa /FRV Hönnun 12, 200 Kópavogur, Ísland Sími +354-564 5252 fax +354-564 5251 it@lagnatak.is http://www.lagnatak.is		Teknað: HBG
Samb.: <i>Fritof S. Þorsteinsson</i>		Yfirforð: x/x
Kennitala: 300346-3409		