



3 1 AUG 2011

Bygging
F.h. Sigurðs

Úr Gildi

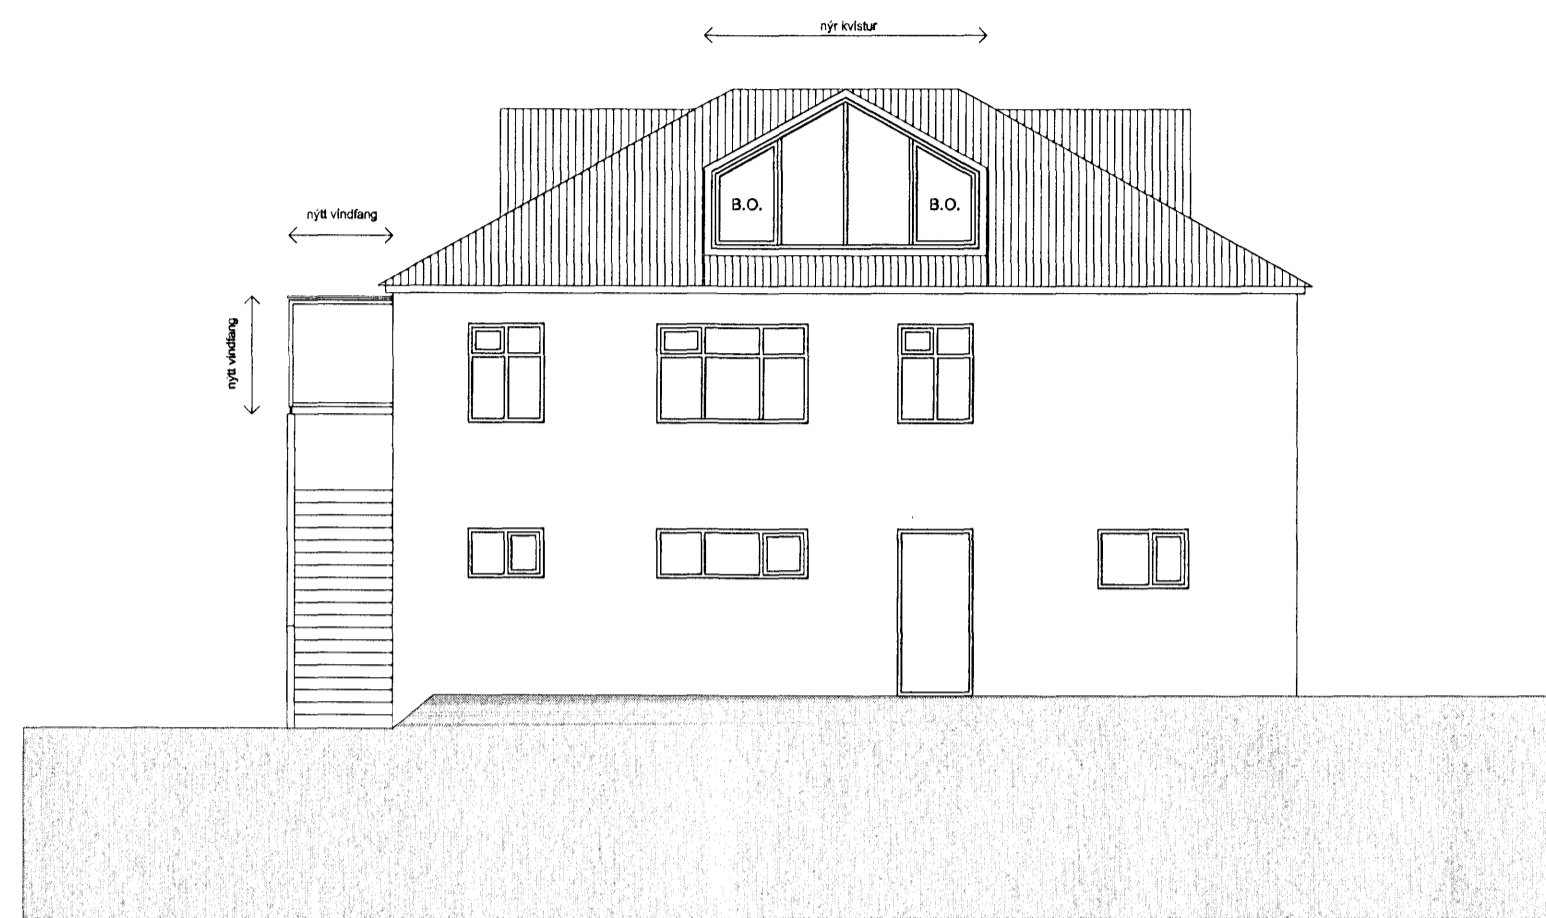


útlit austur

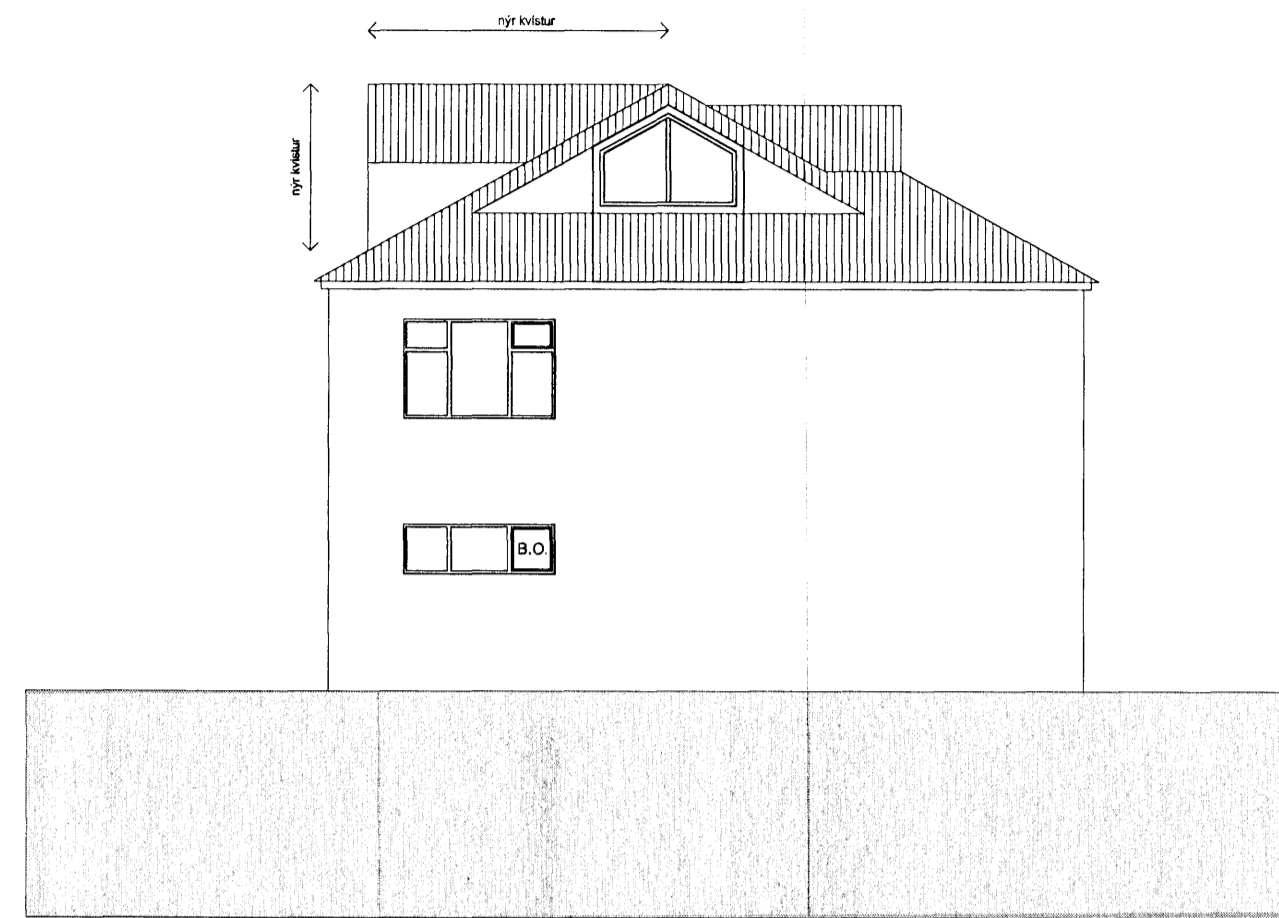

útlit norður



útlit vestur

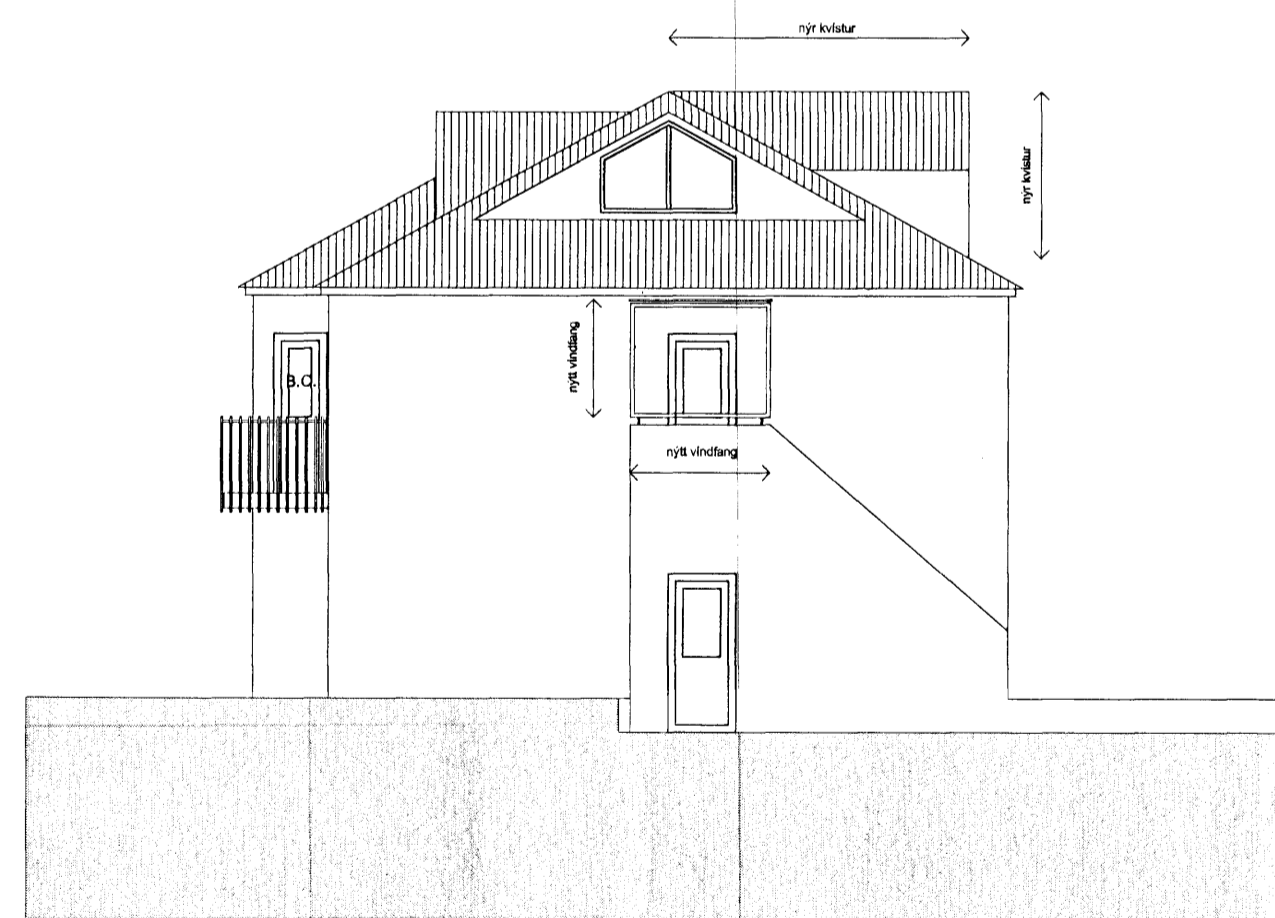

útlit suður

BREYTINGAR.

VERKHEITI

Hraunkambur 9

VERK
Útlit

MÁL
1:100
HANNAD
ÁJS
YFIRFARID:
ÁJS
VERKNÖMUR
09.11

DAGS.
03.05.2011
TEIKNAD
ÁJS
TEIKNINGANÖMUR
1.2

ÁRNI JÓN SIGFÚSSON ARKITEKT

FRIGGJARBRUNNI 35 - 113 REYKJAVÍK
SÍMI / NETFANG: 5650076 - sigfusson@simnet.is
Kt. 220169-2949

Arni Jón Sigfusson

SAMP.