


Undirritun samráðingarrönnuðar:

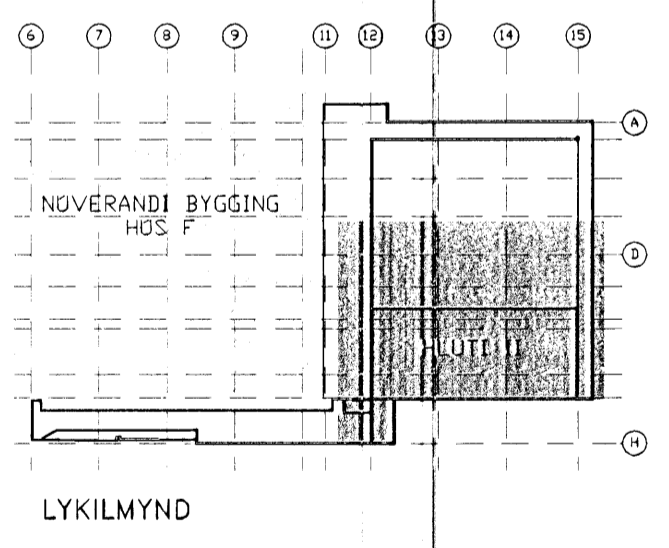

B	Raunteikning	22.09.2005
A	Utgáfa til bygginguvalfréttu. PW afþun breytt	11.04.2005
Nr.	Lýsing á breytingu	Daga
Reykjavíkurvegur 78, Hafnarfirði F-Verksmiðja - Stækun Pípukerfi Grunnmynd - 2.Hæð - Hluti II		
Teikning nr.: IS1F-M20/40/41/50/60/61-02-312-B		
Daga: 31.03.2005	Kvarði: 1:50	Verk nr.: 379
Skjalnúmer: 379-Pípukerfi-hellid.dwg		
Hönnunar- og ráðgjafarstofa /FRV Hönnunartíðni 200 Höfðavogur, Ísland Sími: 244-066 9292 Fax: 06-464 9291 H@lagnotak.is http://www.lagnotak.is		
Samþ.:		
Kennitala: 19847-2749		