




Undirritun samræmingarhönnuðar:

ELDRI BYGGING

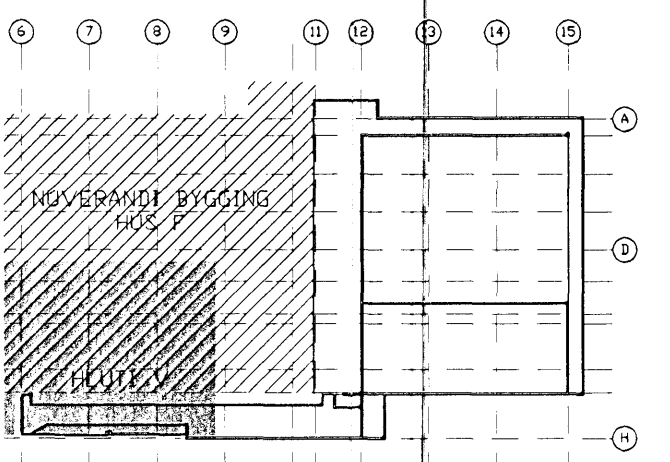

LYKILMYND

Handwritten: 100 01856-2549

| | | |
|-----|------------------------------|------------|
| B | Raunteikning | 22.09.2005 |
| A | Utgáfa til byggingarfulltrúa | 11.04.2005 |
| Nr. | Lýsing & breytingu | Dagur |

actavis
 Reykjavíkurvegur 78, Hafnorríði
 F-Verksmiðja - Stækun
 Pípukerfi
 Grunnmynd - 1.Hæð - Hluti V

Tekning nr. IS1F-M40/61-01-306-B
 Dags: 31.03.2005 Kvarði: 1:50 A1 Vork nr.: 379
 Skjalnúmer: 379-Pípulagnir--heild.dwg Hönnuð: SÞ/HBG

LAGNATÆKNI
 Hönnunar- og ráðgjafarstofa /FRV
 Hornborg 12, 200 Kópavogur, Ísland
 Sími+354-564 5252 Fax+354-564 5251
 Hótelgata 7 http://www.lagnatak.is

Samb. *Handwritten signature*
 Kennitala 106149-2749

29 SEP 2005
Handwritten initials