


SNID B-B

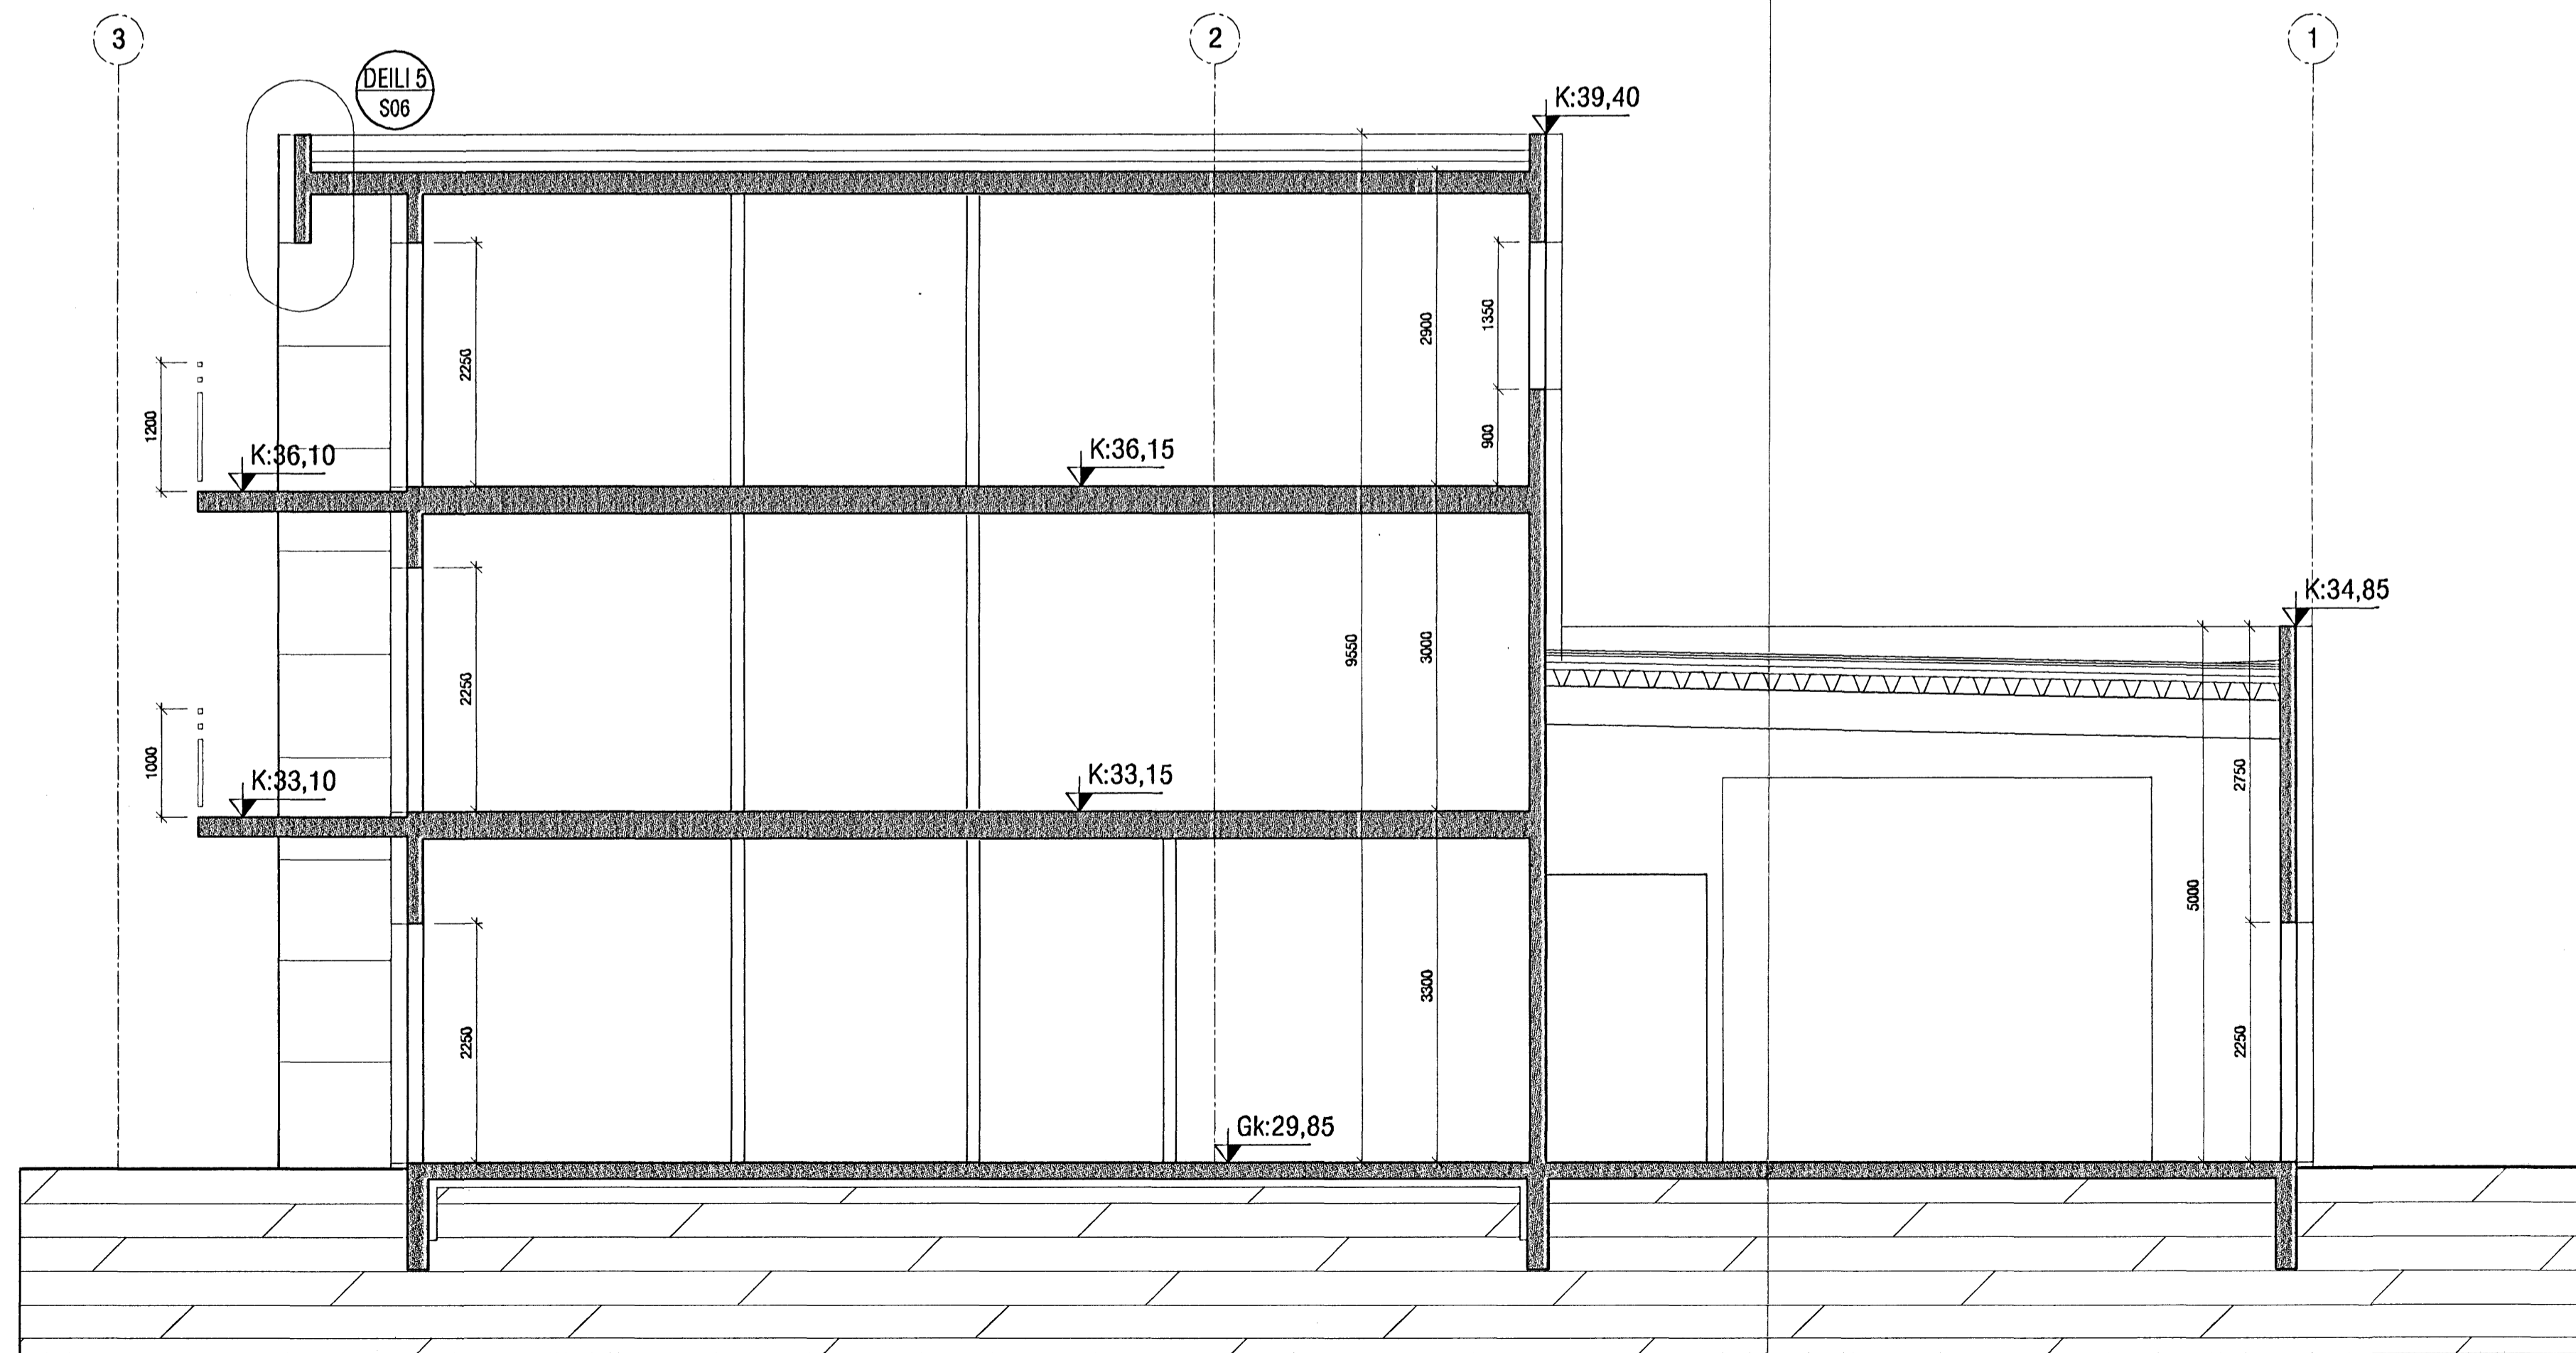

SNID C-C

Byggingaútfrúll Hafnarfjarðar
Afgreitt bann
23 AUG 2005

Breyting 16.08.05: Kótum breytt

VEKTOR - hönnun og ráðgjöf - Nýbýlavegi 8, 200 Kópavogi.		Ríkharður Oddsson byggingafræðingur nr. 270261-9199 sími: 554-8500 fax: 554-8888		DRANGAHRÁUN 14, HAFNARFIRÐI SNID B-B OG C-C	
S-04		Br.1	16.08.05		
Tekn. nr.	TÍMUN & LÖSINGU	Br.	Dags.		
Samþykkt					
Dagsetning	15.08.05	Verkt.	A-05-01-02	Málkeðli	1:50
		Tekn. nr.	S-04		