


C:
B:
A:
BREYTINGAR: 4.hað breytt
25.07.2005
DACS:

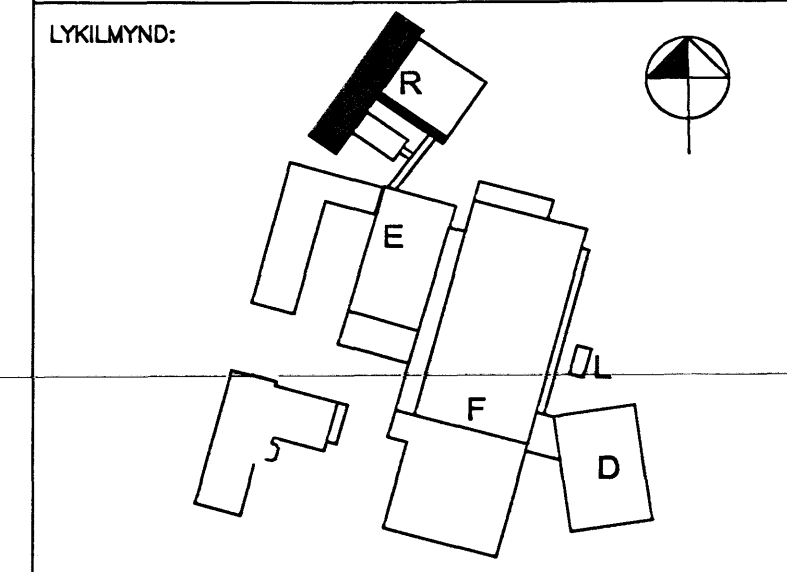

VERKKAUPLI:
actavis
REYKJAVÍKURVEÐUR 80,
R-RANNSÓKNARHÖRS
VERKTEIKNING: Byggingafræðingur
Alfharður Þorsteinsson
ÓTLIT-SÚDVESTÖR 23. AUG. 2005
VERK: DACS: 12.08.2005
KVARDI: 1:50 TEIKNAD: JPB
SKRÁ: .DWG

ÚTI INNI
ARKITEKTAR
RINGHOLTSTRÆTI 27 101 REYKJAVÍK
SÍMAN: 5527660 & 5527660 FAX: 5527661
NETFANG: u@u.is
VÉLFANG: http://www.u.is
BALDUR Ó. SVAVARSSON ARKITEKTAR FAI
JÓN ÞÓR ÞORVALDSSON ARKITEKTAR FAI
TEIKNINGANIR: **A-R-209** BREYTING: **A**