
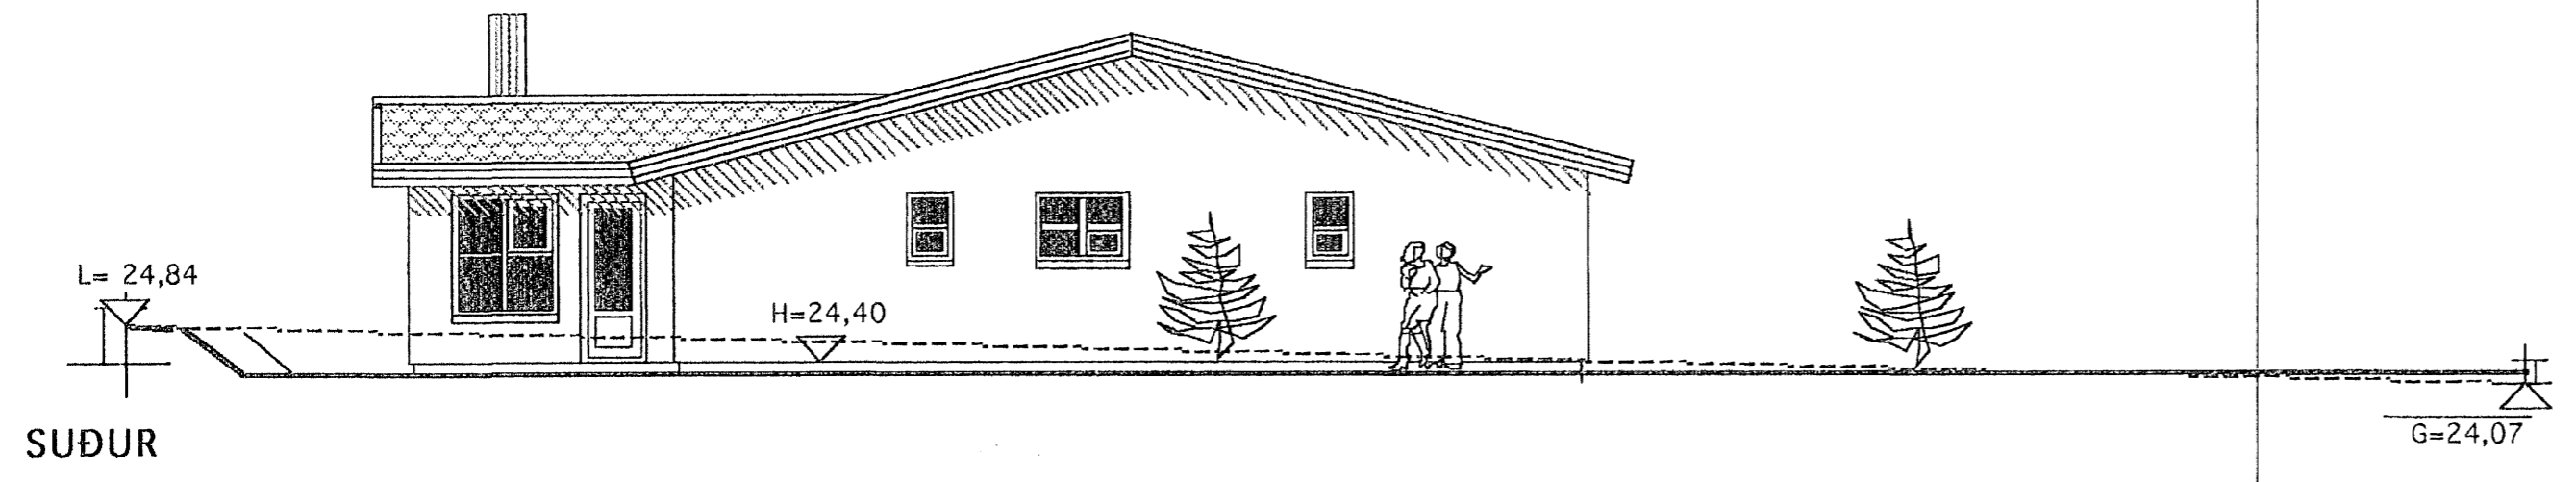
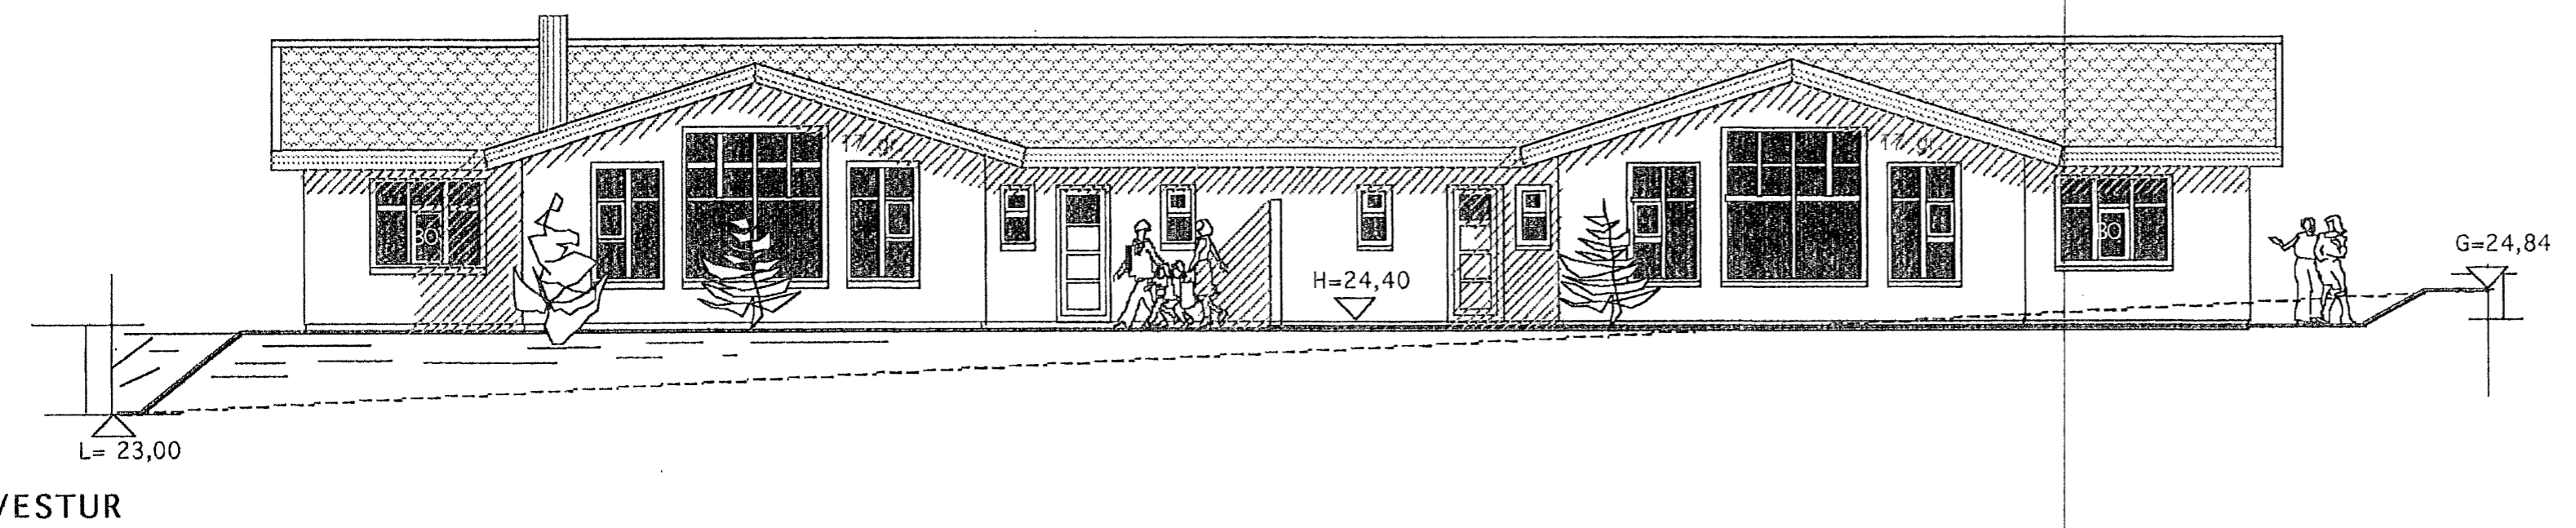
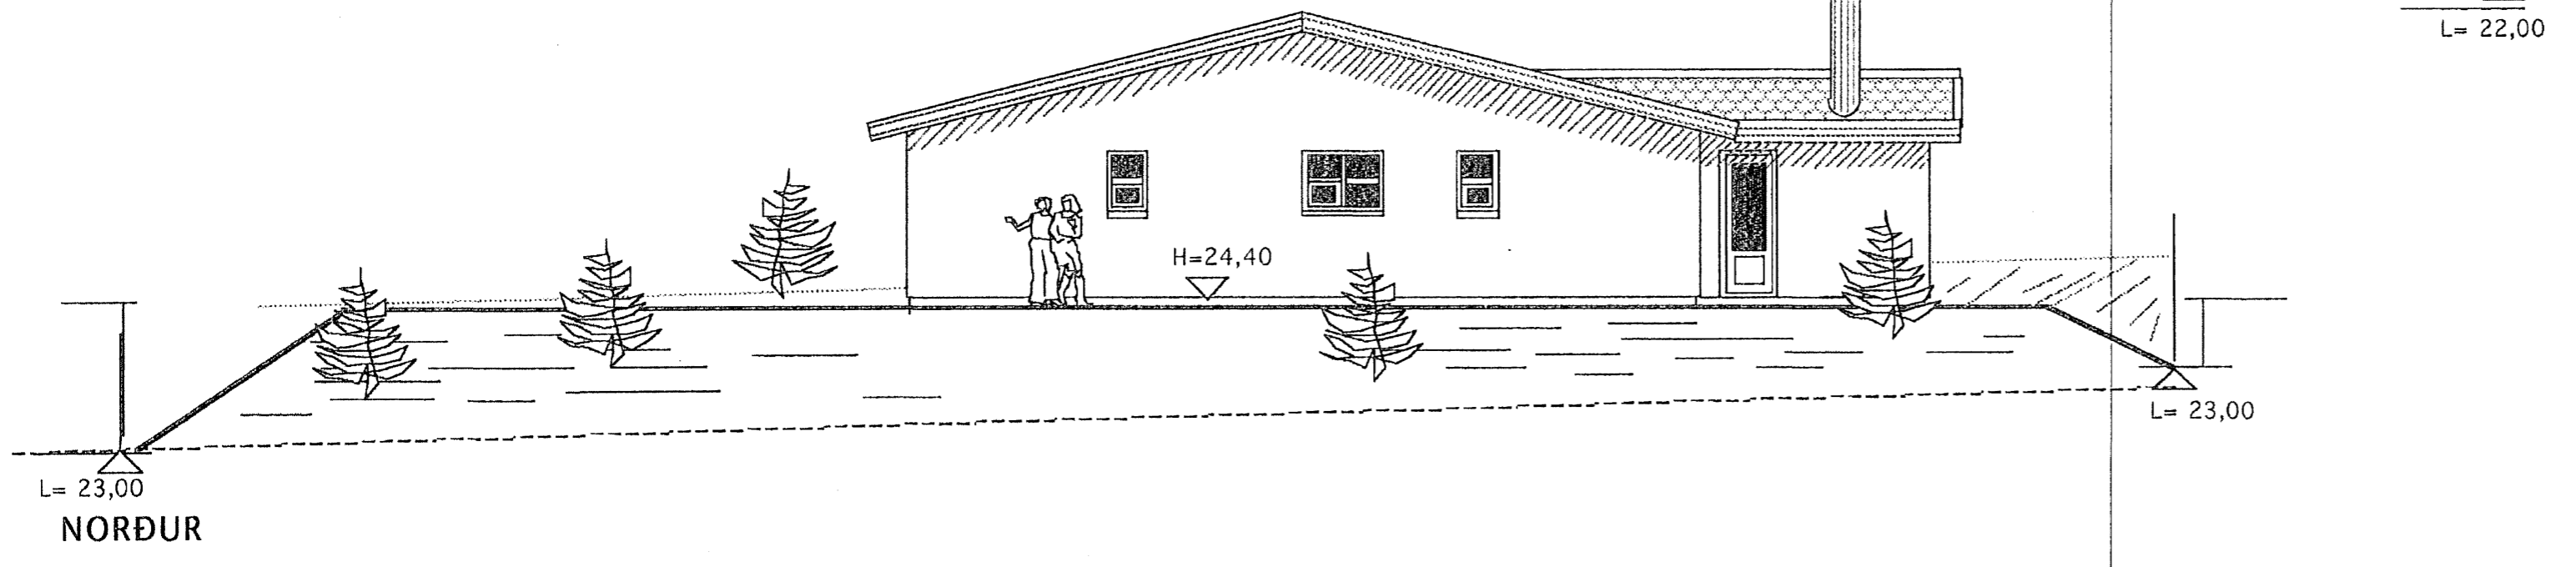



Samþykkt þann  
 11 JUN 2008  
 Byggingaútrúnni í Hafnarfirði  
 F.h. Jón Sigurðsson

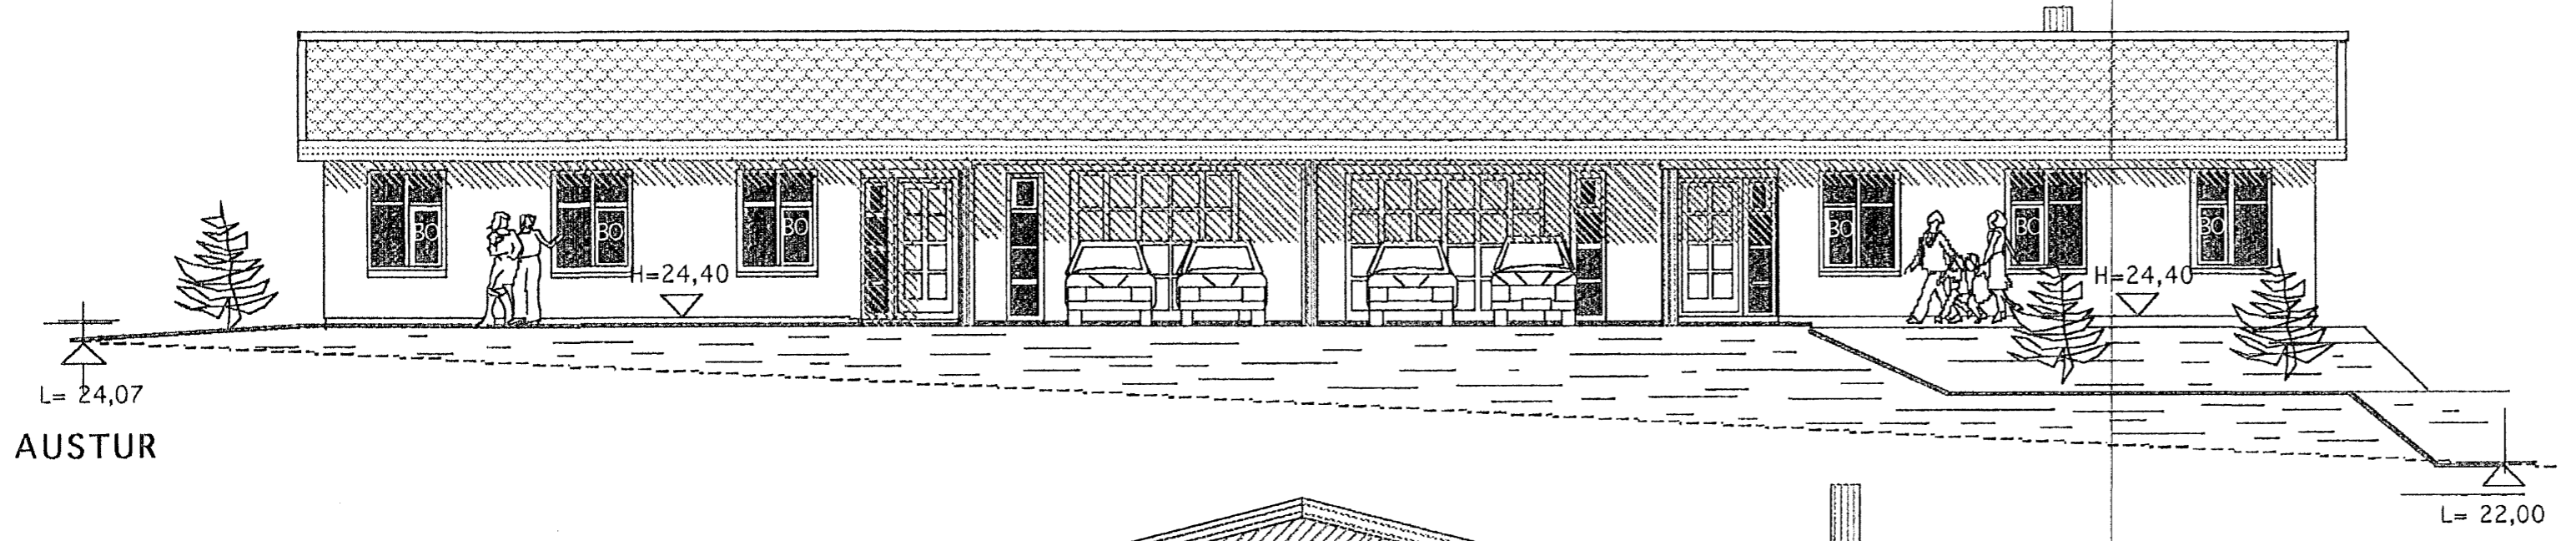

BREYTT 27 mars. 2007  
 Sótt er um leyfi til að hækka gólfkóta um 30 cm

 <b>KVARDI</b>	Verkefni	HAFRAVELLIR 14 -16 HAFNARFIRÐI
	Heiti	ÚTLITSMYNDIR

kvarði	1:100	verk.nr
dags.	25. SEPT. 2006..	dans br 27 mars. 2007.
hönnun	G. G.	teikn nr
teikn	G. G.	<b>A-3</b>

Hringbraut 17 220 Hafnarfirði  
 s. 555-2020 FAX 555-2021  
 Gísli G. Gunnarsson BFÍ kt. 020649-2409  
