



Fr. 2.4.2012
HEILBRIGGISEFTRITIS
HAFNARHARÐAR-
GÖKSWERKSLÍÐIS
Gardatorgi - 210 Gardabæ
K. Jónsson

28.03.2012
AI

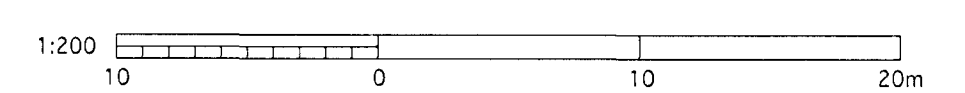

Skýringar:
Legend:

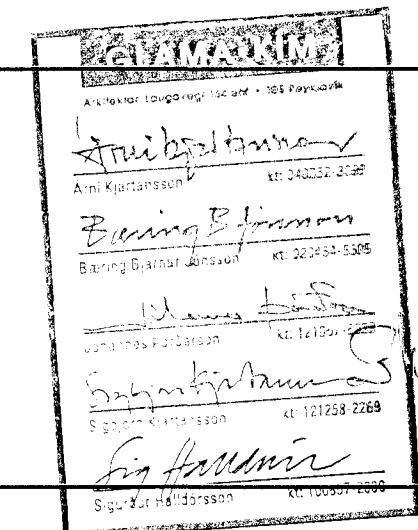

Ug nr	Rev nr	Lýsing	Description	Dagsetning	Date	Han/Tkn	Des/Drw	Yfir	Chk	Nokk	harm	Suppl	Ral	ISAL	Ral
A		As Built		03.03.2012		SK		SK							

This drawing is the property of Rio Tinto Alcan Iceland Ltd. and handed out for personal use only. It may neither be copied nor made available to others without permission of Rio Tinto Alcan Iceland Ltd. The receiver is liable for any misuse.



Dagsetning / Date	30.09.2008	Hannað / Designed	SK	Tekin / Drawn	EHF/ÓMSK
Verktaki / Supplier	GLAMA-KIM	Tekin nr. verktaka / Supplier drw. no.	A01.03	Samþykkt / Approved	Yfir / Chkd SK

ROFABYGGING OG TENGIVIRKI
GRUNNMYND JARÐHÆÐAR

ADALUPPRÁTTUR
Architectural Building Application

RioTinto Alcan

Flokkur nr.:	Bláð nr.:	Næsta bl. nr.:
Kostn. nr. - Cno. / Bún. nr. - Eq. no.	4011	01188
AKS	UB01	
ISAL Teikn. nr. / ISAL / Drw. no. of ISAL	250387	A