



**1 ÚTLIT - VESTUR**  
m.kv. 1:200

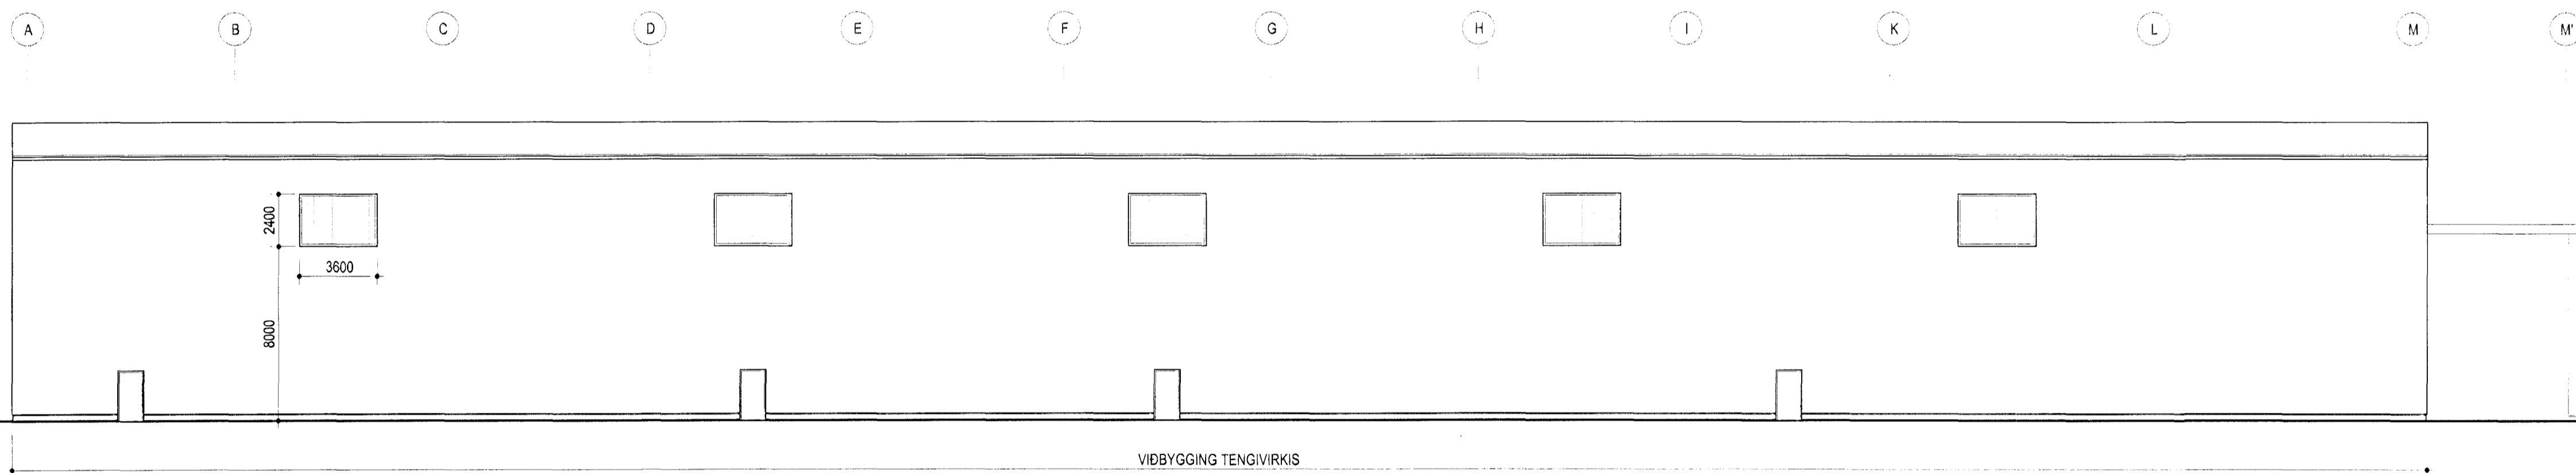

**2 ÚTLIT - AUSTUR**  
m.kv. 1:200

28.03.2012  
[Signature]

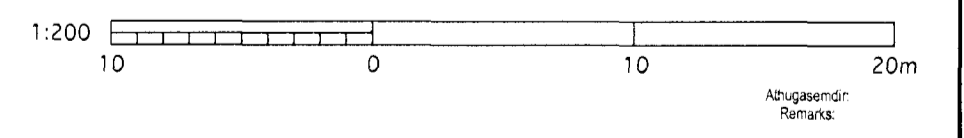

Skýringar:  
Legend:

[Signatures and stamps of architects and engineers]

Útg nr / Rev no	As Built	Lýsing / Description	Dagsetning / Date	Han/TKn / Des/Dwn	Yfir / Ckd	Nok heim / Suppl Rel	Nok heim / ISAL Rel
A	As Built		03.03.2012	SK	SK		

This drawing is the property of Rio Tinto Alcan Iceland Ltd. and handed out for personal use only. It may neither be copied nor made available to others without permission of Rio Tinto Alcan Iceland Ltd. The receiver is liable for any misuse.

Stærð: A1 Mkv.: 1:200  
Formati: Scale:

Dimensions without tolerances according to ISO 2768-1 medium.



Dagsetning / Date	30.09.2008
Hannað / Designed	SK
Teikn / Drawn	EHF/ÖMISK
Vertakni / Supplier	GLAMA-KIM
Teikn nr/vertakni / Supplier drw.no	A01.04
Samþykkt / Approved	Yfir / Chkd SK
Hluti af / Part of:	

ROFABYGGING OG TENGIVIRKI  
ÚTLIT

ADALUPPDRÁTTUR  
Architectural Building Application

**Rio Tinto Alcan**

Flokkur nr.:	Blað nr.:	Næsta bl.nr.:
	4011	01188
Kostn.nr.-Cno. / Búnr.-Eq no	AKS	UB01
Teikn nr. ISAL / Drw.no. of ISAL	250388	A
Breyt./Rev		