




1 ÚTLIT - NORDUR
 m.kv. 1:200

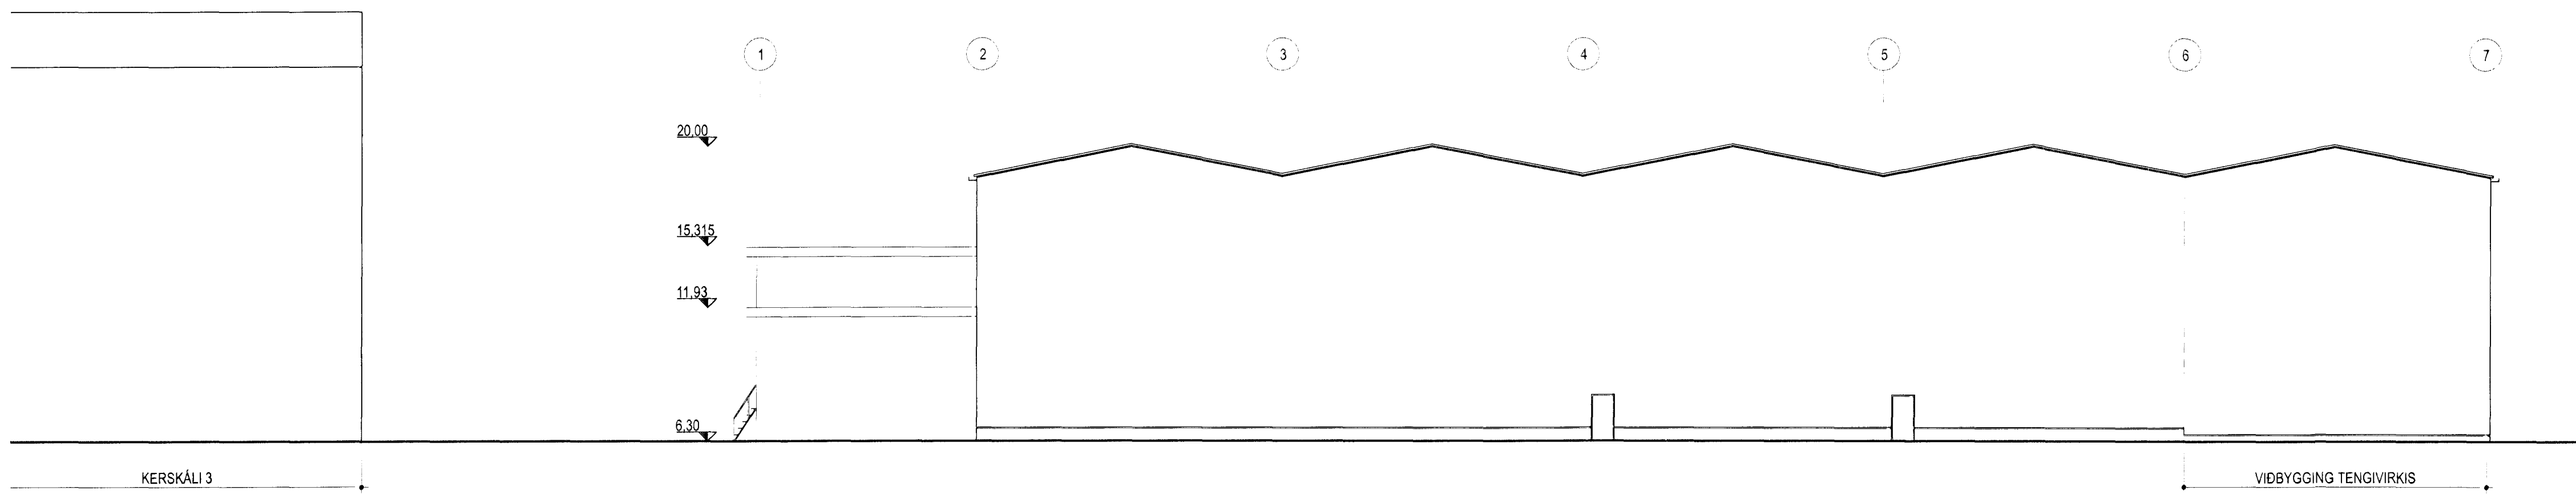

2 ÚTLIT - SUÐUR
 m.kv. 1:200

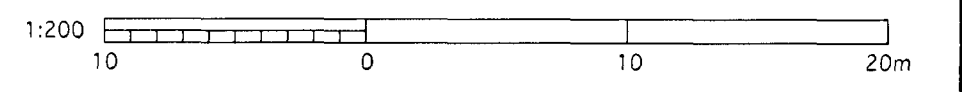

Skýringar:
 Legend:

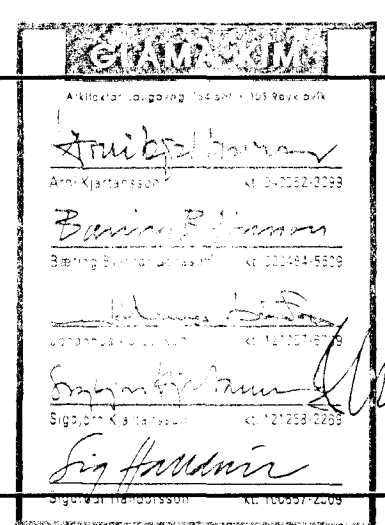

Ulg nr	As Built		03.03.2012	SK	SK	Nök heim	Nök heim
Rev no		Lýsing	Dagsetning	Har/Tkn	Yfir	Suppl Rnr	ISAL Rnr
		Description	Date	Des/Dw	Ckd	Suppl Rnr	ISAL Rnr

This drawing is the property of Rio Tinto Alcan Iceland Ltd. and handed out for personal use only. It may neither be copied nor made available to others without permission of Rio Tinto Alcan Iceland Ltd. The receiver is liable for any misuse.



Dagsetning / Date	30.09.2008
Hannað / Designed	SK
Teikn / Drawn	EHF/ÓMSK
Verttáki / Supplier	GLÁMA-KÍM
Teikn nr/verktaka / Supplier drw.no.	A01.05
Samþykkt / Approved	Yfir / Chkd SK
Hiuti af / Part of:	

ROFABYGGING OG TENGIVIRKI
 ÚTLIT
 ADALUPPDRÁTTUR
 Architectural Building Application

Rio Tinto Alcan

Flokkur nr.:	Bláð nr.:	Næsta bl nr.:
	4011	01188
Kostn.nr.-Ccon. / Bún.nr.-Eq.no	AKS	
	UB01	
ISAL Teikn.nr. ISAL-IDrwno. of ISAL	250389	Breyti/Rev
		A