


1 SNEIDING A-A  
 m.kv. 1:200

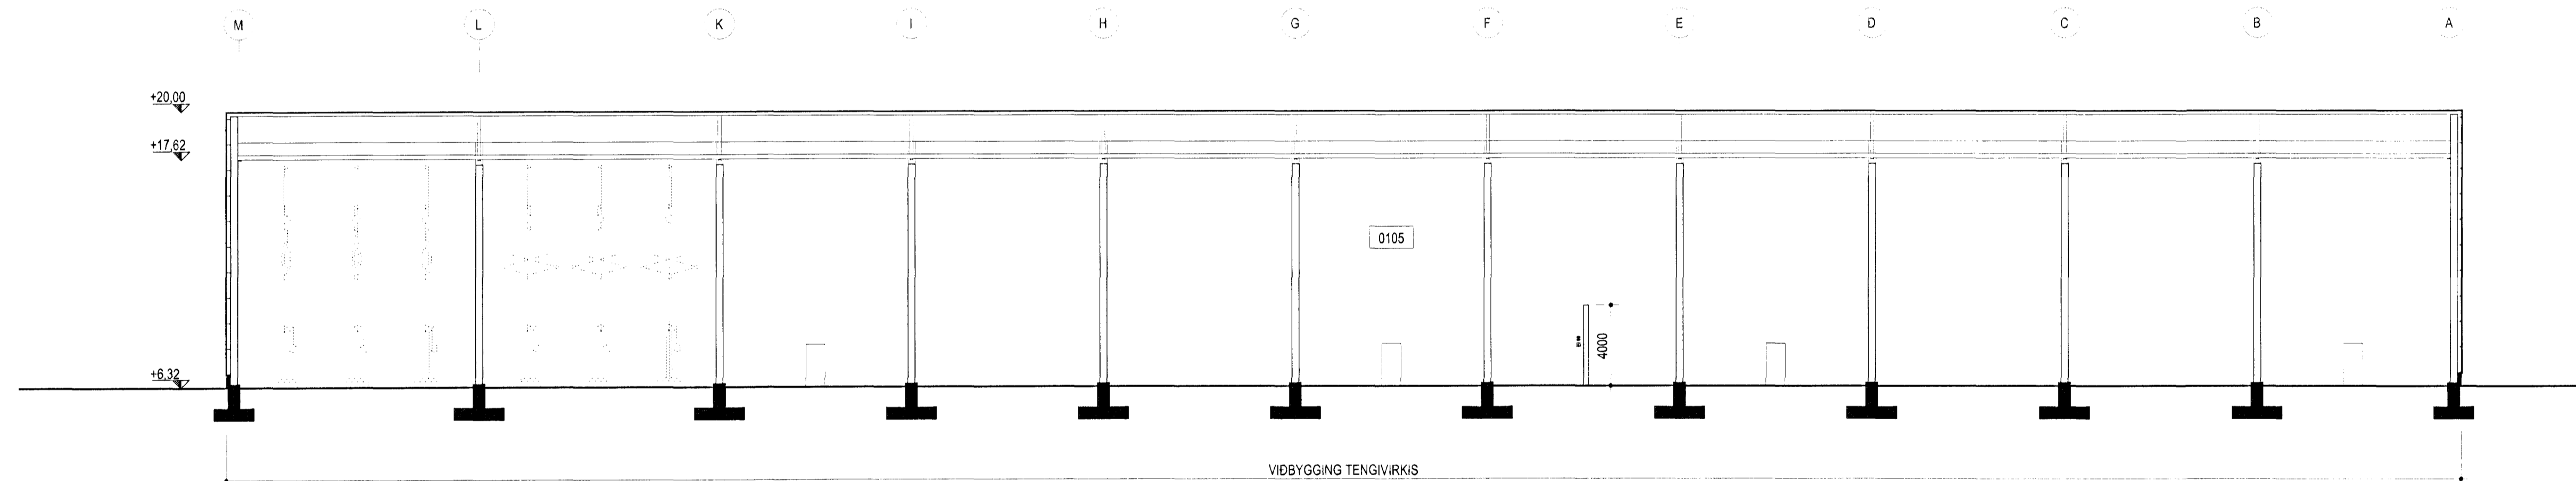

2 SNEIDING B-B  
 m.kv. 1:200

28.03.2012



Skýringar:  
 Legend:

*Handwritten signatures and stamps:*  
 Sigurður Steinar Jónsson  
 28.03.2012

Utg nr	Rev no	Lysing	Description	Dagsetning	Date	Hau/Tkn	Des/Drw	Yfir	Chk	Nok heim	Suppl Rel	Nok heim	ISAL Rel
A		As Built		03.03.2012		SK	SK						

This drawing is the property of Rio Tinto Alcan Iceland Ltd. and handed out for personal use only. It may neither be copied nor made available to others without permission of Rio Tinto Alcan Iceland Ltd. The receiver is liable for any misuse.



Dagsetning / Date	30.09.2008	Hannað / Designed	SK	Teikn / Drawn	EHF/ÓMSK
Verktaki / Supplier	GLÁMA-KÍM	Teikn nr./verktaka / Supplier drw.no	A01.06	Samþykkt / Approved	Yfir / Chkd SK

ROFABYGGING OG TENGIVIRKI SNEIDINGAR		Flokkur nr.:	Blað nr.:	Næsta bl. nr.:
		Kostn.nr.-Ccon. / Bún.nr.-Eq.no	4011	01188
Teg.teikningar / Dwg.type:		ADALUPPRÁTTUR	AKS	UB01
Architectural: Building Application		Teikn.nr. ISAL / Dnw.no. of ISAL	250390	Breyt./Rev A

**RioTinto Alcan**

ISAL  
 Alcan Iceland Ltd  
 Stofnunin  
 IS-222 Hafnarfjarður  
 Ísland

ISAL Yfirfærð og skráð, dags / ISAL Checked, date ISAL Samþykkt, dags / ISAL Approval, date